




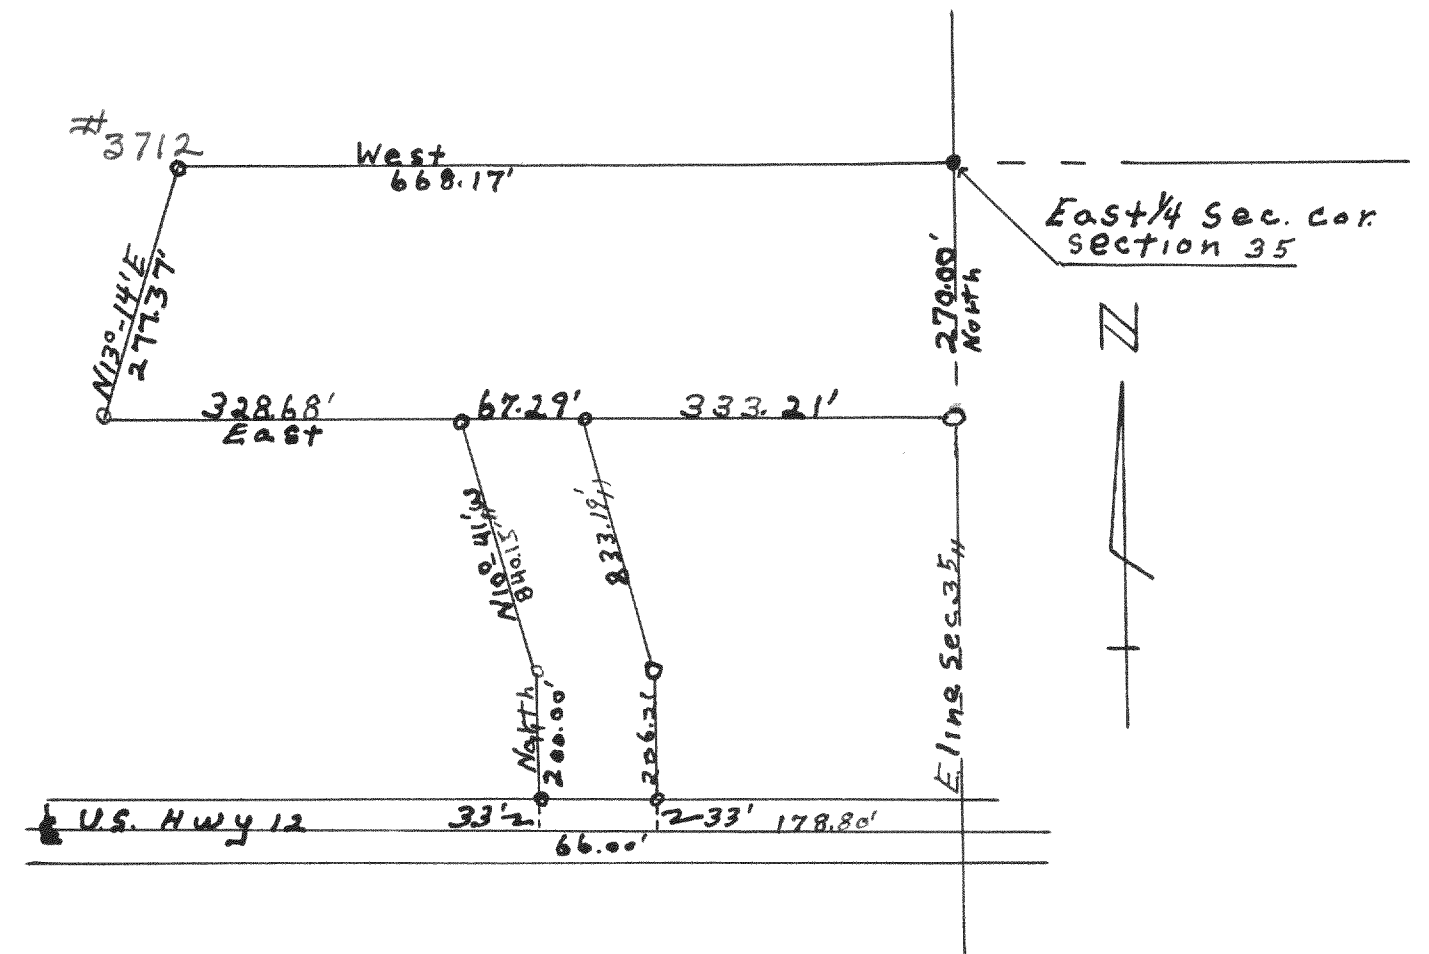



Plat of Survey of A Parcel of land in the S.E. 1/4 of Sec. 35, T1N, R18E, Village of Genoa city, Walworth County Wisconsin Dec. 1959 Lloyd L. Jensen County Surveyor

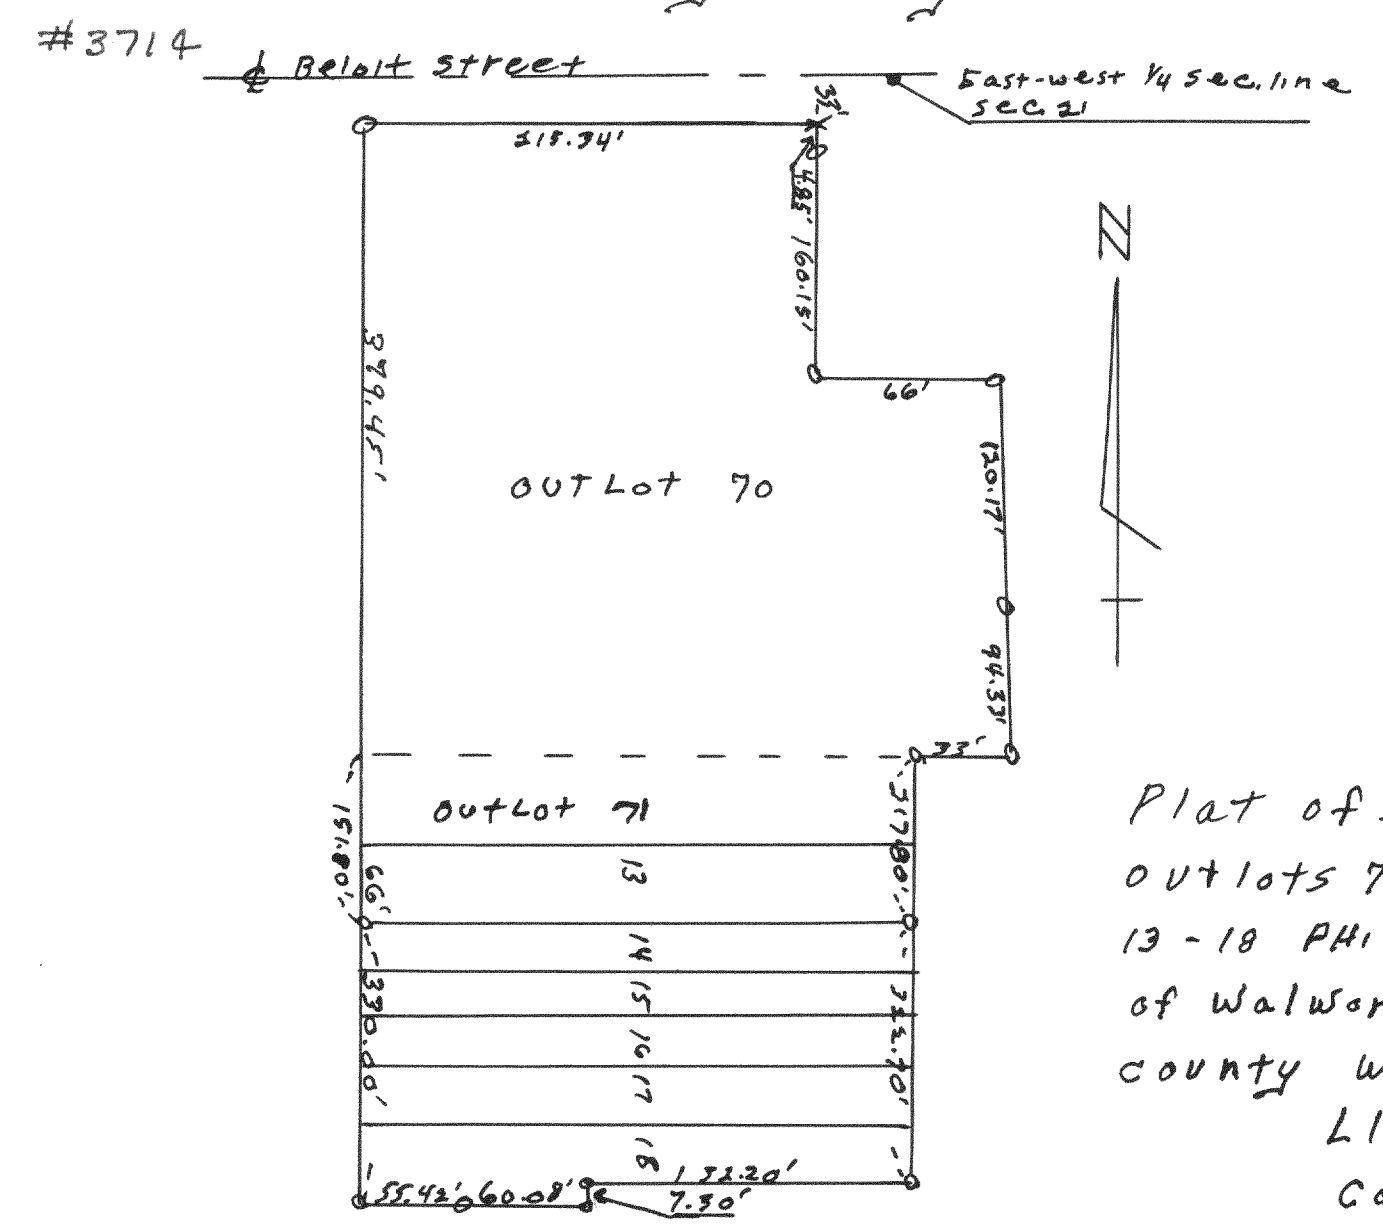

Plat of Survey of Outlots 70 + 71, and lots 13 - 18 Phillips Add., Village of Walworth, Walworth County Wisconsin Jan. 1959 Lloyd L. Jensen County Surveyor

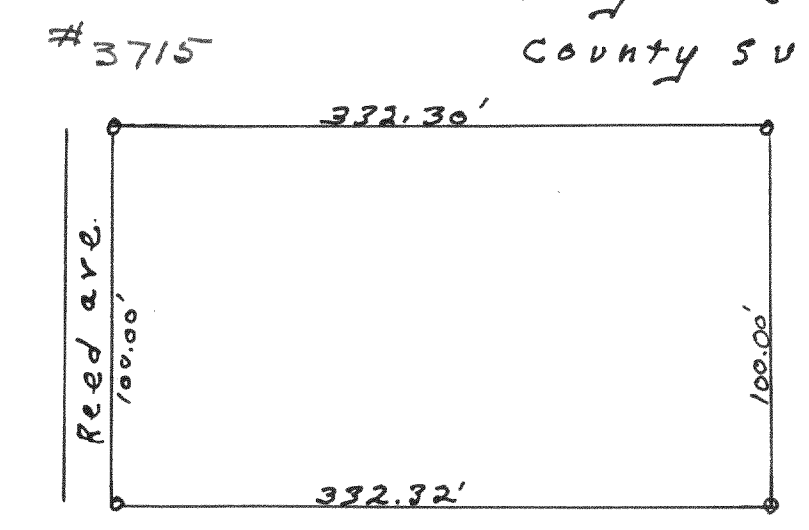

Plat of Survey of Part of Outlot 218 of the Village of Walworth, Walworth Co. Wisconsin Aug. 1959 Lloyd L. Jensen County Surveyor

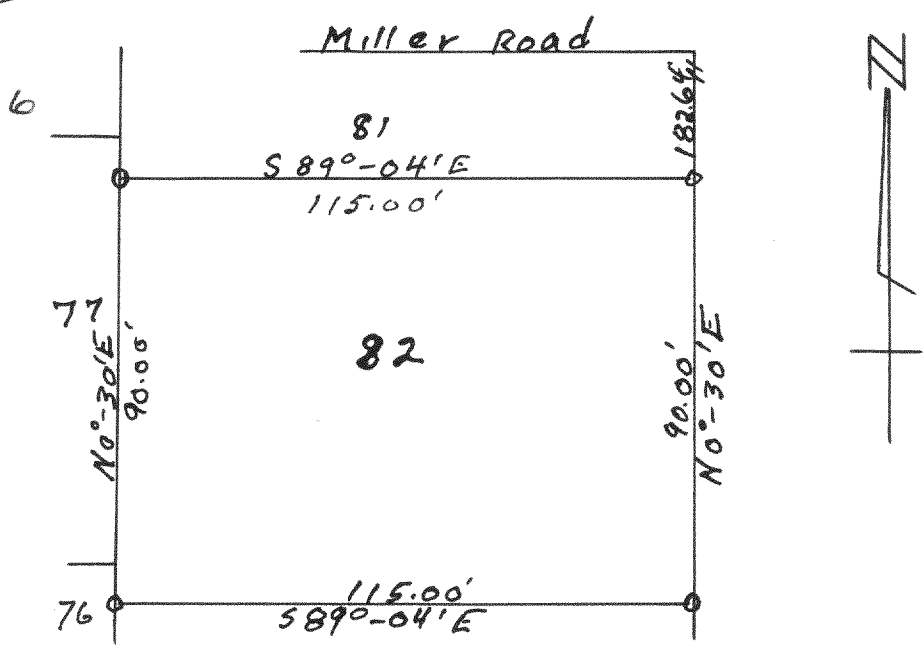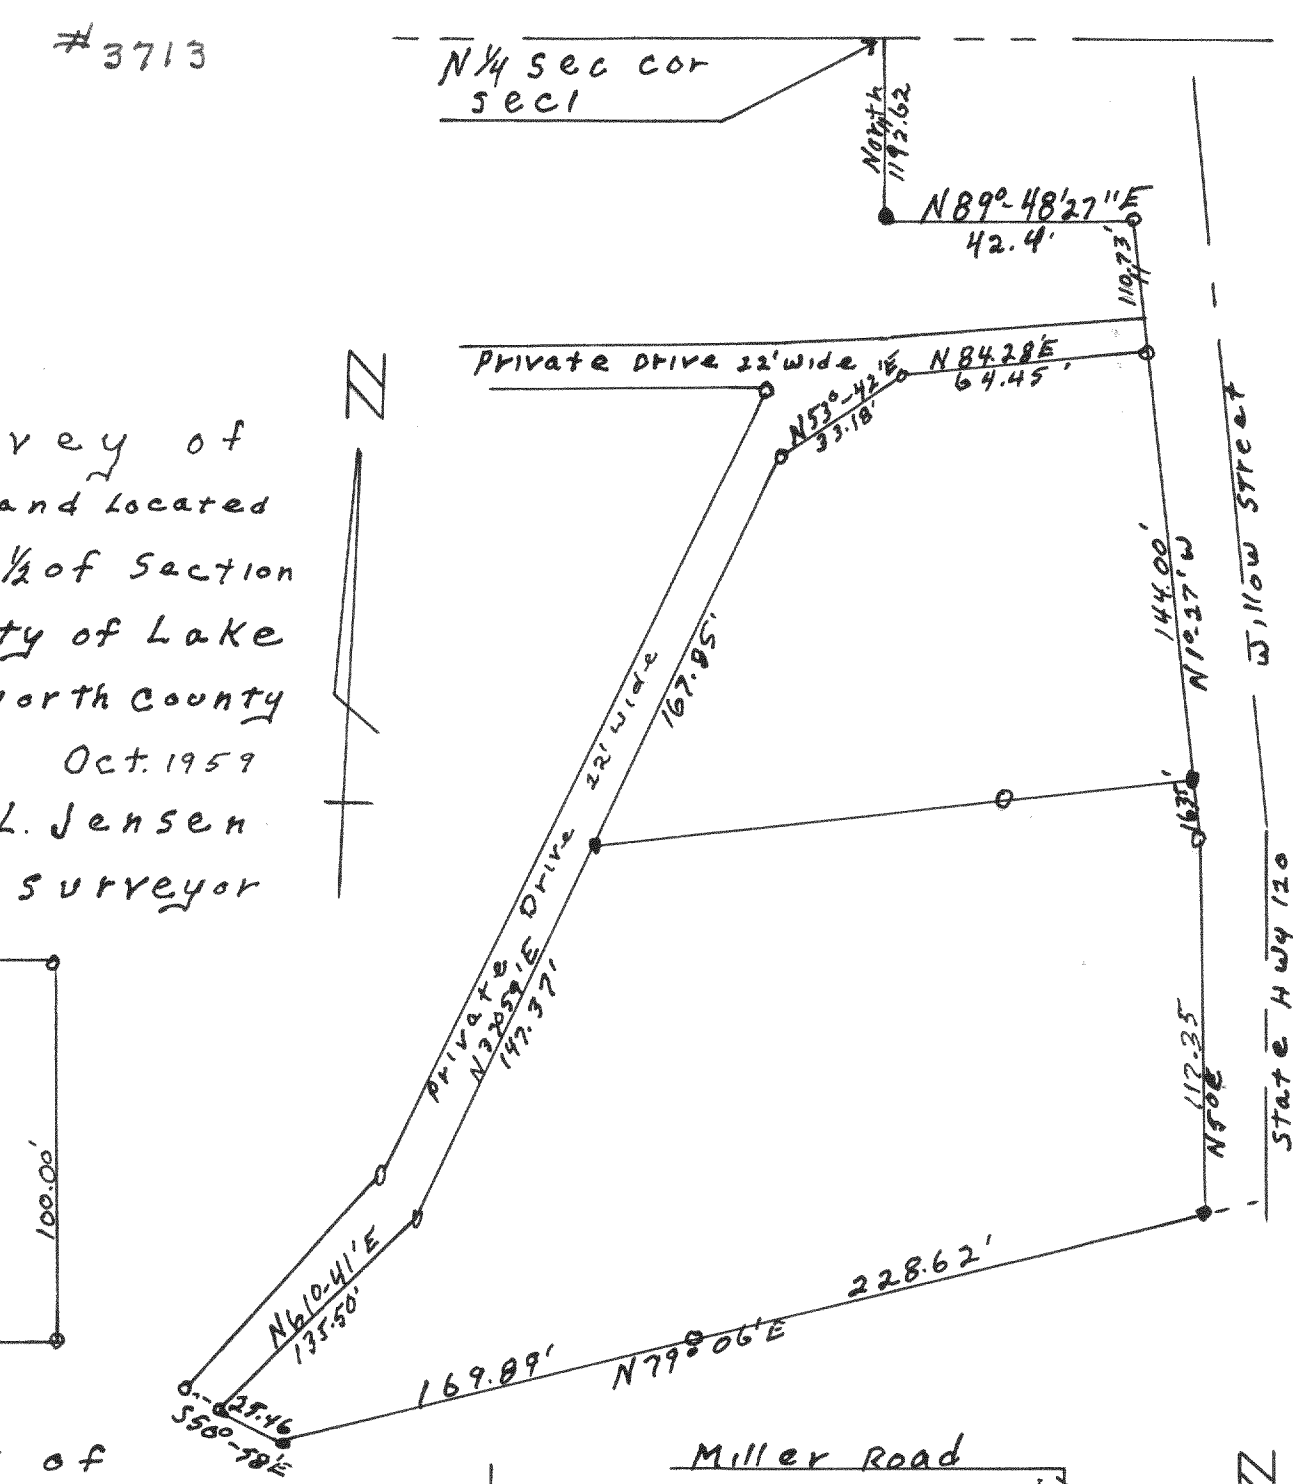

Plat of Survey of Lot 82, Sturwood Add. No. 3, City of Lake Geneva, Walworth County Wisconsin March 1959 Lloyd L. Jensen County Surveyor