



2700

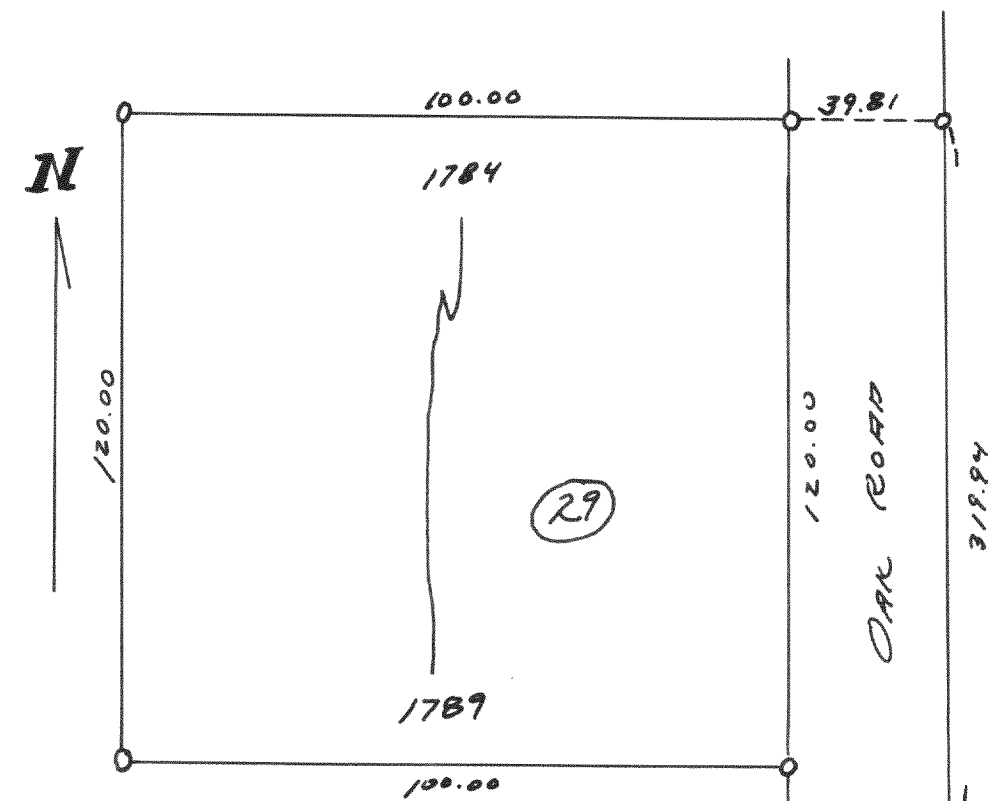

Plat of Survey of Lots 1784-1789 (INCL)
Block 29 Lake Como Beach T2N R17E
April, 1953

LLJ
CS


2703

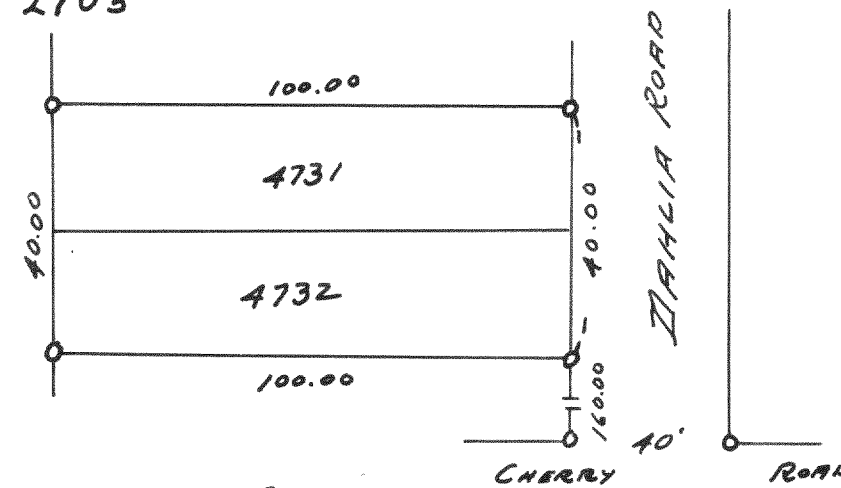

Plat of Survey of
Lots 4731 & 4732 4th Map
Lake Como Beach T2N R17E
May 1953

LLJ
CS


2701

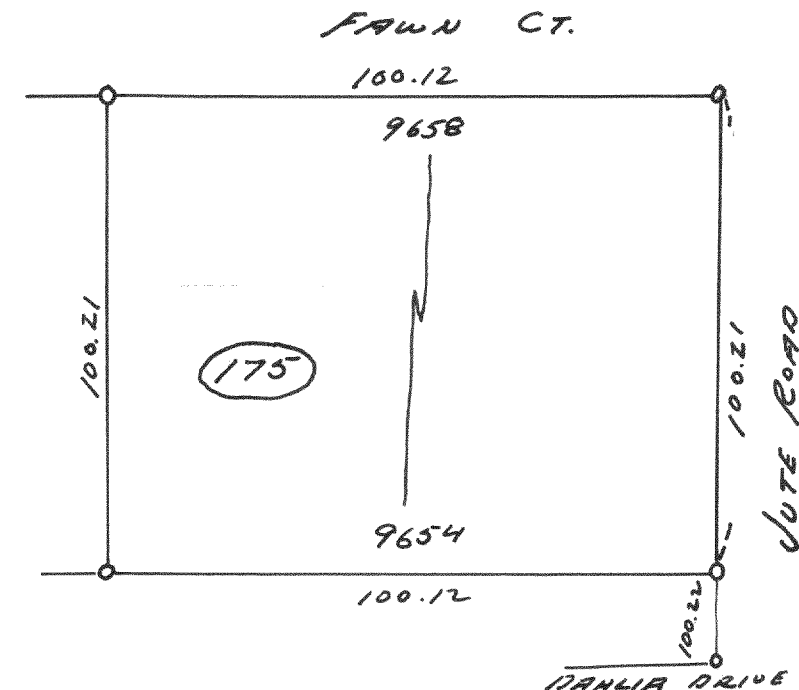

Plat of Survey of Lots 9654-9658 (INCL)
Block 175 4th Map Lake Como Beach
T2N R17E
May 23, 1953

LLJ
CS


2704

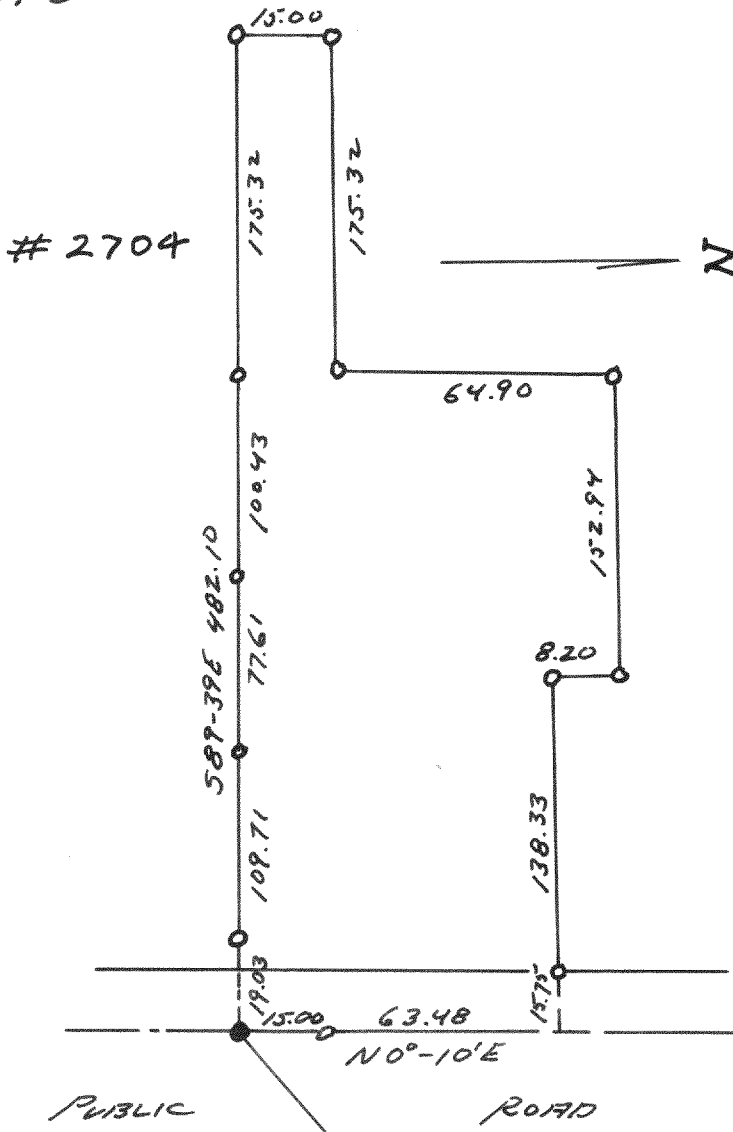

Plat of Survey of Land located
in SE 1/4 Section 33 T2N R17E
May 1953

LLJ
CS

2702

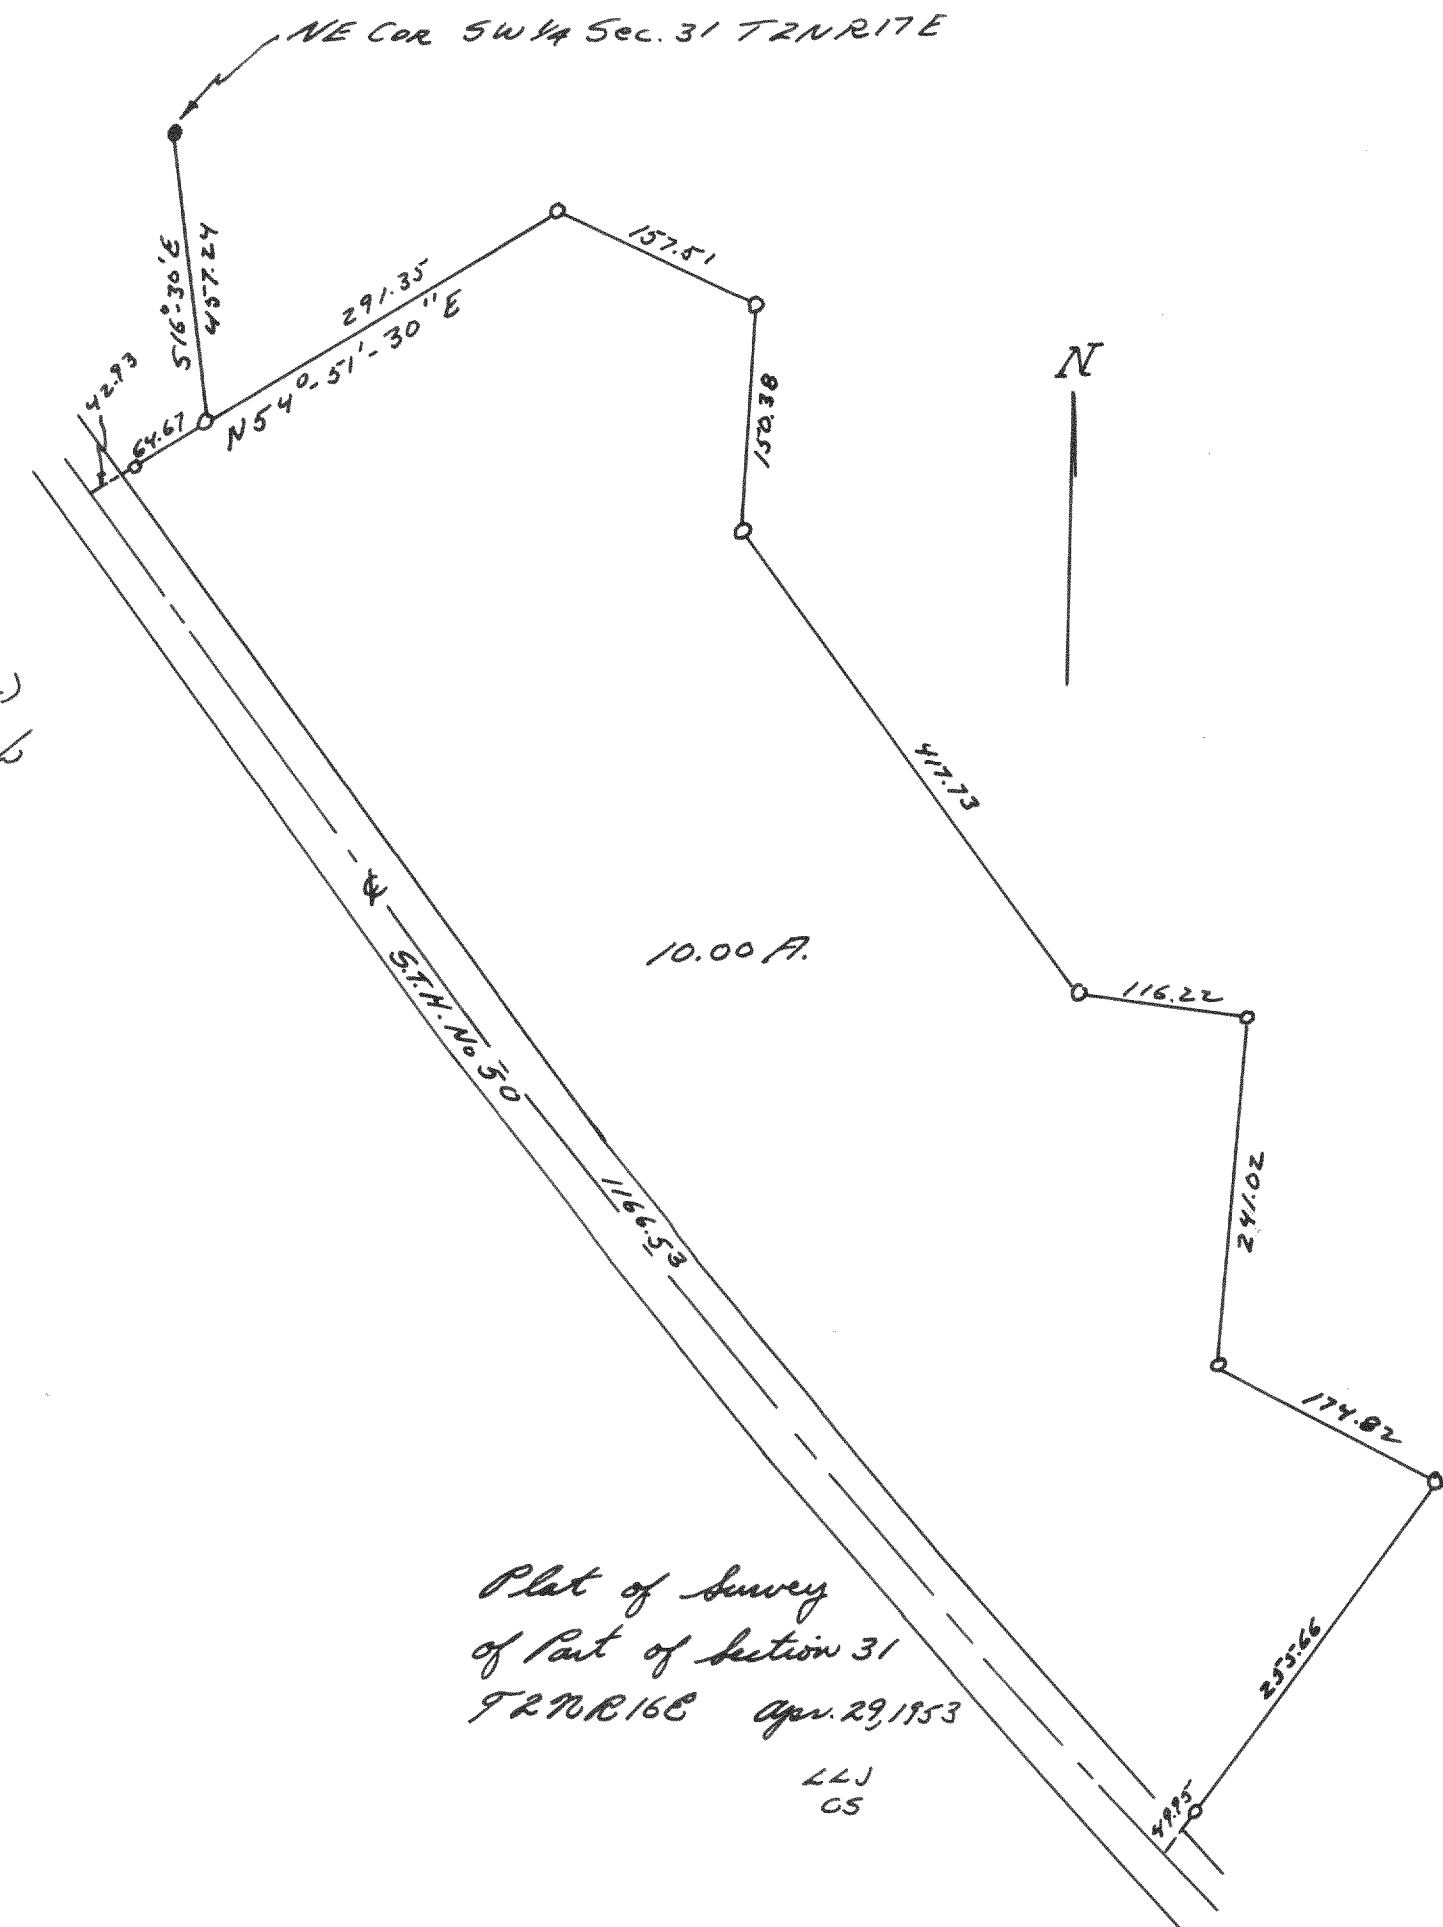

Plat of Survey
of Part of Section 31
T2N R16E Apr. 29, 1953

LLJ
CS