




3721

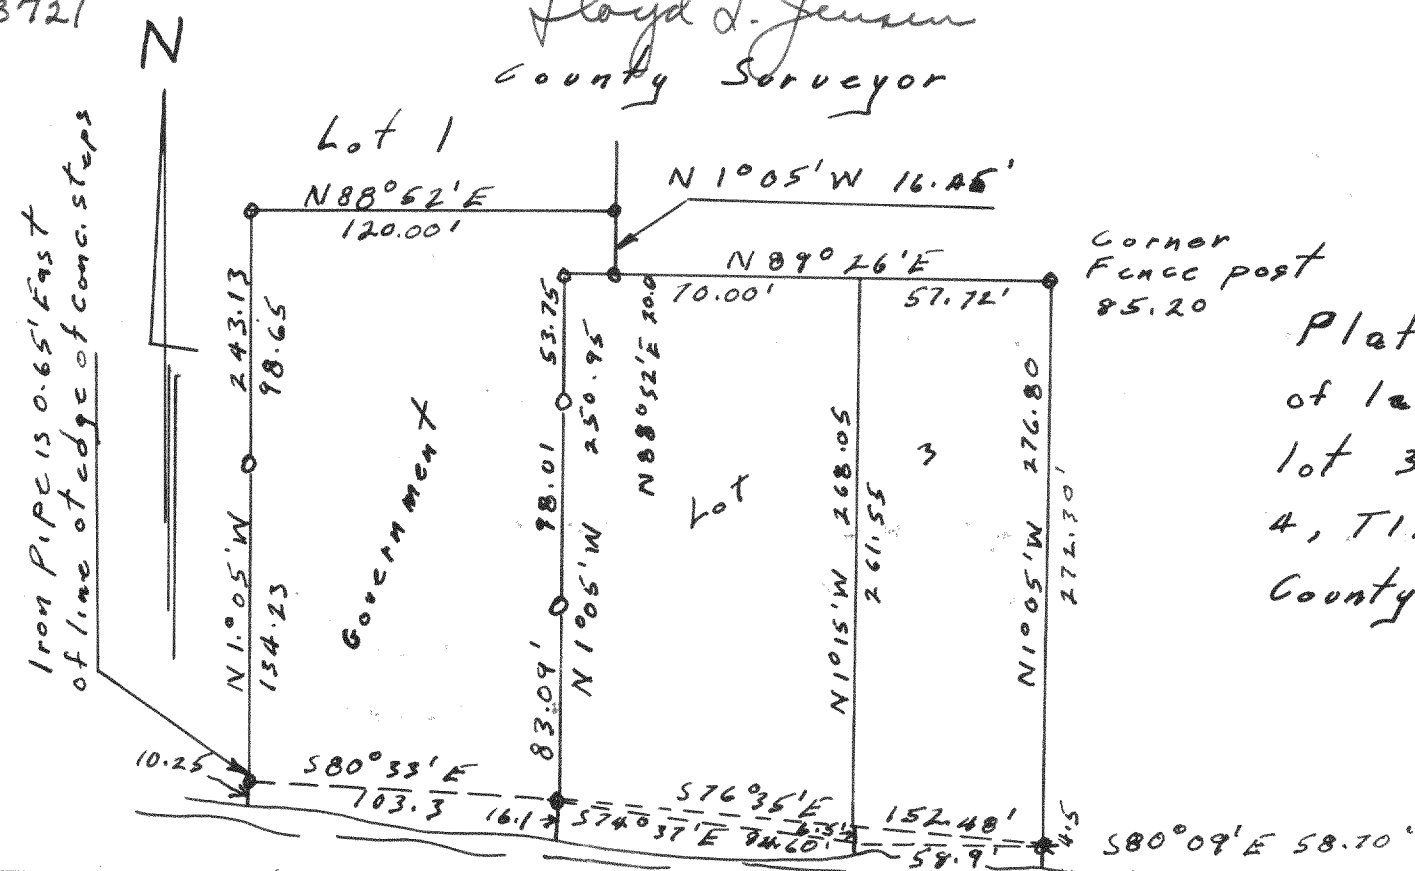


Plat of survey of a parcel
of land located in Government
lot 3, in the W 1/2 of Section
4, T1N, R17E Wabworth
County Wisconsin May 1961
Lloyd L. Jensen
County Surveyor

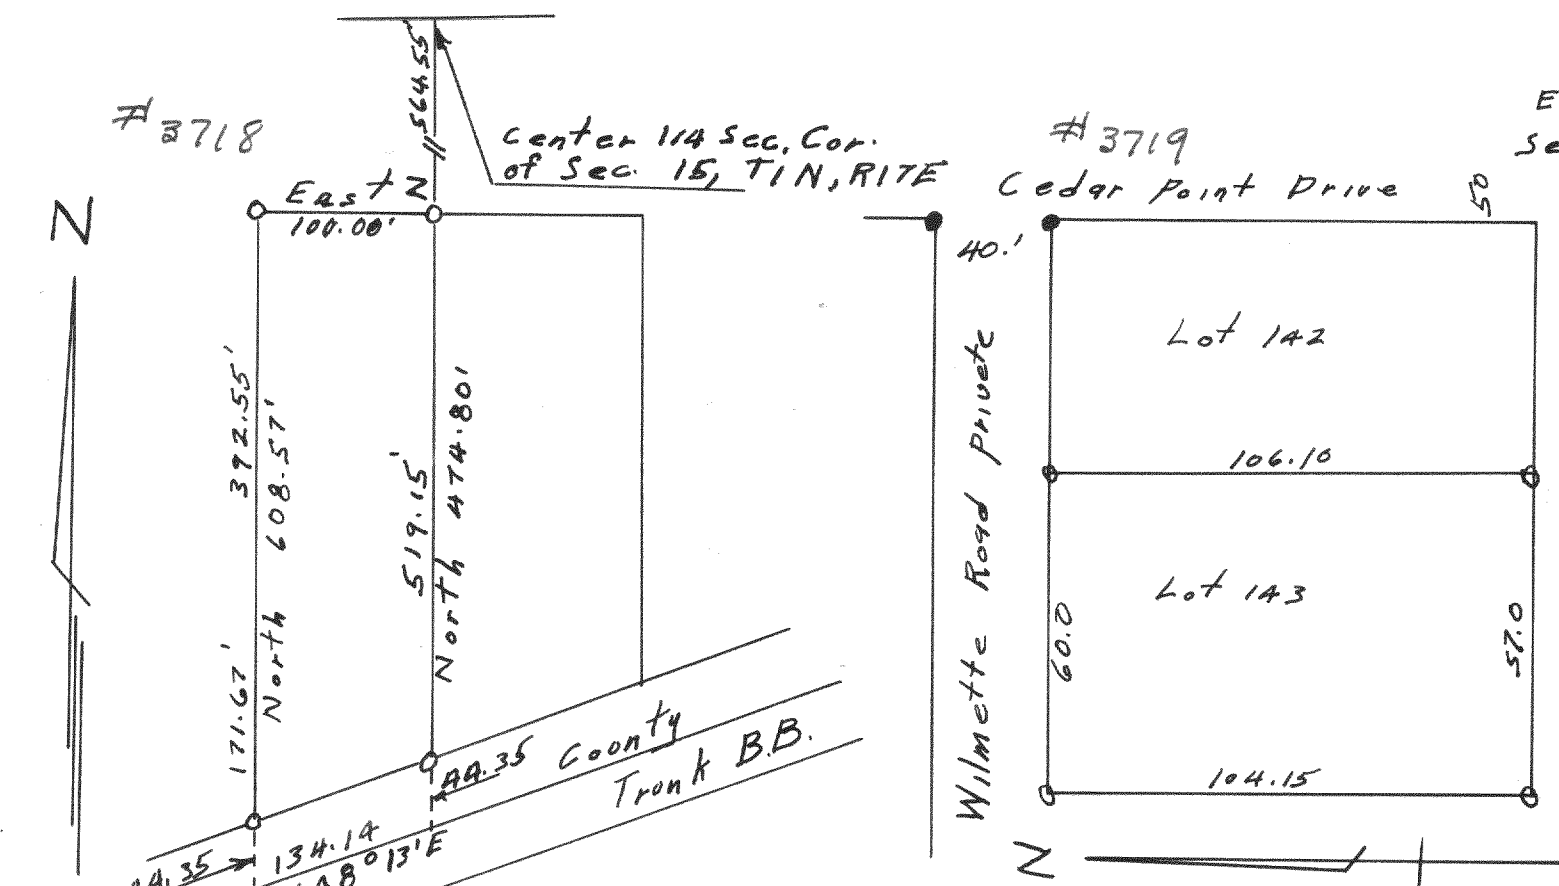


Plot of survey of a parcel of land located in the NE 1/4 of the SW 1/4 of Section 15, T1N, R1E Walworth County Wisconsin April 1961 Lloyd J. Jensen County Surveyor	Plot of survey of Lot 143 of the second Add. To Cedar point park Williams Bay, Walworth County Wisconsin May 1959 Lloyd L. Jensen County Surveyor
---	---

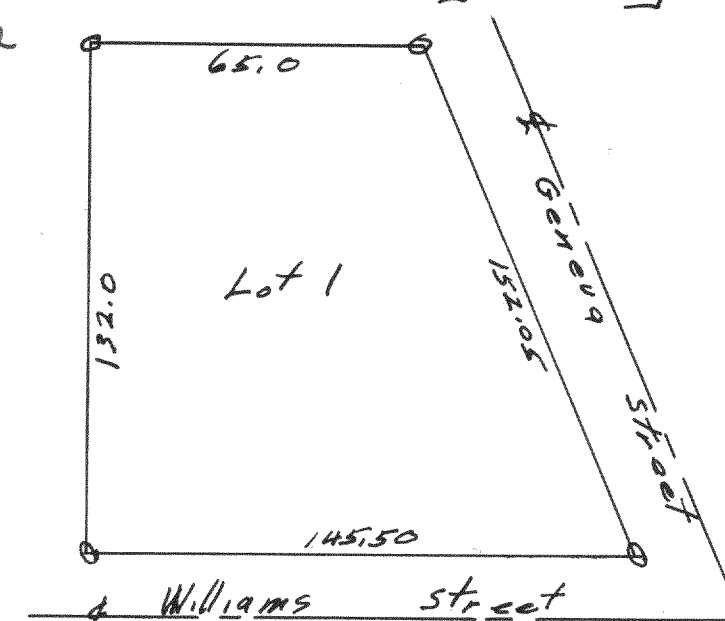

Plat of survey of Lot 1 Block
5 of original plat Village of
Williams Bay, Walworth County
Wisconsin Lloyd L. Jensen
Mar 1969 County Surveyor

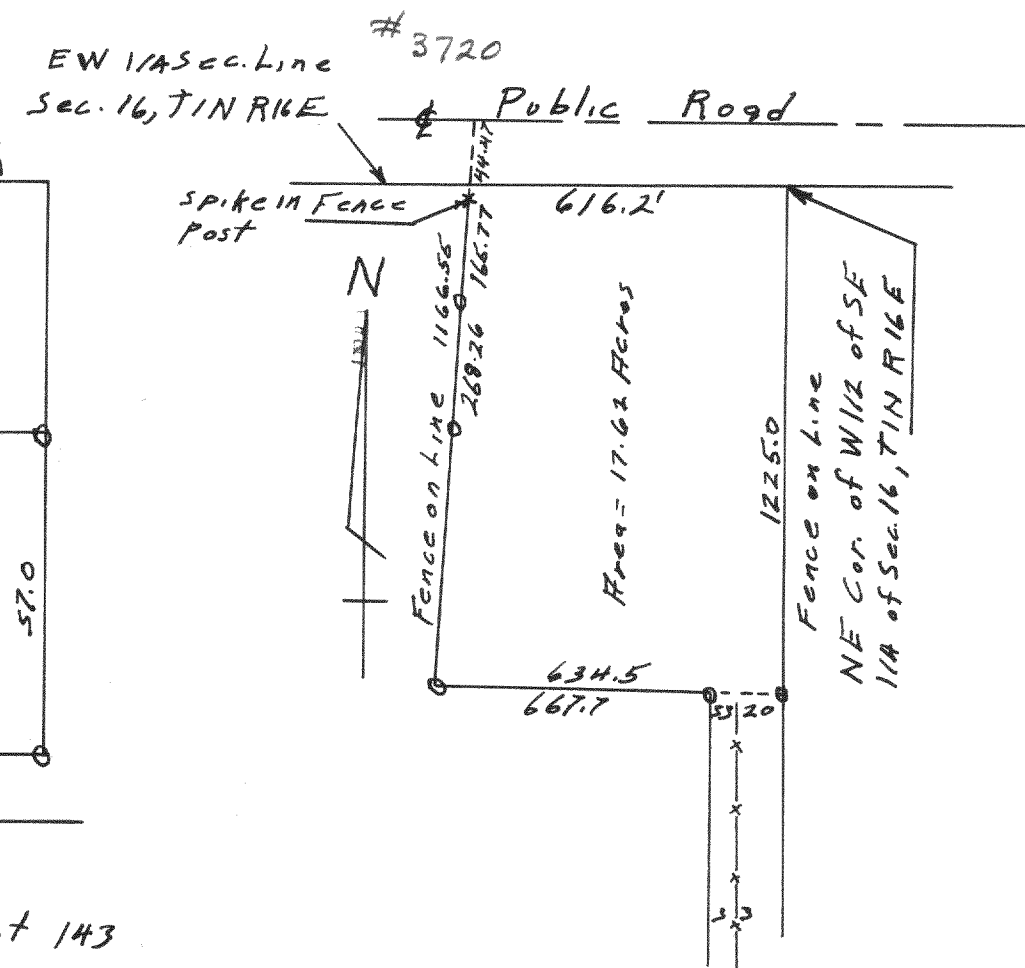

Plat of survey of A
Parcel of land located
in the NE 1/4 of Sec. 21 and
the W 1/2 of the SE 1/4 of
Sec 16, T 1 N R 16 E Walworth
County Wisconsin Lloyd L. Jensen
Jan 1959 County Surveyor

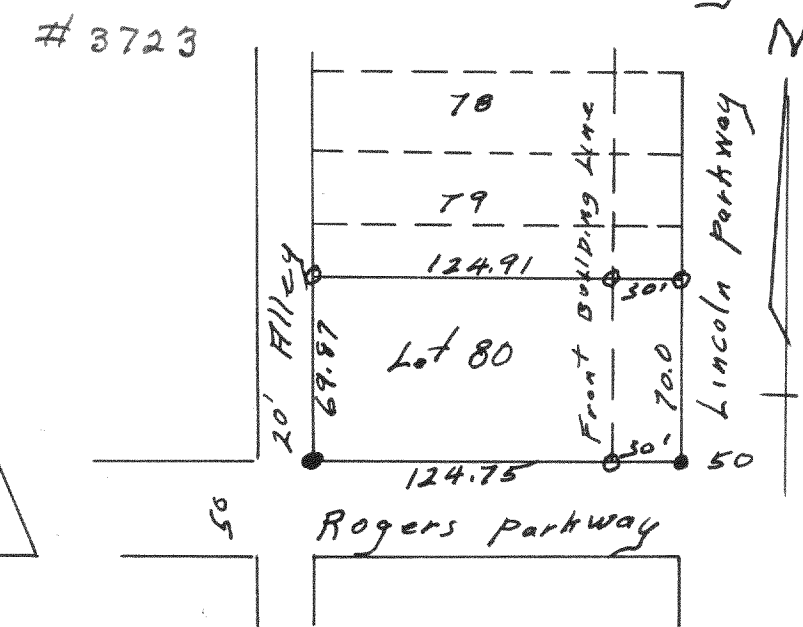

Plat of survey of Lot 80
of the original plat of
Cedar Point Park Williams
Bay, Walworth County
Wisconsin Lloyd L. Jensen
May 1959 County Surveyor