




#3729

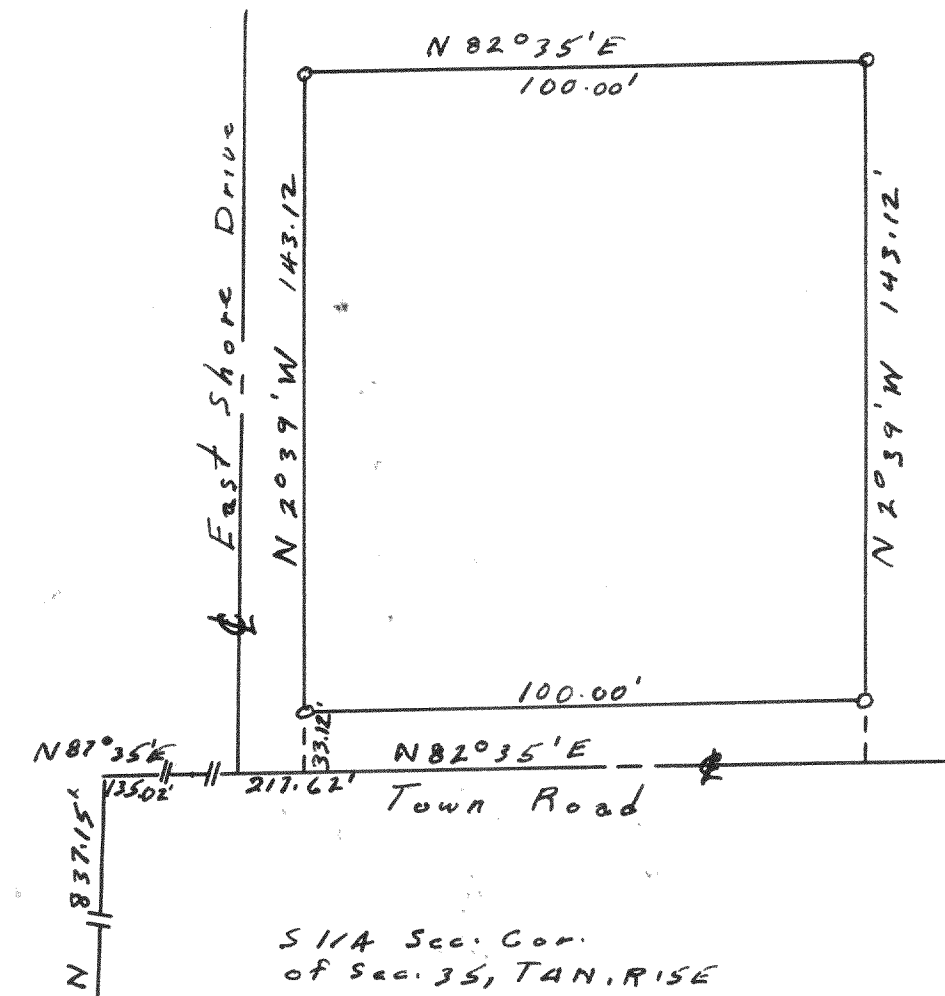

Plat of survey of a parcel of land located in the W 1/2 of the SE 1/4 of Section 35, T4N, R17E Walworth County Wisconsin May 1961  
Floyd L Jensen  
County Surveyor  
#3732

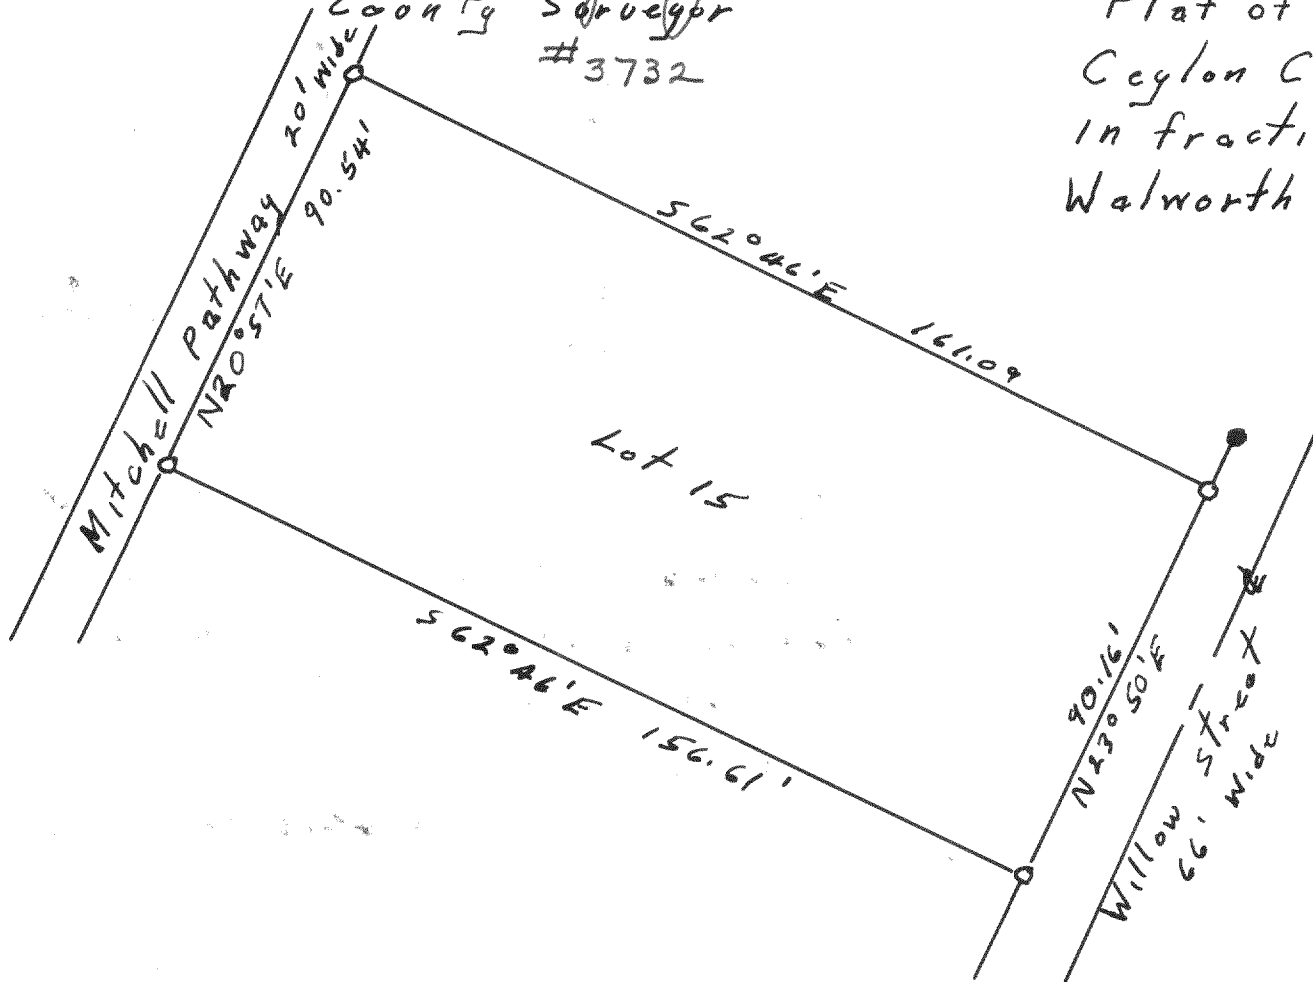

#3730

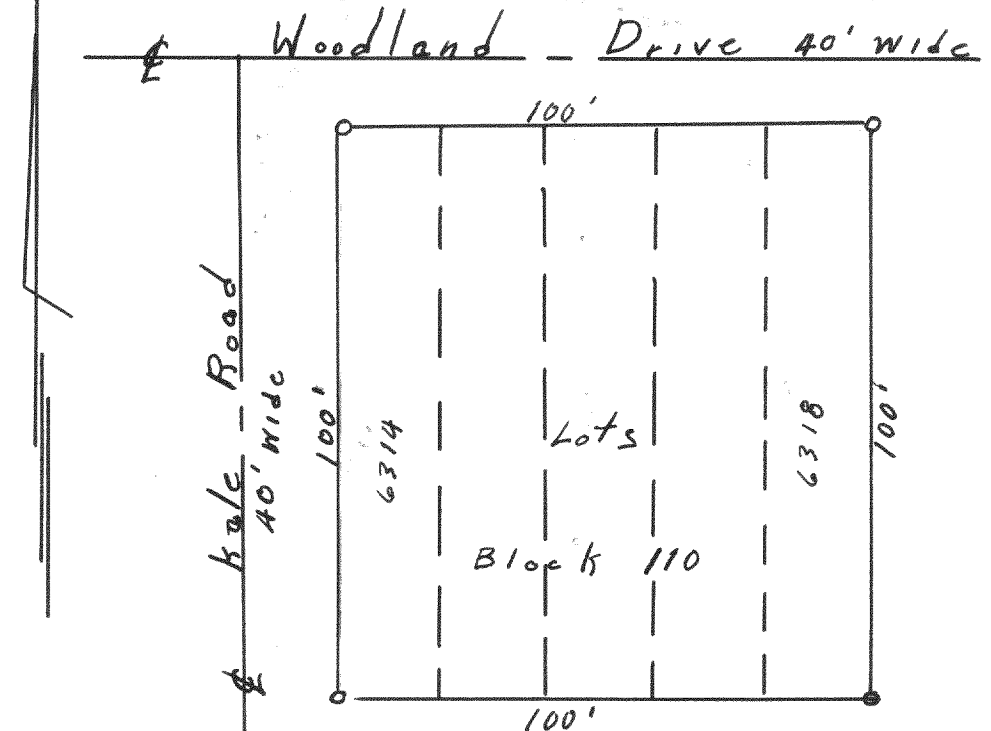

Plat of survey of lots 6314 to 6318, block 110, Lake Como Beach, located in Section 28, T2N, R17E Walworth County Wisconsin  
Floyd L Jensen  
County Surveyor

Plat of survey of lot 15, Ceylon Court Estates, located in fractional Section 1, T1N, R17E Walworth County Wisconsin  
Floyd L Jensen  
County Surveyor

N

#3731

N



Plat of survey of lot 6 block 1, Trinke Estates, located in section 10, T1N, R17E Walworth County Wisconsin  
Floyd L Jensen  
County Surveyor

1

