



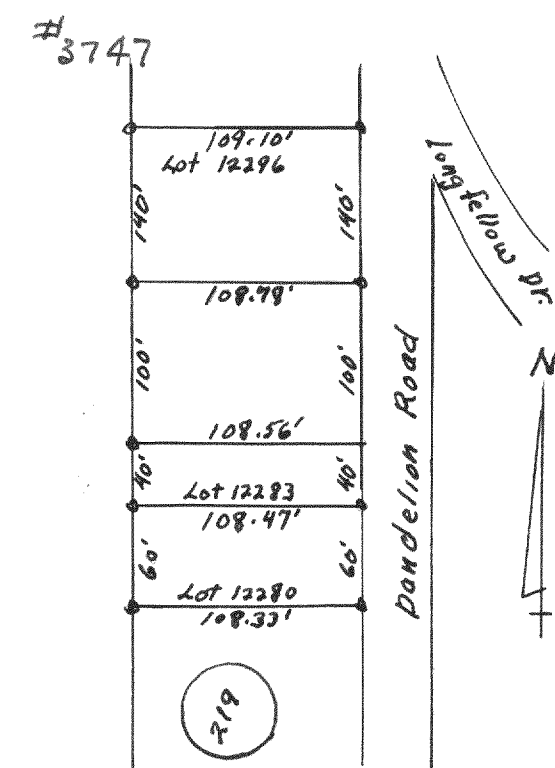


Survey Lots 12280-12296, Blk 219, Lake Como Beach, T2N, R17E, Wal. Co. Wisc.

Lloyd L. Jensen
County Surveyor

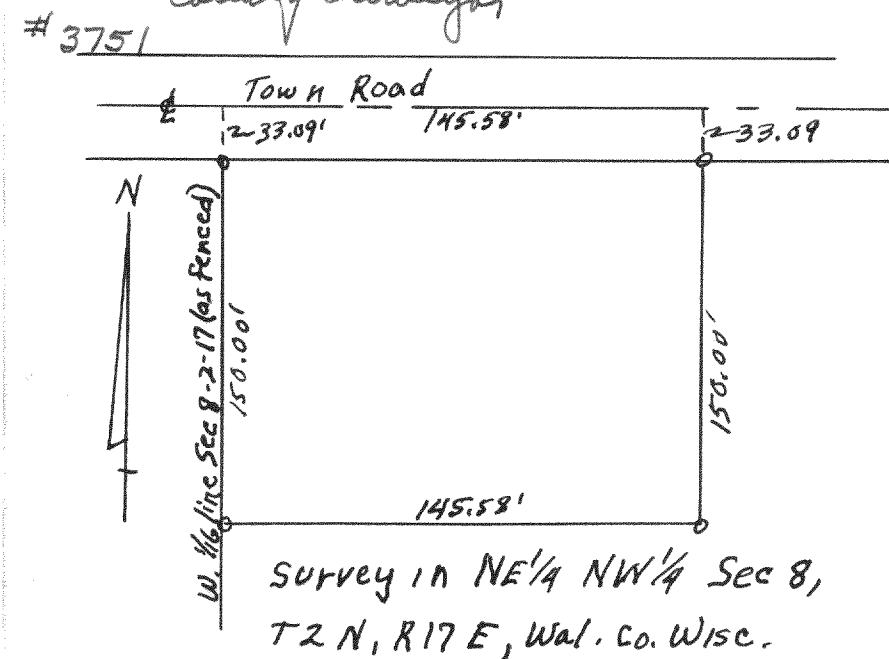


Survey in NE 1/4 NW 1/4 Sec 8, T2N, R17E, Wal. Co. Wisc.

Lloyd L. Jensen
County Surveyor

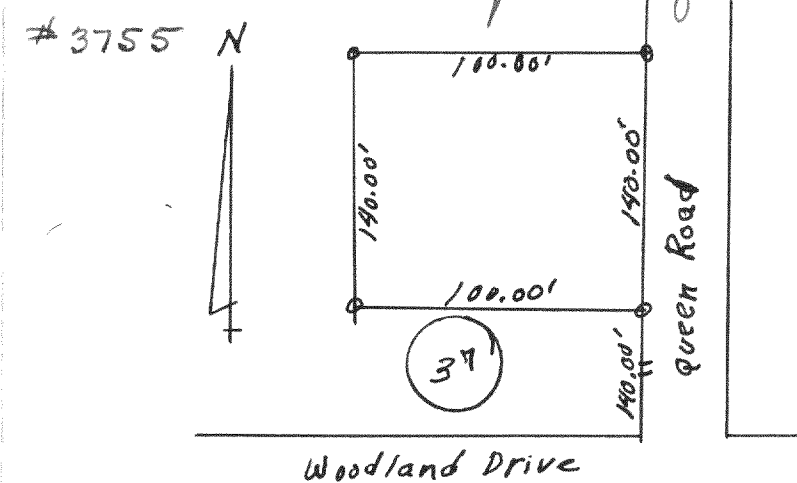


Survey of Lots 2245-51, Blk 37, Lake Como Beach, T2N, R17E, Wal. Co. Wisc.

Lloyd L. Jensen

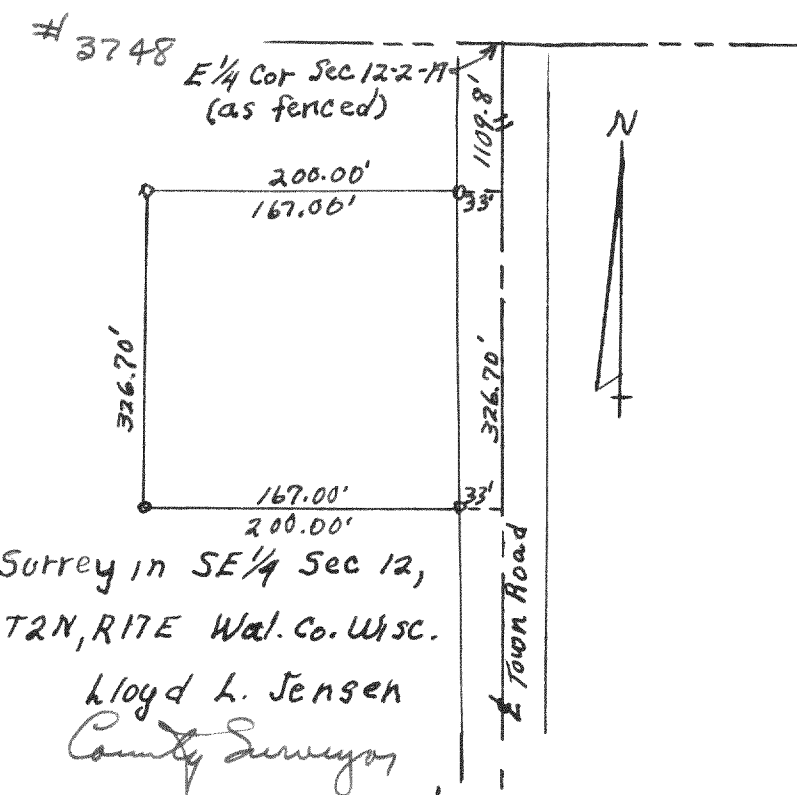


Survey in SE 1/4 Sec 12, T2N, R17E, Wal. Co. Wisc.

Lloyd L. Jensen
County Surveyor

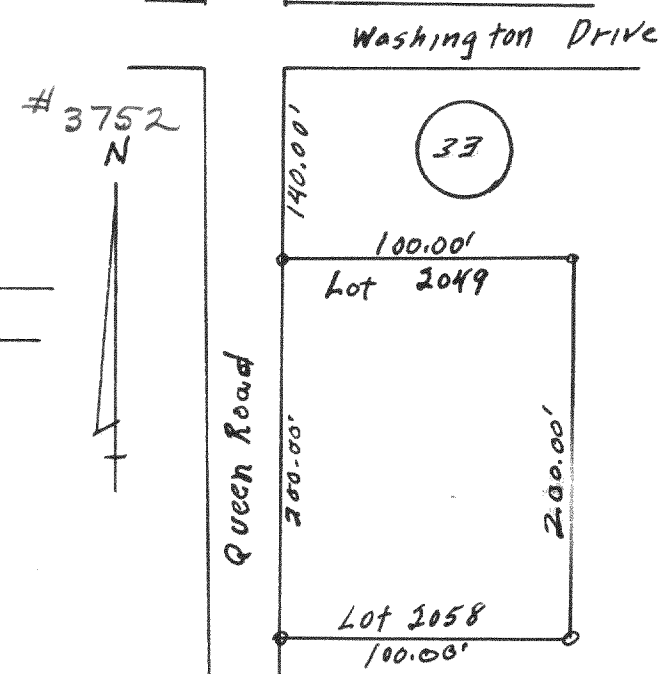


Survey of Lots 2049-58, Blk 33, Lake Como Beach, T2N, R17E, Wal. Co. Wisc.

Lloyd L. Jensen
County Surveyor

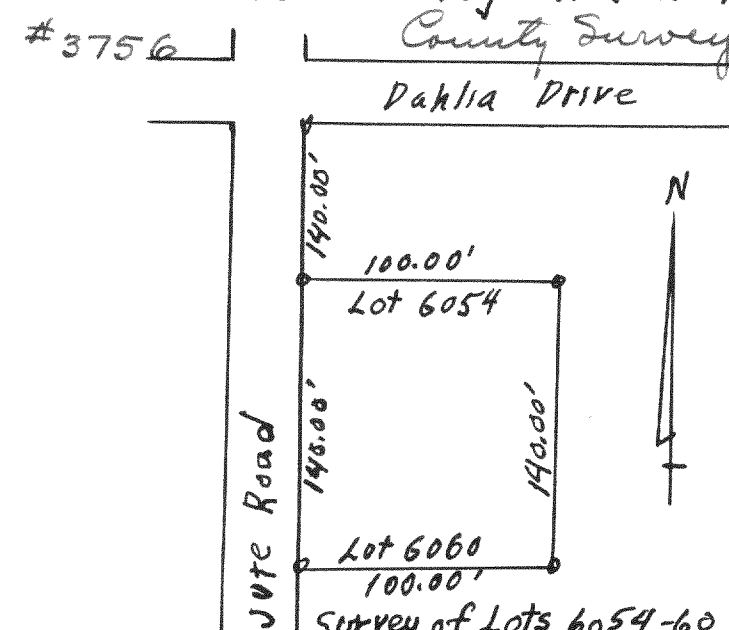


Survey of Lots 6054-60, Lake Como Beach, T2N, R17E, Wal. Co. Wisc.

Lloyd L. Jensen

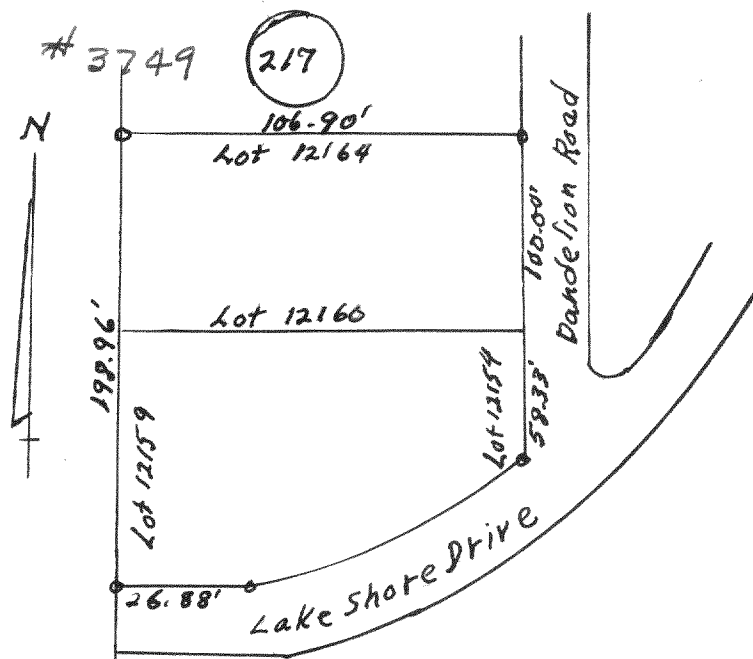


Survey of Lots 12154-61, Blk 217, Lake Como Beach, T2N, R17E, Wal. Co. Wisc.

Lloyd L. Jensen
County Surveyor

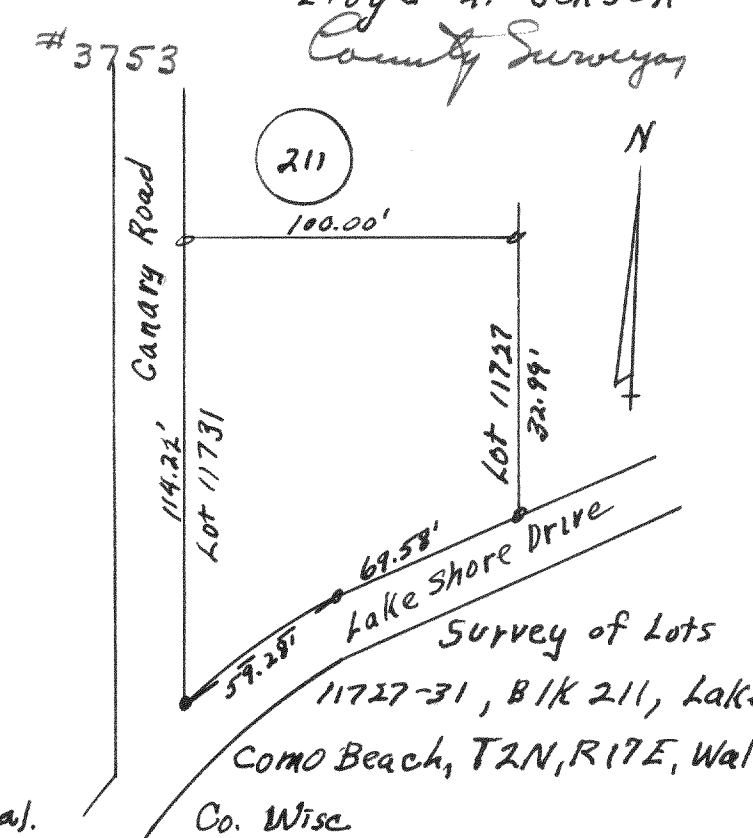


Survey of Lots 11727-31, Blk 211, Lake Como Beach, T2N, R17E, Wal. Co. Wisc.

Lloyd L. Jensen
County Surveyor

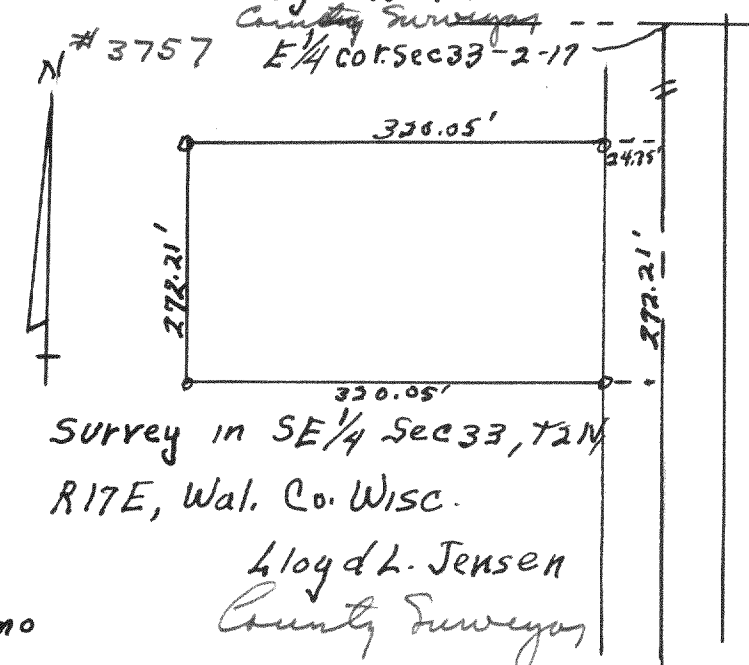


Survey in SE 1/4 Sec 33, T2N, R17E, Wal. Co. Wisc.

Lloyd L. Jensen
County Surveyor

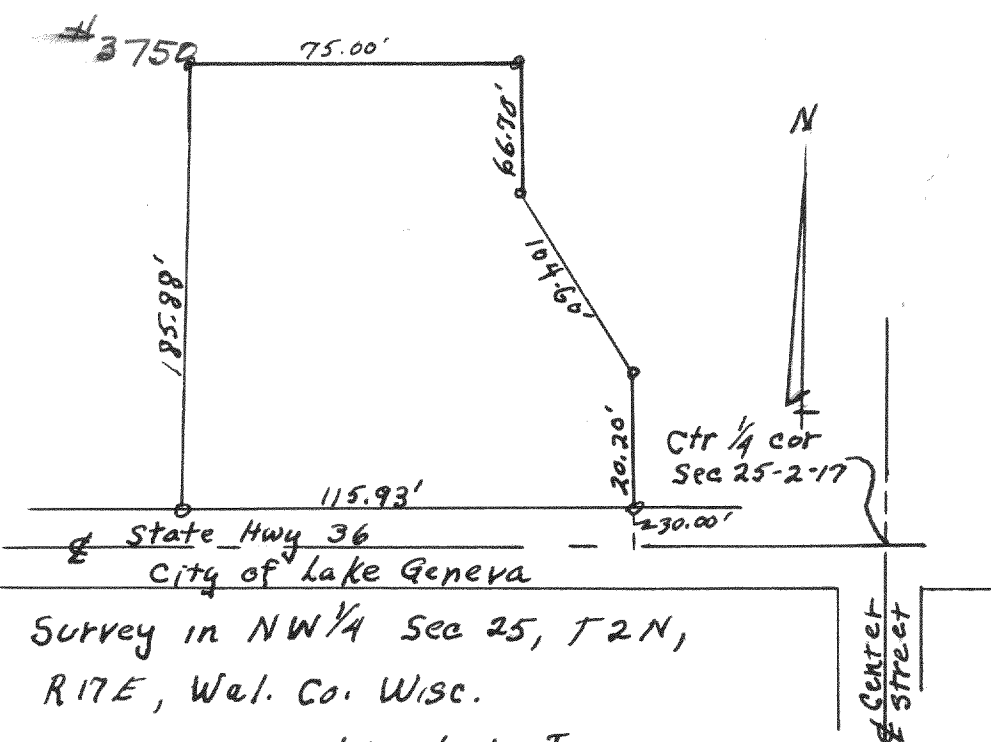


Survey in NW 1/4 Sec 25, T2N, R17E, Wal. Co. Wisc.

Lloyd L. Jensen
County Surveyor

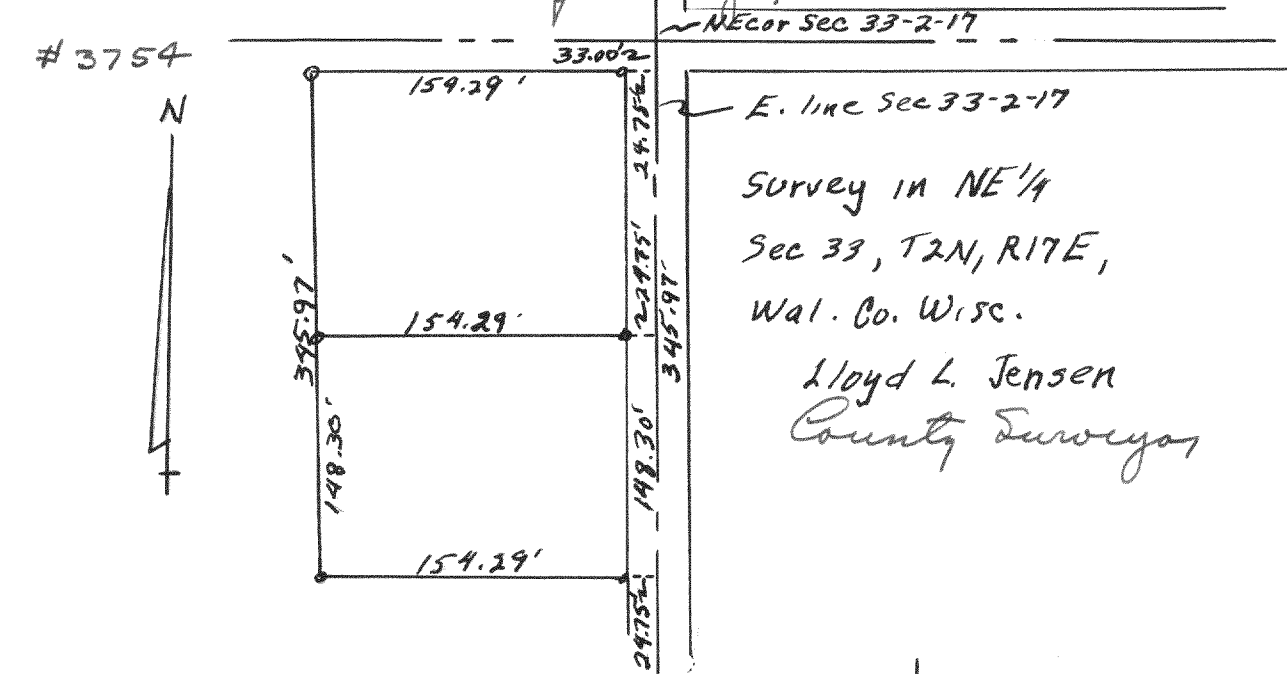

Survey in NE 1/4 Sec 33, T2N, R17E, Wal. Co. Wisc.

Lloyd L. Jensen
County Surveyor

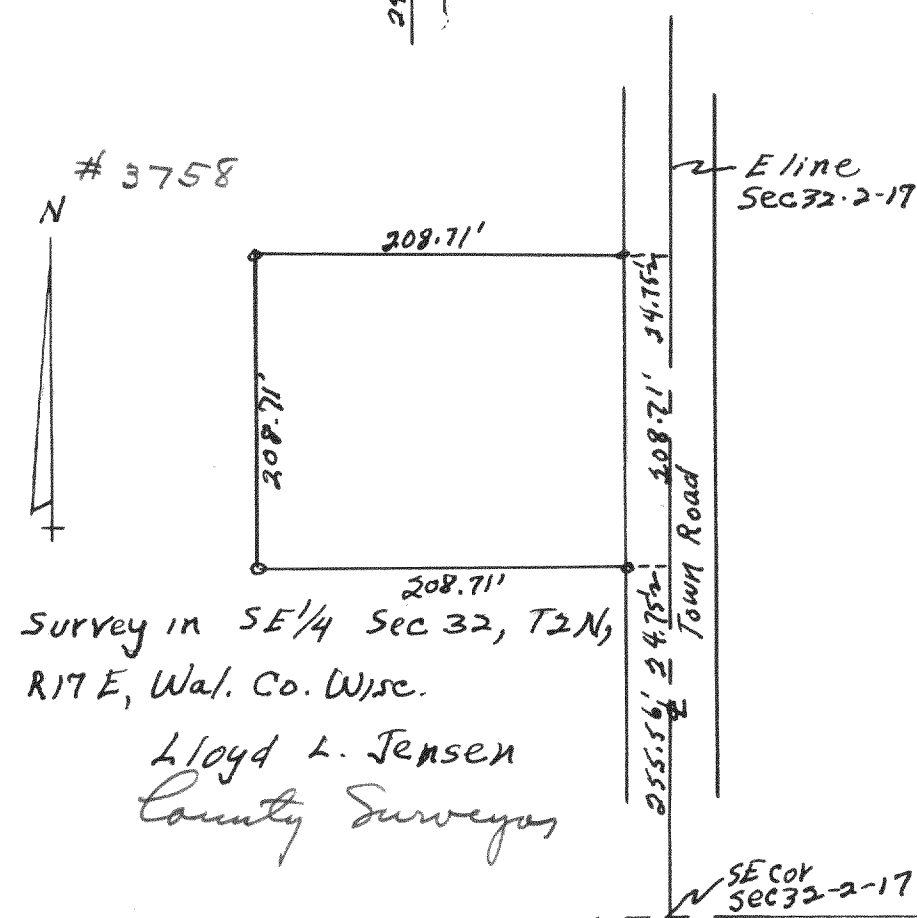

Survey in SE 1/4 Sec 32, T2N, R17E, Wal. Co. Wisc.

Lloyd L. Jensen
County Surveyor