




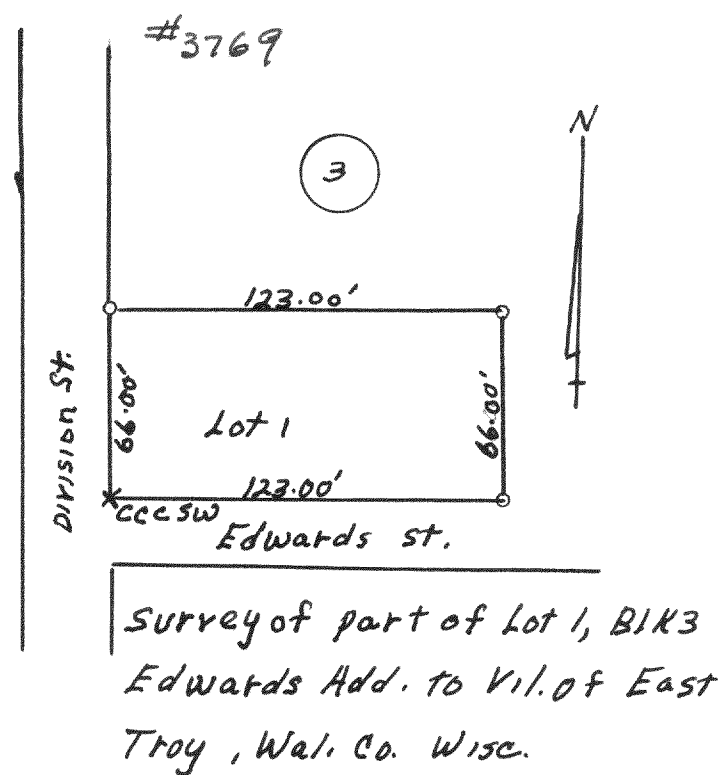


Lloyd L. Jensen
County Surveyor

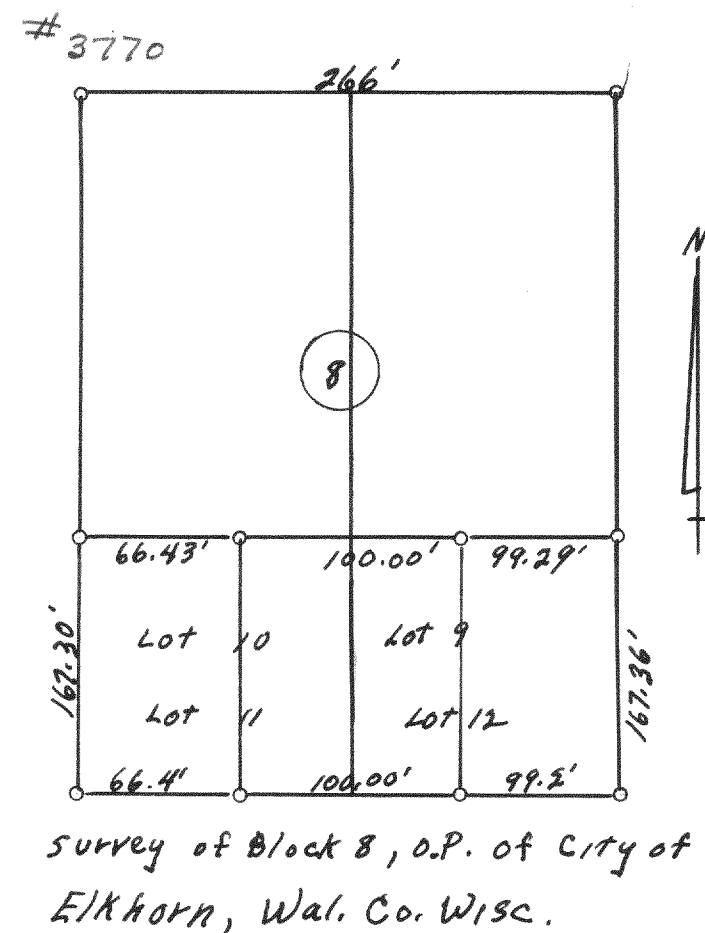


Lloyd L. Jensen
County Surveyor

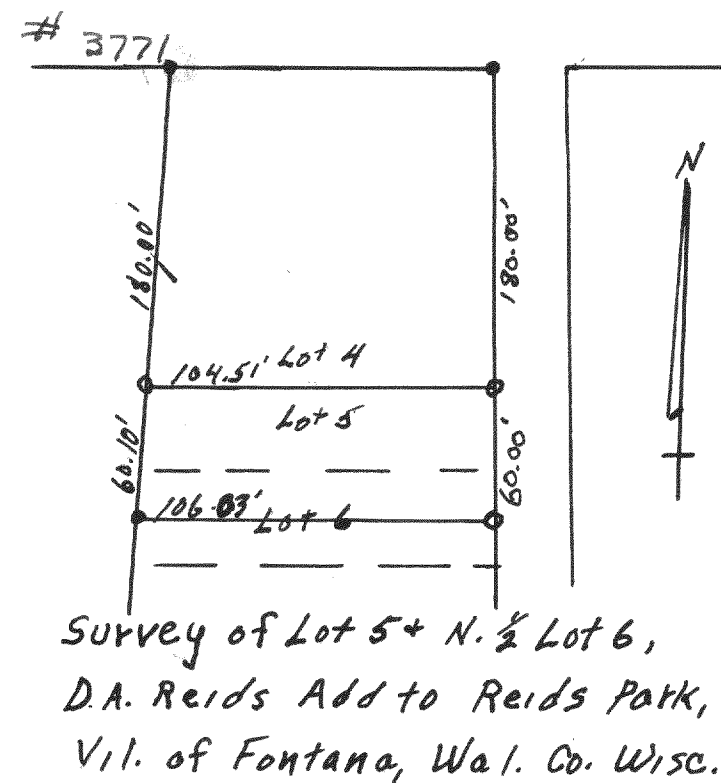

Lloyd L. Jensen
County Surveyor

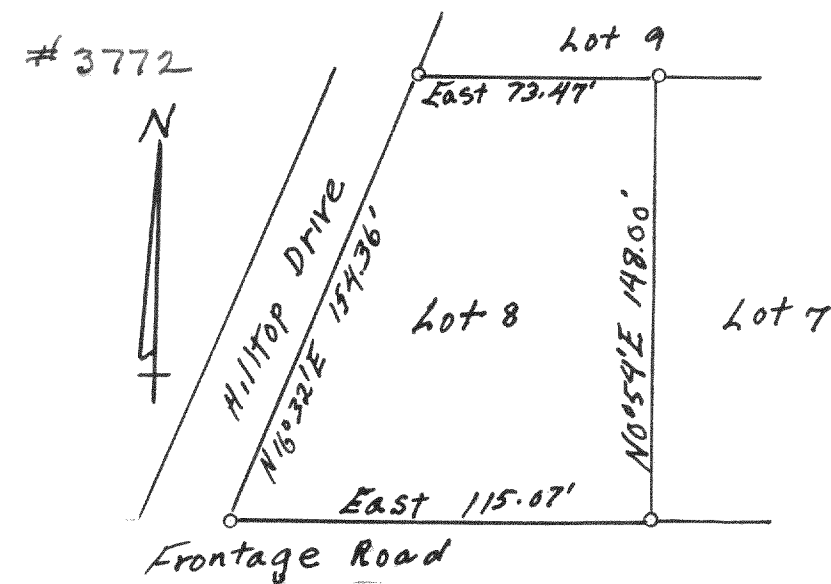


Lloyd L. Jensen
County Surveyor

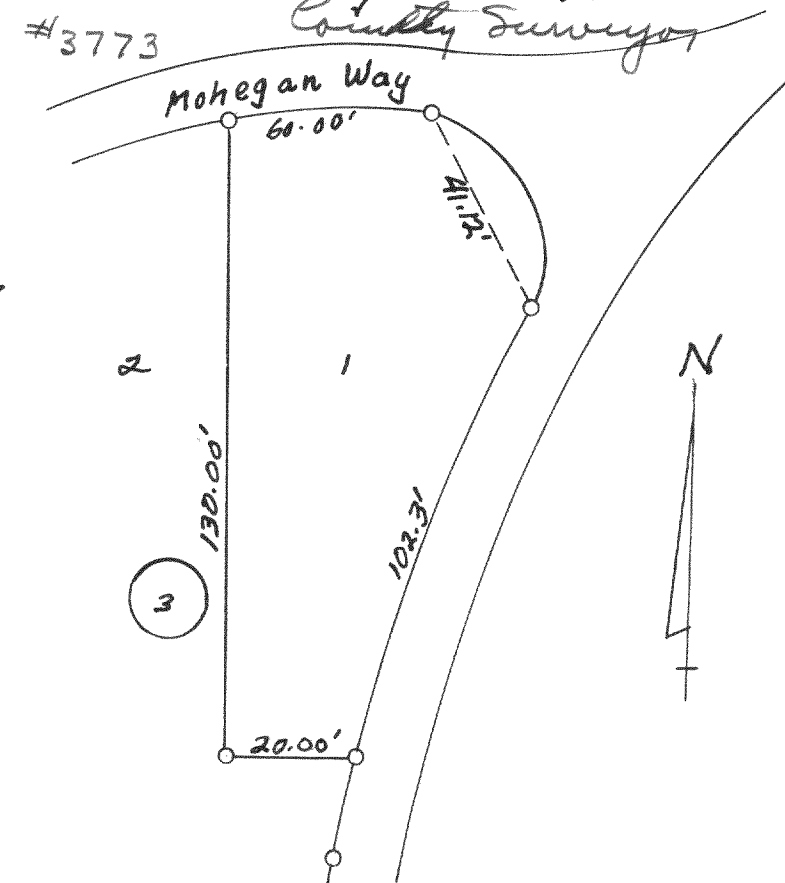


Lloyd L. Jensen
County Surveyor


#3776

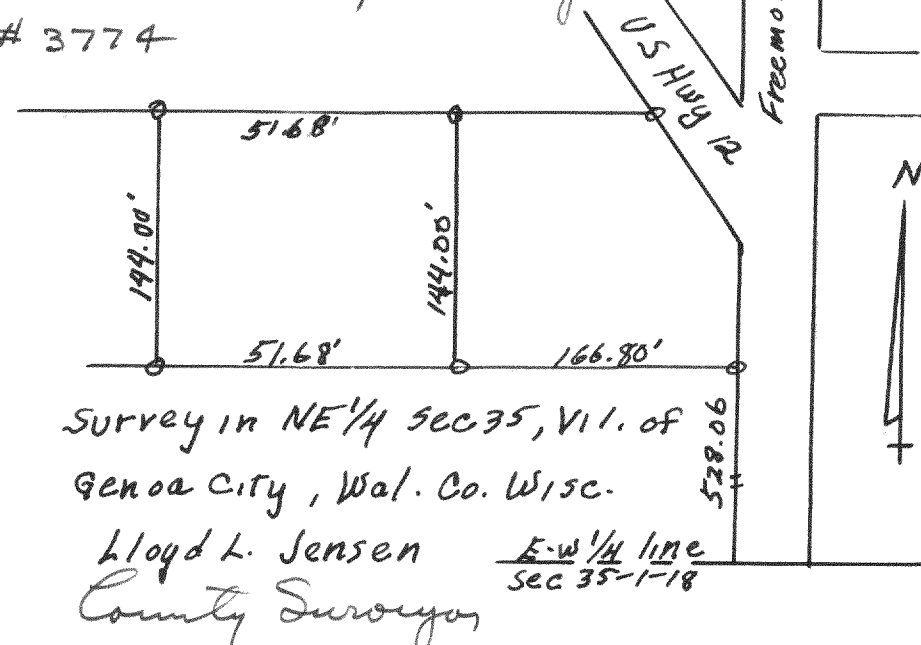


Lloyd L. Jensen
County Surveyor

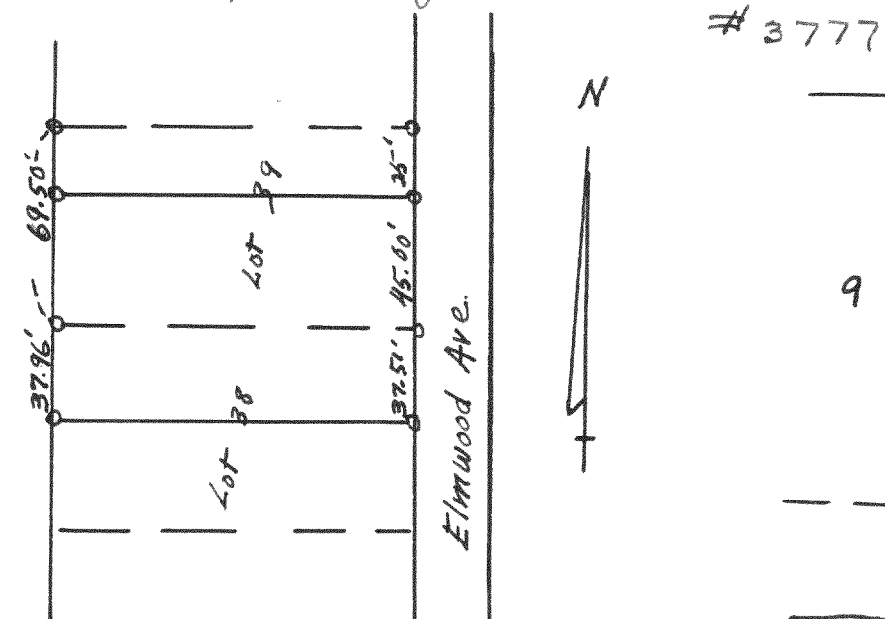

Lloyd L. Jensen
County Surveyor

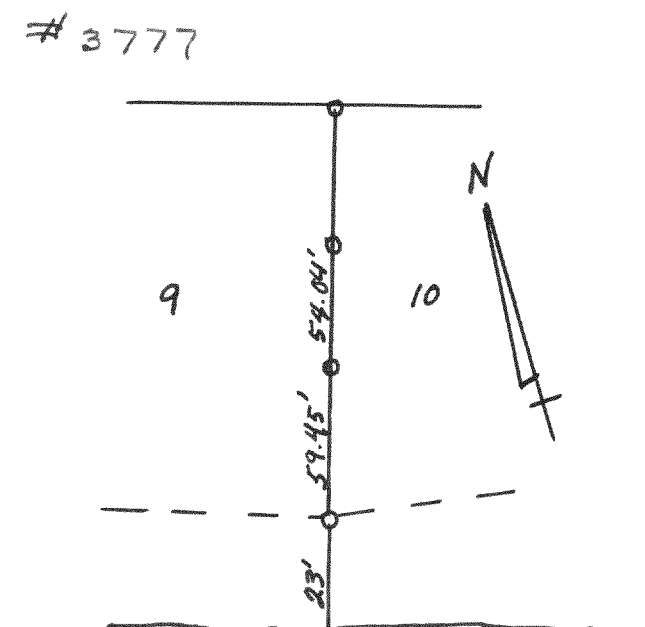

Lloyd L. Jensen
County Surveyor

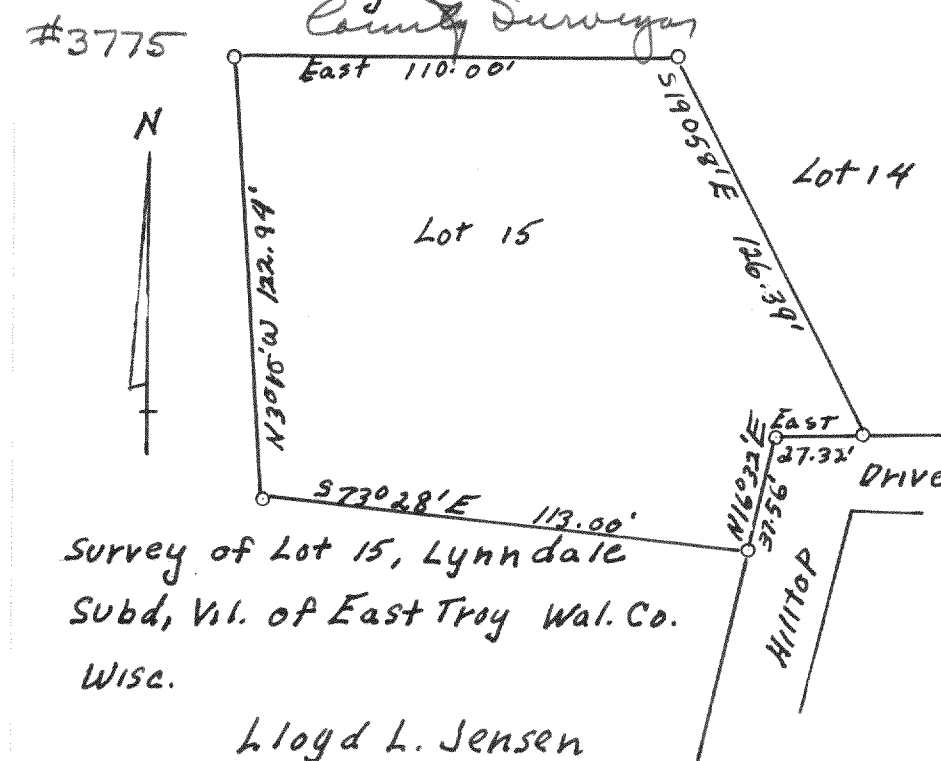

Lloyd L. Jensen