



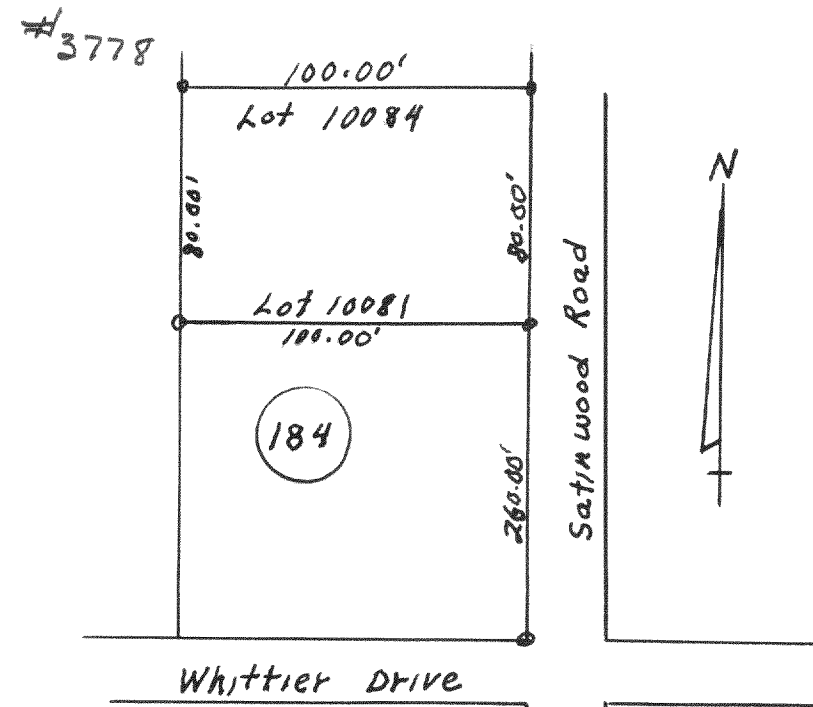


Survey of Lots 10081-84,
B1K 184, Lake Como Beach,
T2N, R17E, Wal. Co. Wisc.

Lloyd L. Jensen
County Surveyor

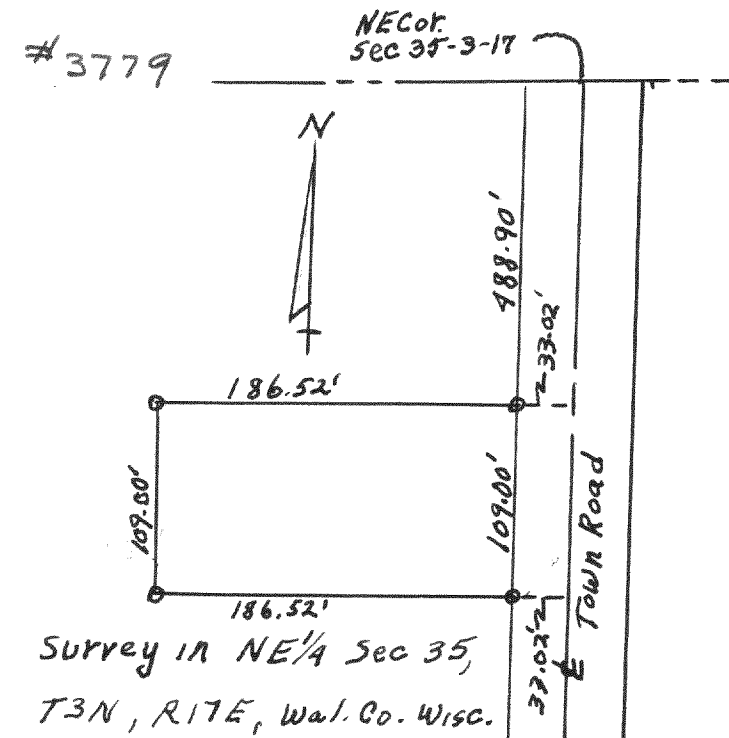


Survey in NE 1/4 Sec 35,
T3N, R17E, Wal. Co. Wisc.

Lloyd L. Jensen
County Surveyor

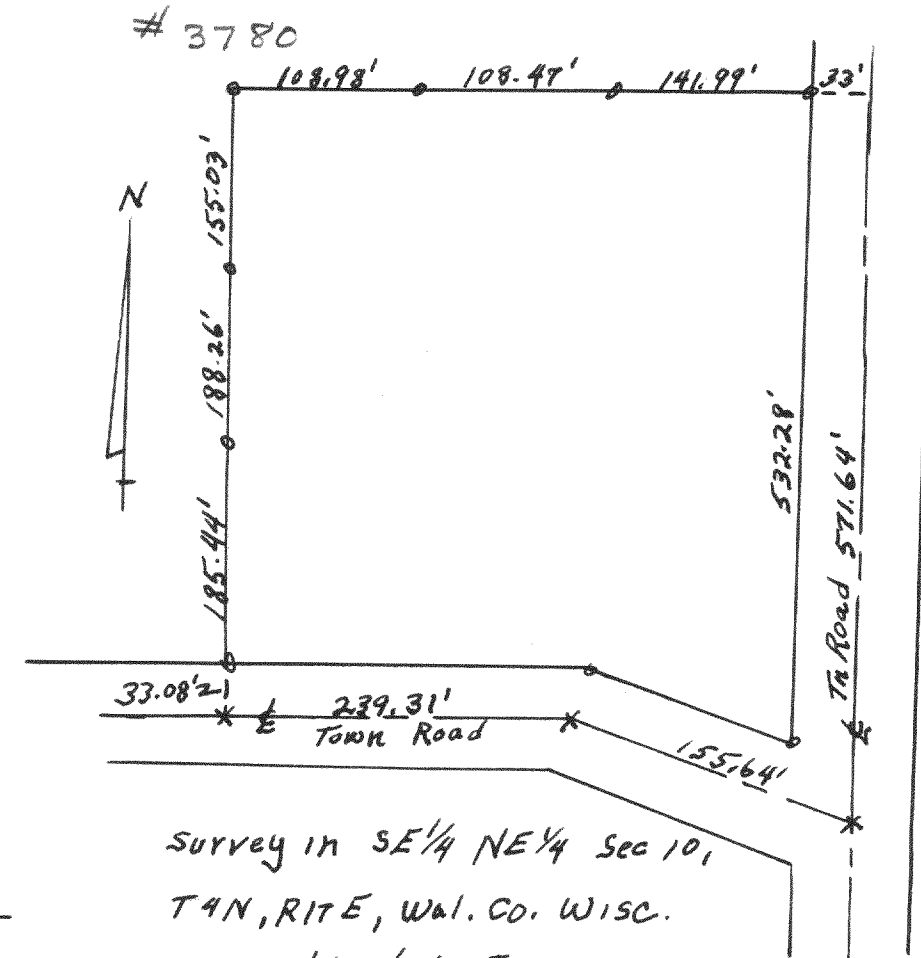


Survey in SE 1/4 NE 1/4 Sec 10,
T4N, R17E, Wal. Co. Wisc.

Lloyd L. Jensen
County Surveyor

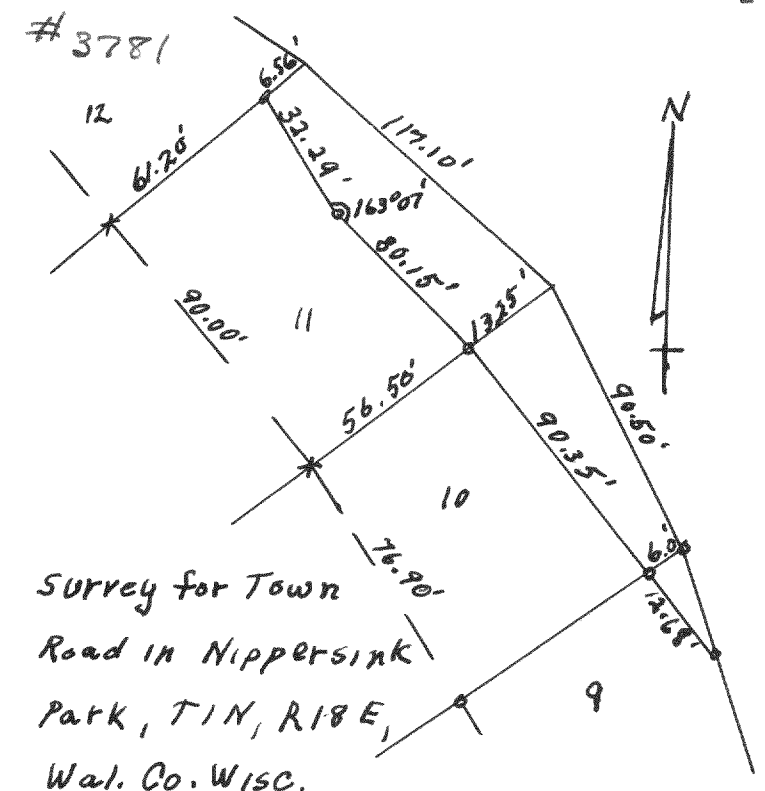


Survey for Town
Road in Nippersink
Park, T1N, R18E,
Wal. Co. Wisc.

Lloyd L. Jensen
County Surveyor

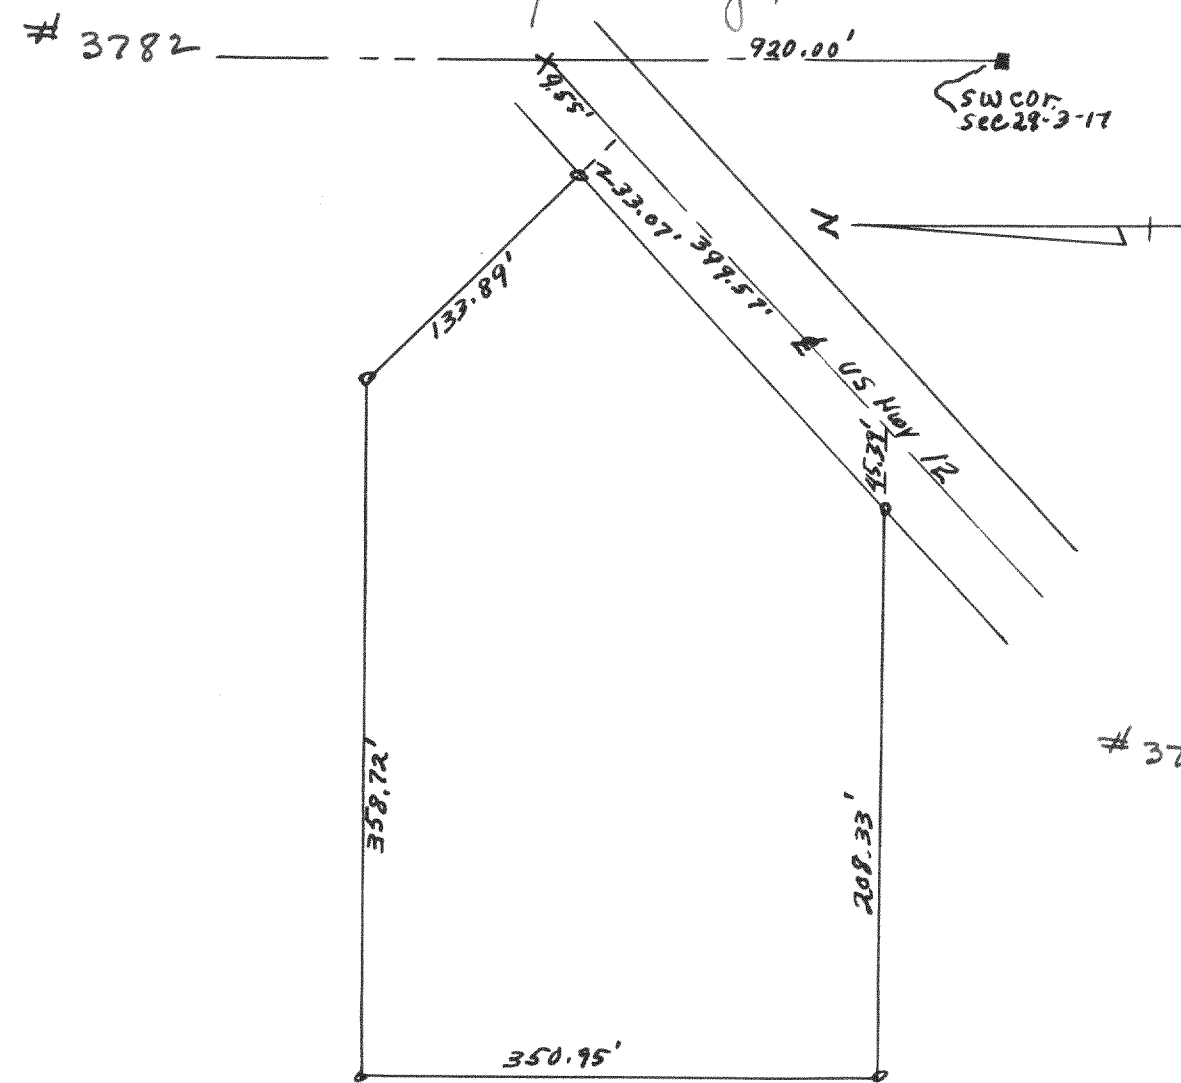


Survey in SE 1/4 Sec 30, T3N, R17E, Wal. Co. Wisc.

Lloyd L. Jensen
County Surveyor

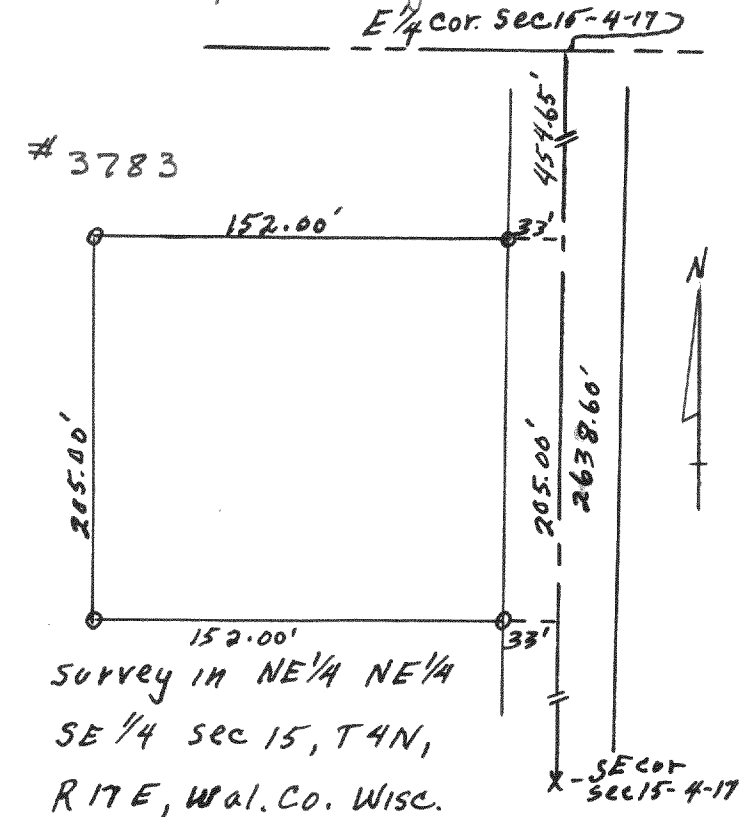


Survey in NE 1/4 NE 1/4
SE 1/4 Sec 15, T4N,
R17E, Wal. Co. Wisc.

Lloyd L. Jensen
County Surveyor

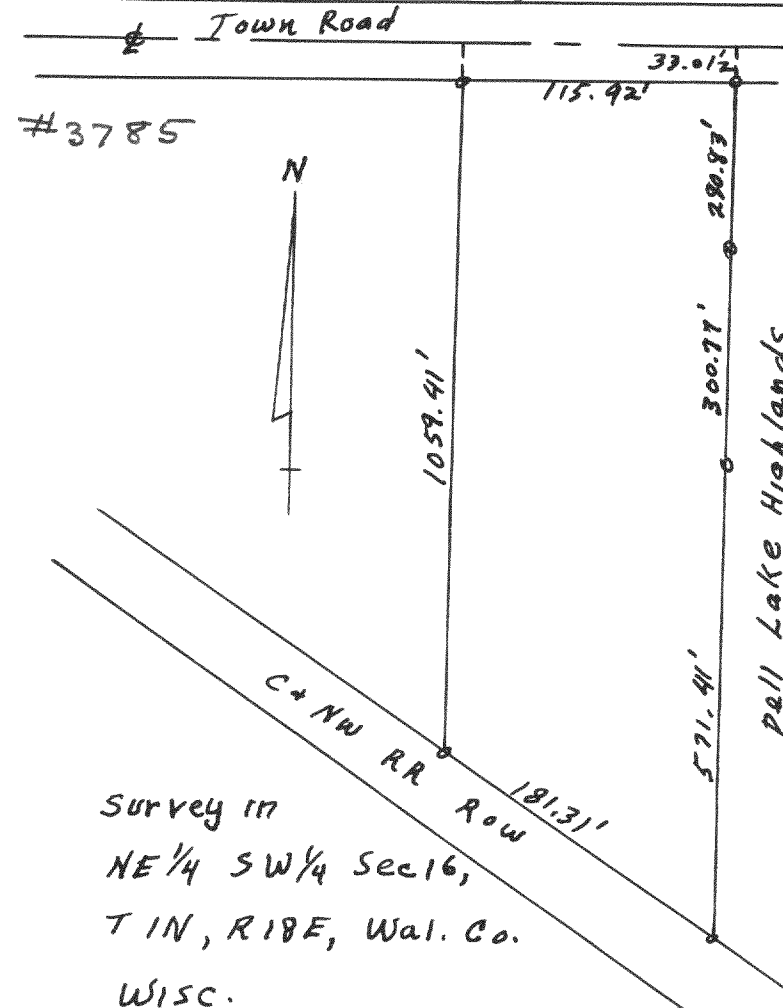


Survey in
NE 1/4 SW 1/4 Sec 16,
T1N, R18E, Wal. Co.
Wisc.

Lloyd L. Jensen
County Surveyor

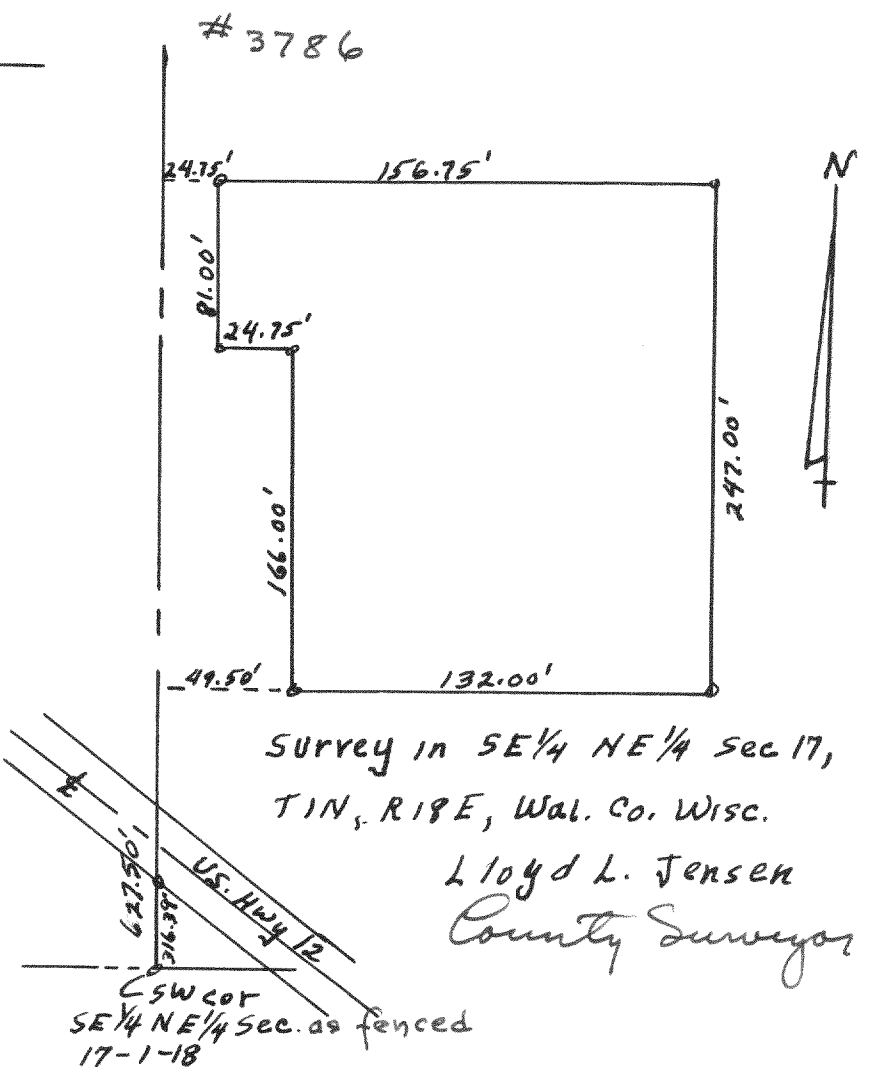

Survey in SE 1/4 NE 1/4 Sec 17,
T1N, R18E, Wal. Co. Wisc.

Lloyd L. Jensen
County Surveyor

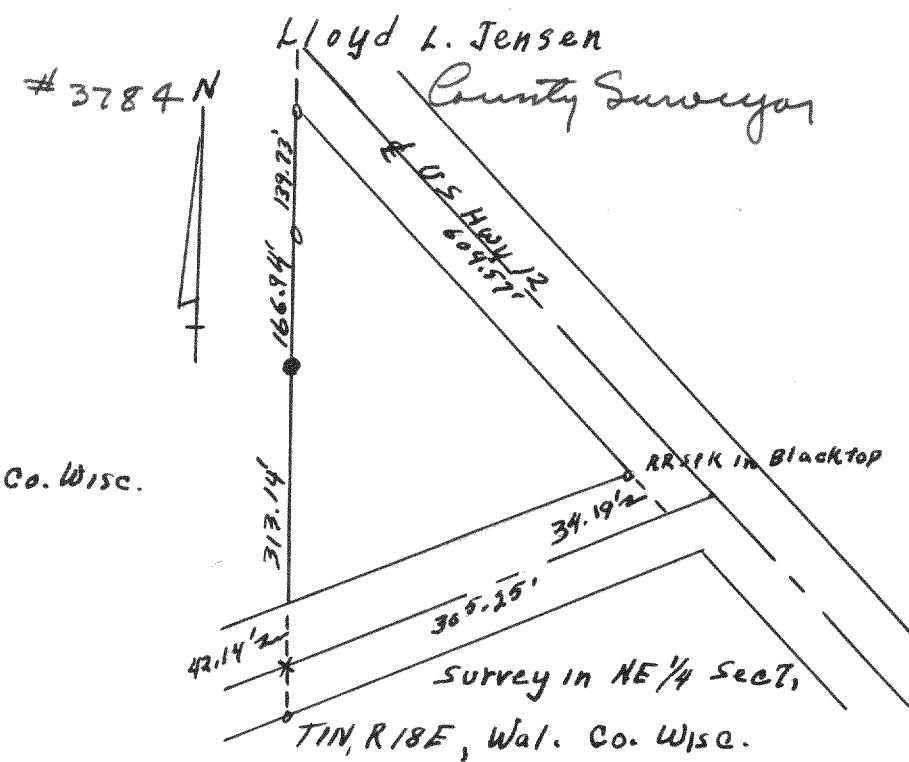

Survey in NE 1/4 Sec 1,
T1N, R18E, Wal. Co. Wisc.

Lloyd L. Jensen