


#3809

PLAT OF SURVEY OF
LOT 11, TONY AND JULIA PETERS ADDITION
TO THE CITY OF LAKE GENEVA, WALWORTH
COUNTY, WISCONSIN.

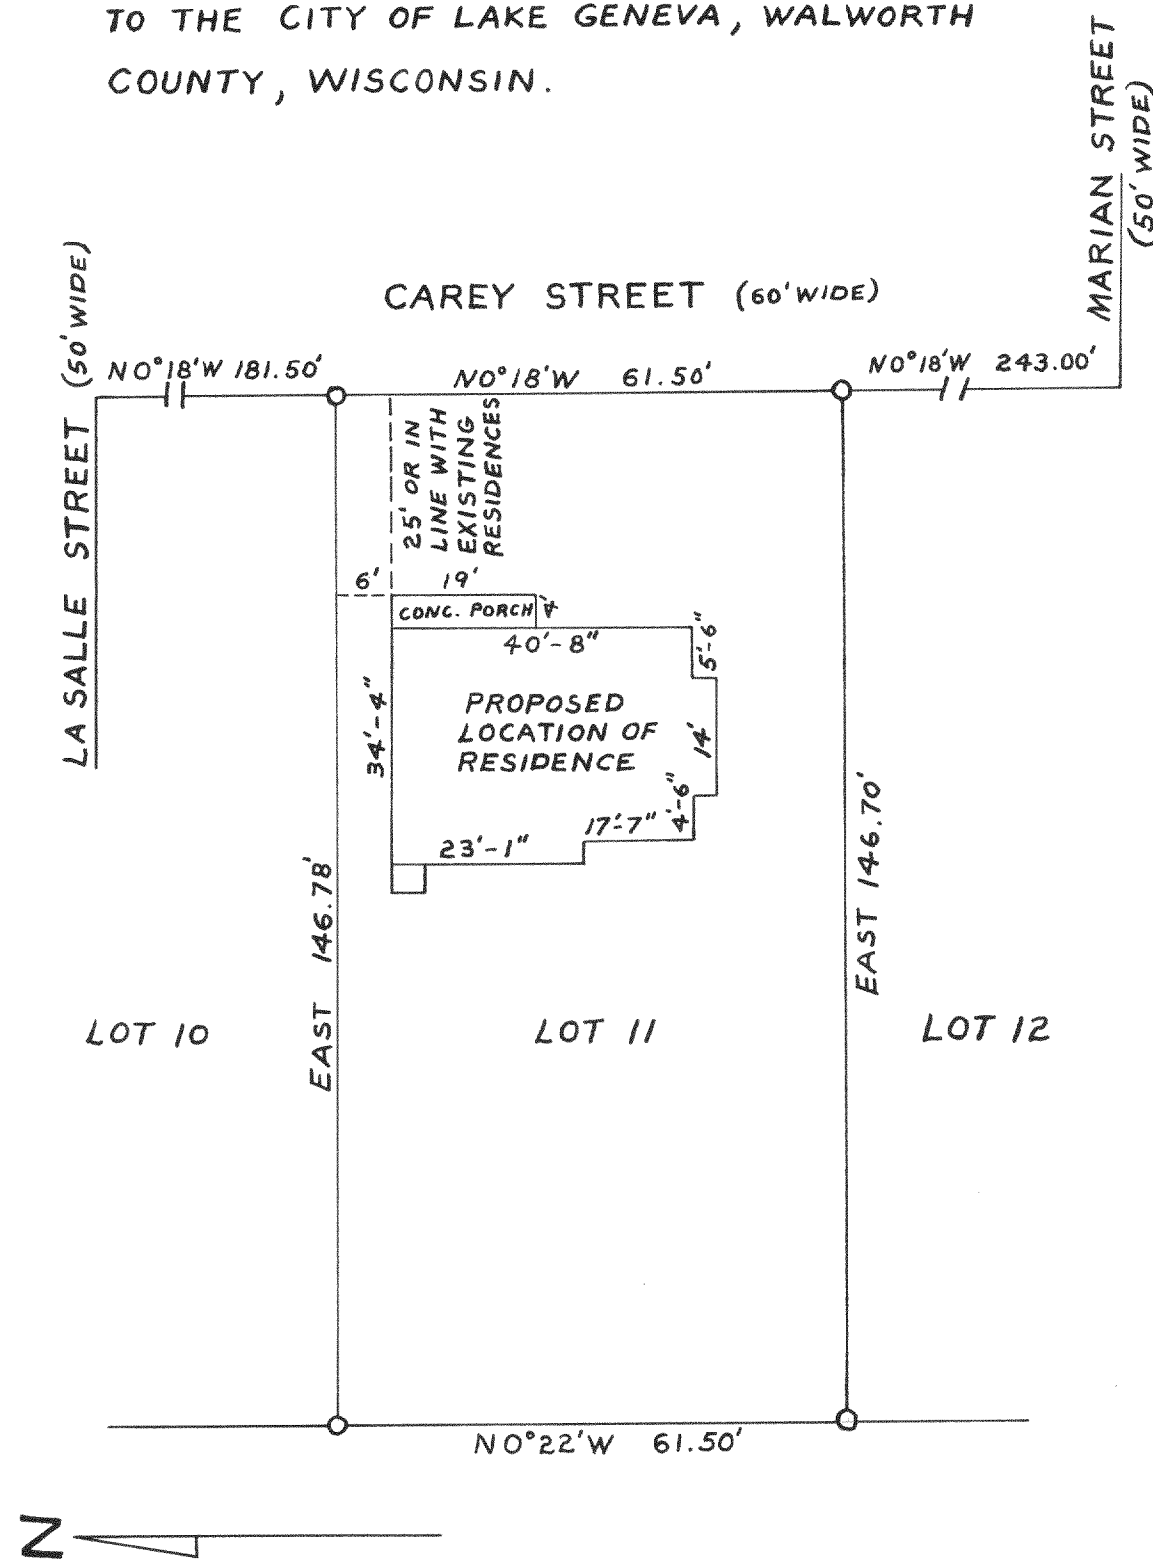


JUNE, 1960

Lloyd S. Jensen
COUNTY SURVEYOR

#3810

PLAT OF SURVEY OF
LOT 8, BLOCK 15, LAKE GENEVA MANOR, LOCATED
IN THE SE 1/4 SECTION 35, T2N, R17E, CITY OF LAKE
GENEVA, WALWORTH COUNTY, WISCONSIN.

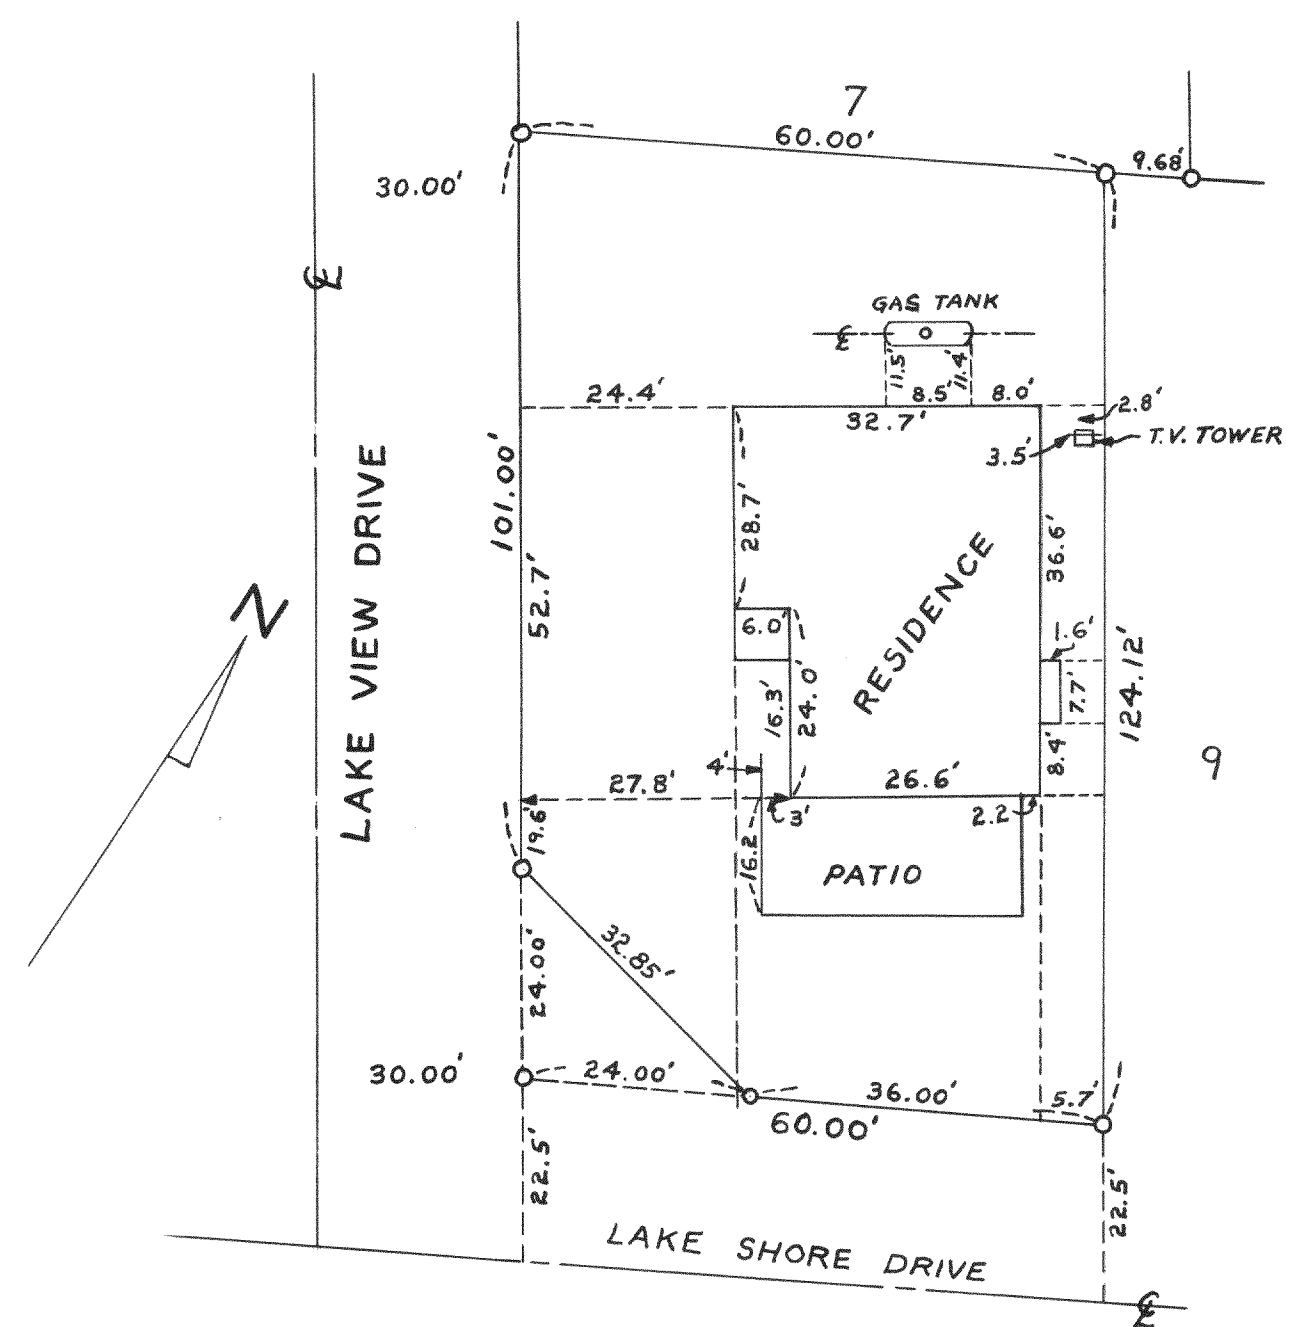


JULY 14, 1960

Lloyd S. Jensen
COUNTY SURVEYOR

#3811

PLAT OF SURVEY OF
PART OF LOTS 5 AND 6, BLOCK 13, ORIGINAL
PLAT OF THE CITY OF LAKE GENEVA,
WALWORTH COUNTY, WISCONSIN.

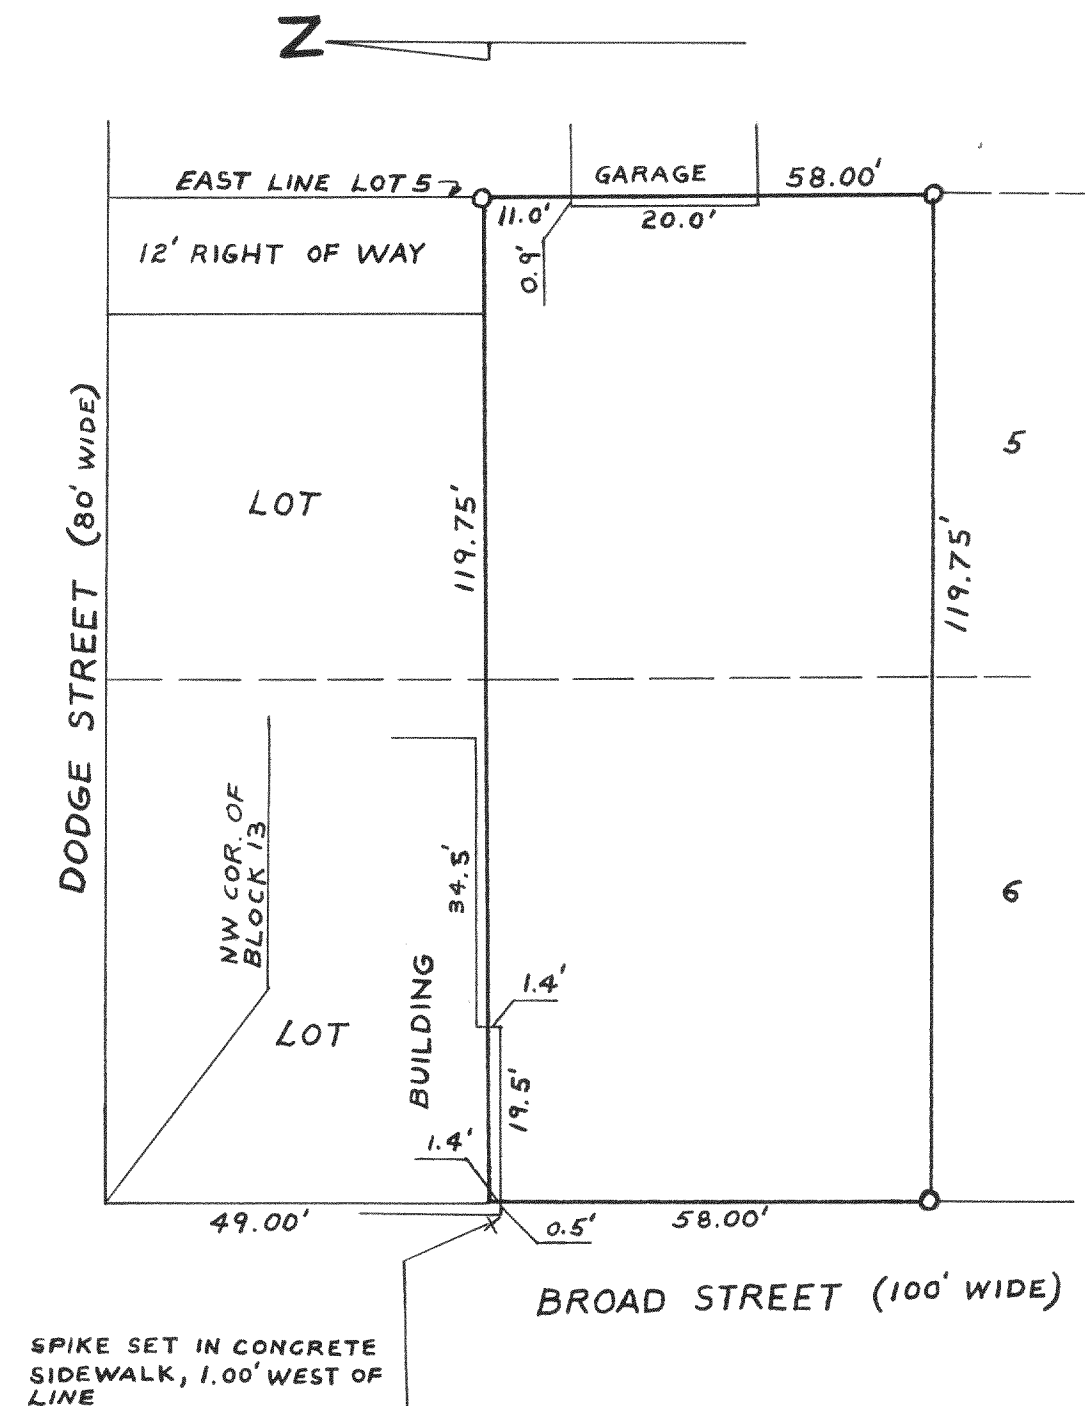

APRIL, 1960

Lloyd S. Jensen
COUNTY SURVEYOR