


#3818

PLAT OF SURVEY OF
PART OF LOTS 4 & 5 BLOCK 3
WISE AND NELSON'S ADD.
SHARON, WISCONSIN.

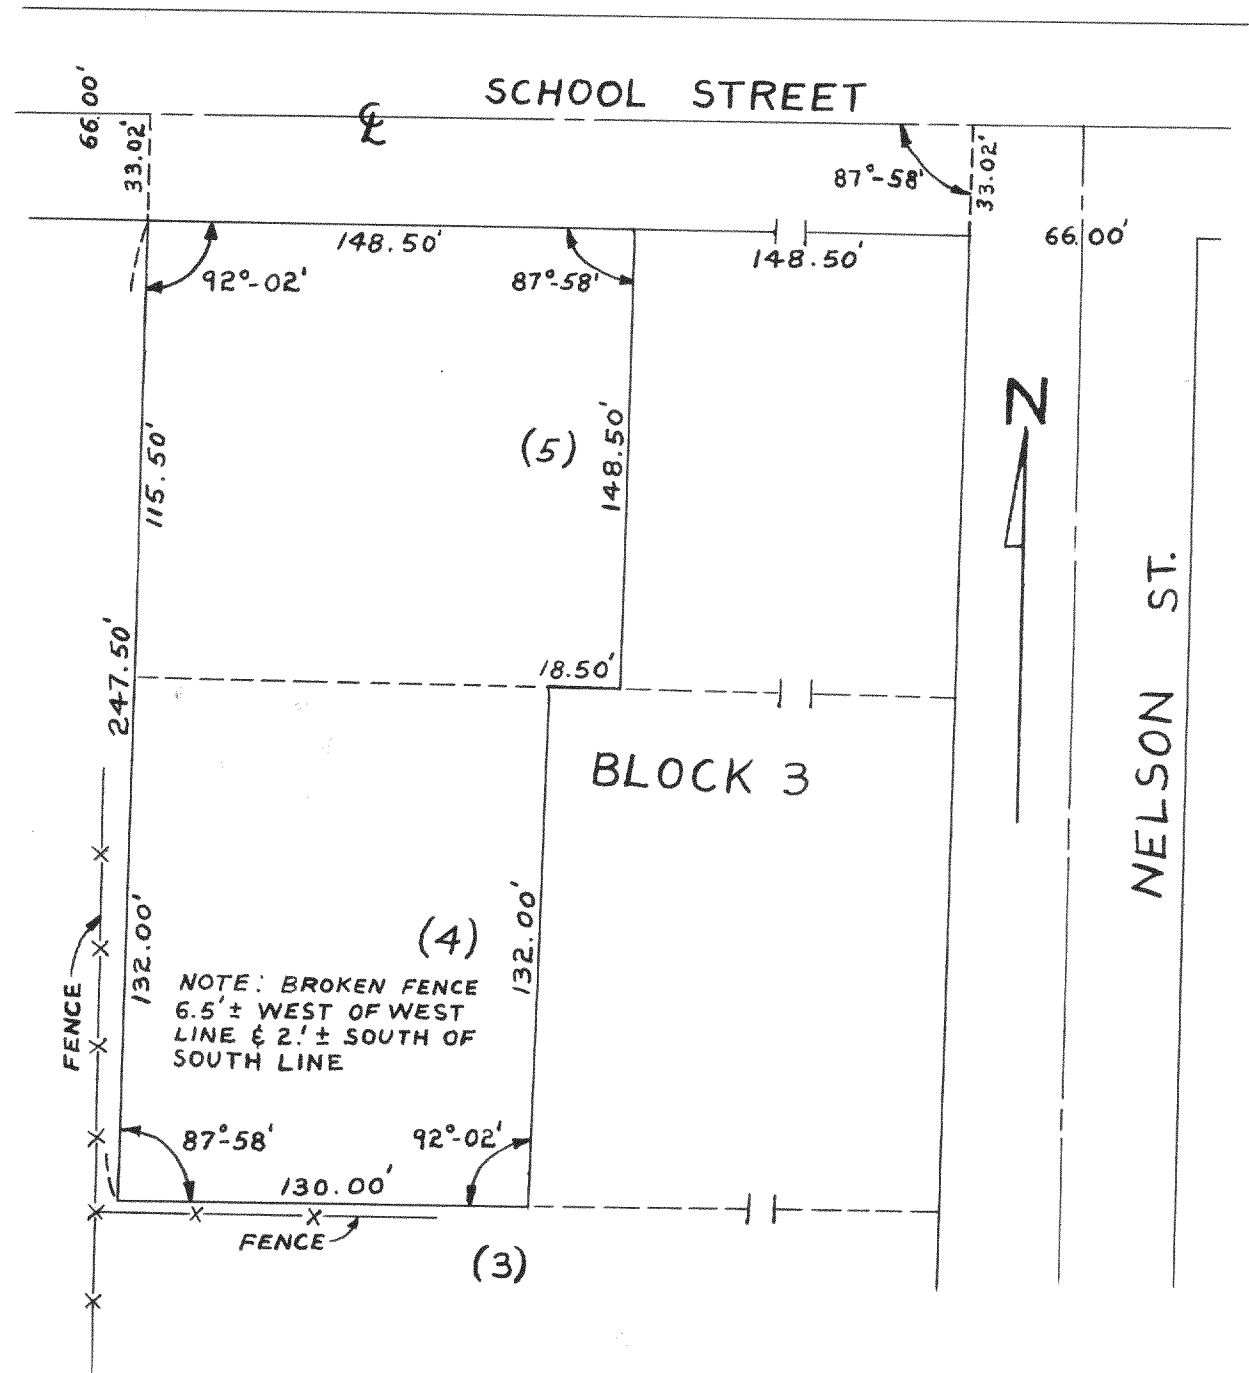


JULY, 1960

Lloyd S. Jensen
COUNTY SURVEYOR

#3819

PLAT OF SURVEY OF
LOT 6, BLOCK 1, GENEVA BAY ESTATES, LOCATED
IN THE CITY OF LAKE GENEVA, WALWORTH COUNTY
WISCONSIN.

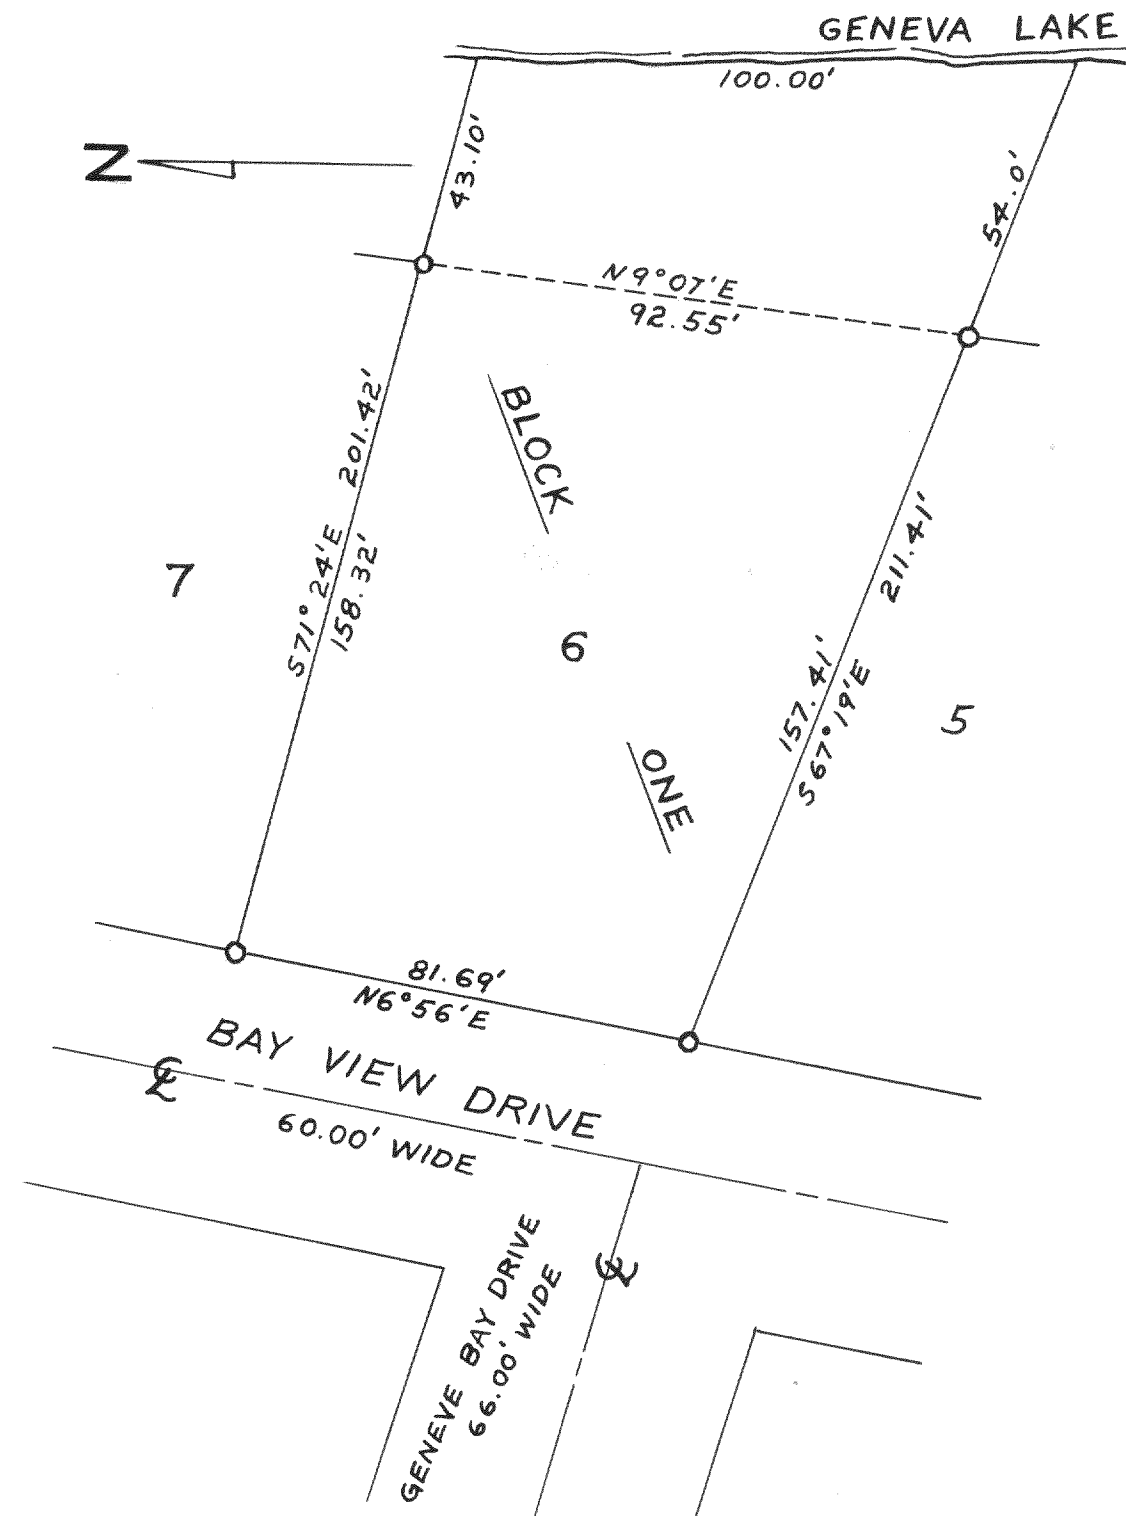


DECEMBER, 1960

Lloyd S. Jensen
COUNTY SURVEYOR

#3820

PLAT OF SURVEY OF
A PARCEL OF LAND LOCATED IN THE NW $\frac{1}{4}$ OF
THE NE $\frac{1}{4}$ OF SECTION 35, T2N, R17E,
CITY OF LAKE GENEVA, WALWORTH COUNTY,
WISCONSIN.

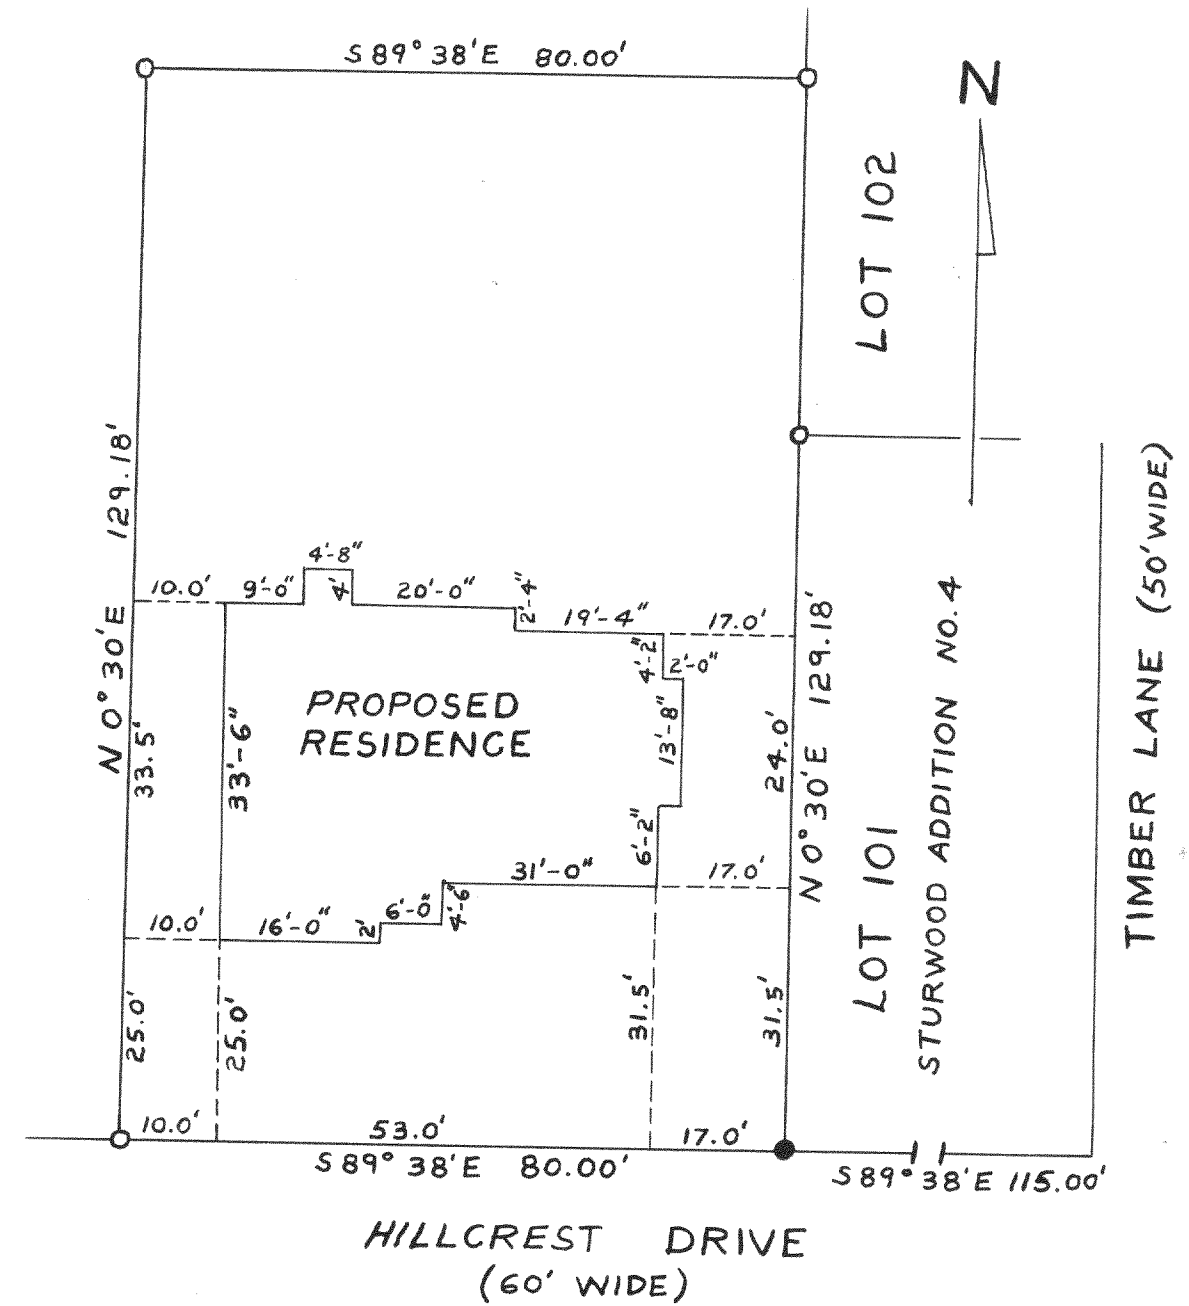

JUNE, 1960

Lloyd S. Jensen
COUNTY SURVEYOR