




#3848

Plat of Survey of Part
of Lots 3 and 4, Block 12,
original plat of the Village
of East Troy Walworth
County Wisconsin
May 1959 Lloyd L. Jensen
County Surveyor

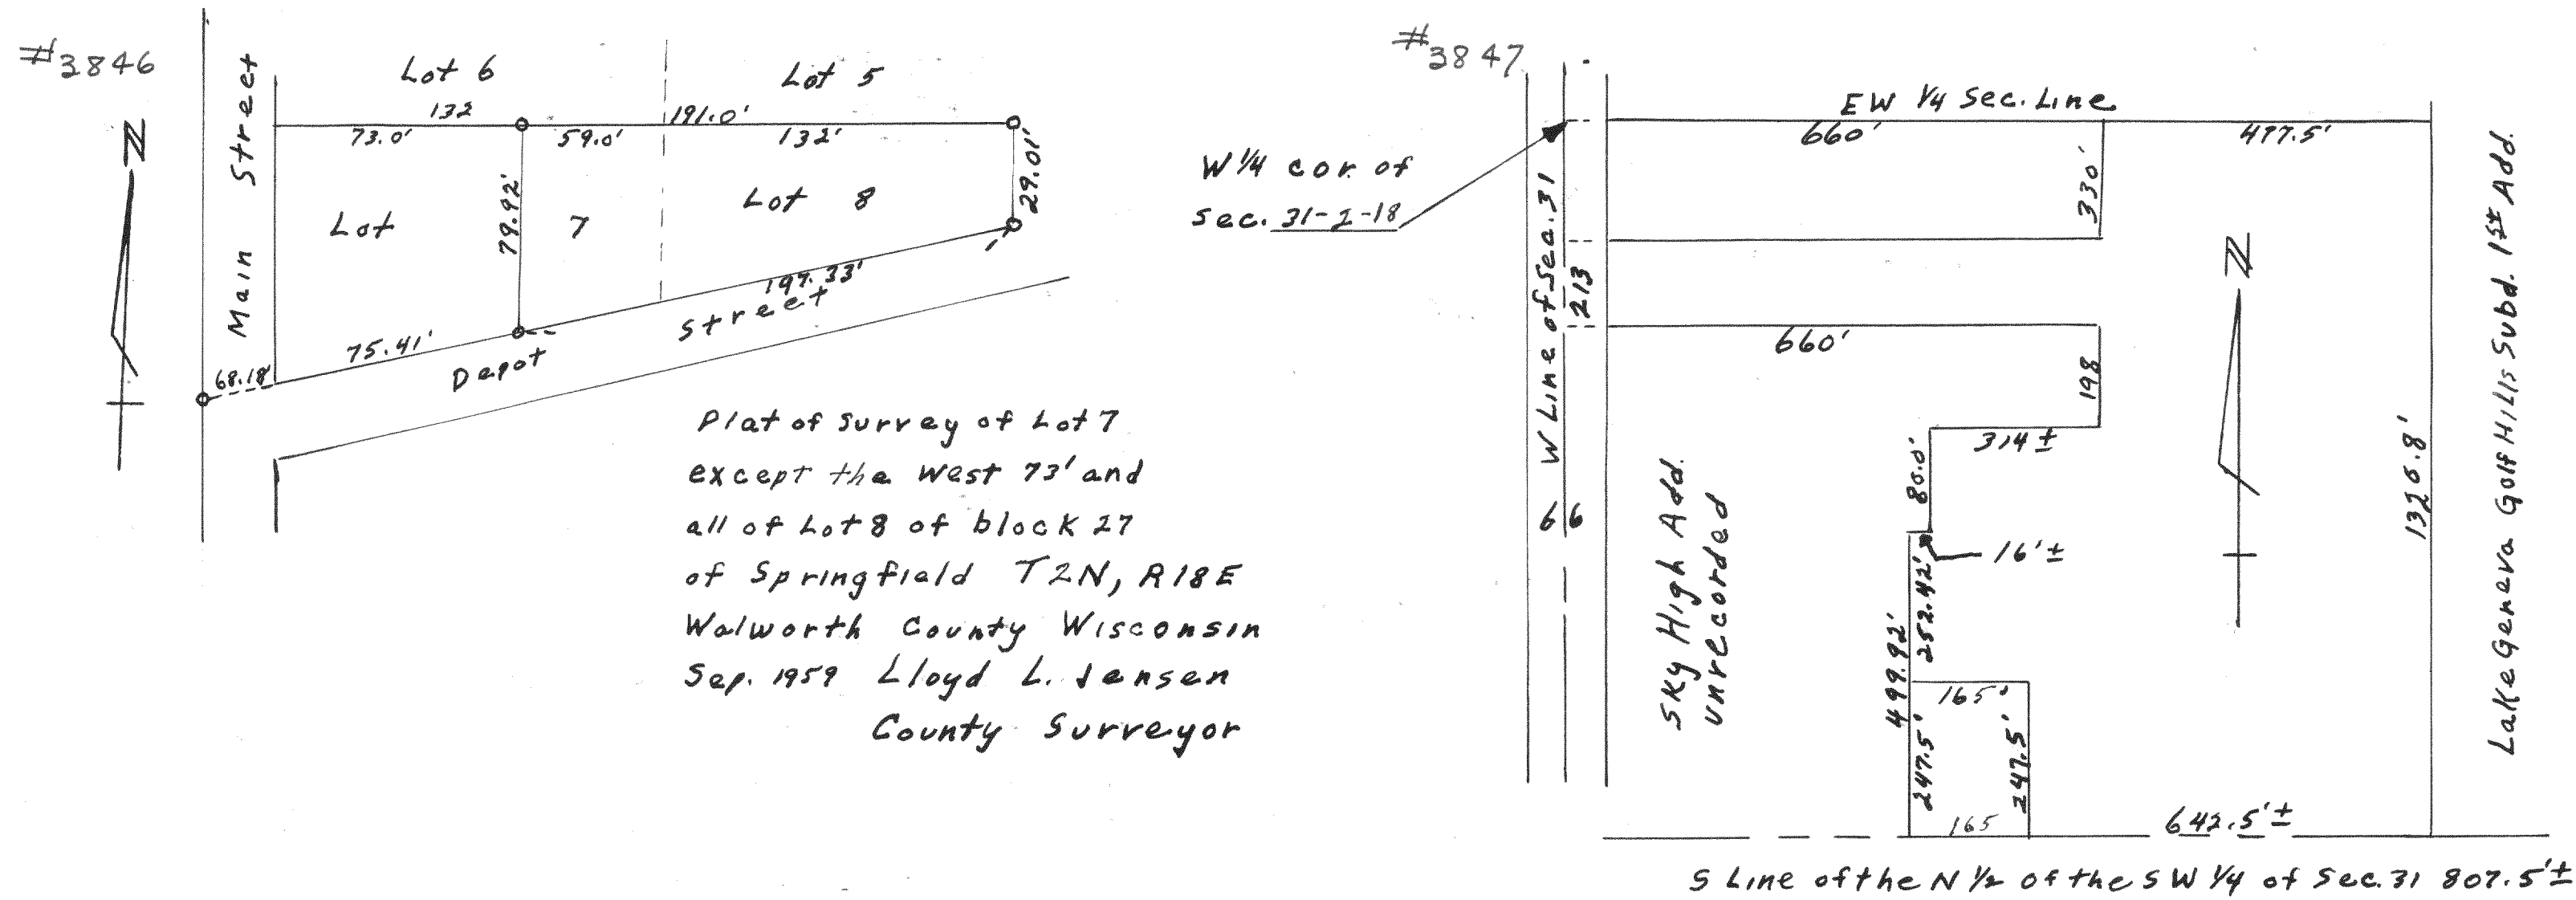