




2716

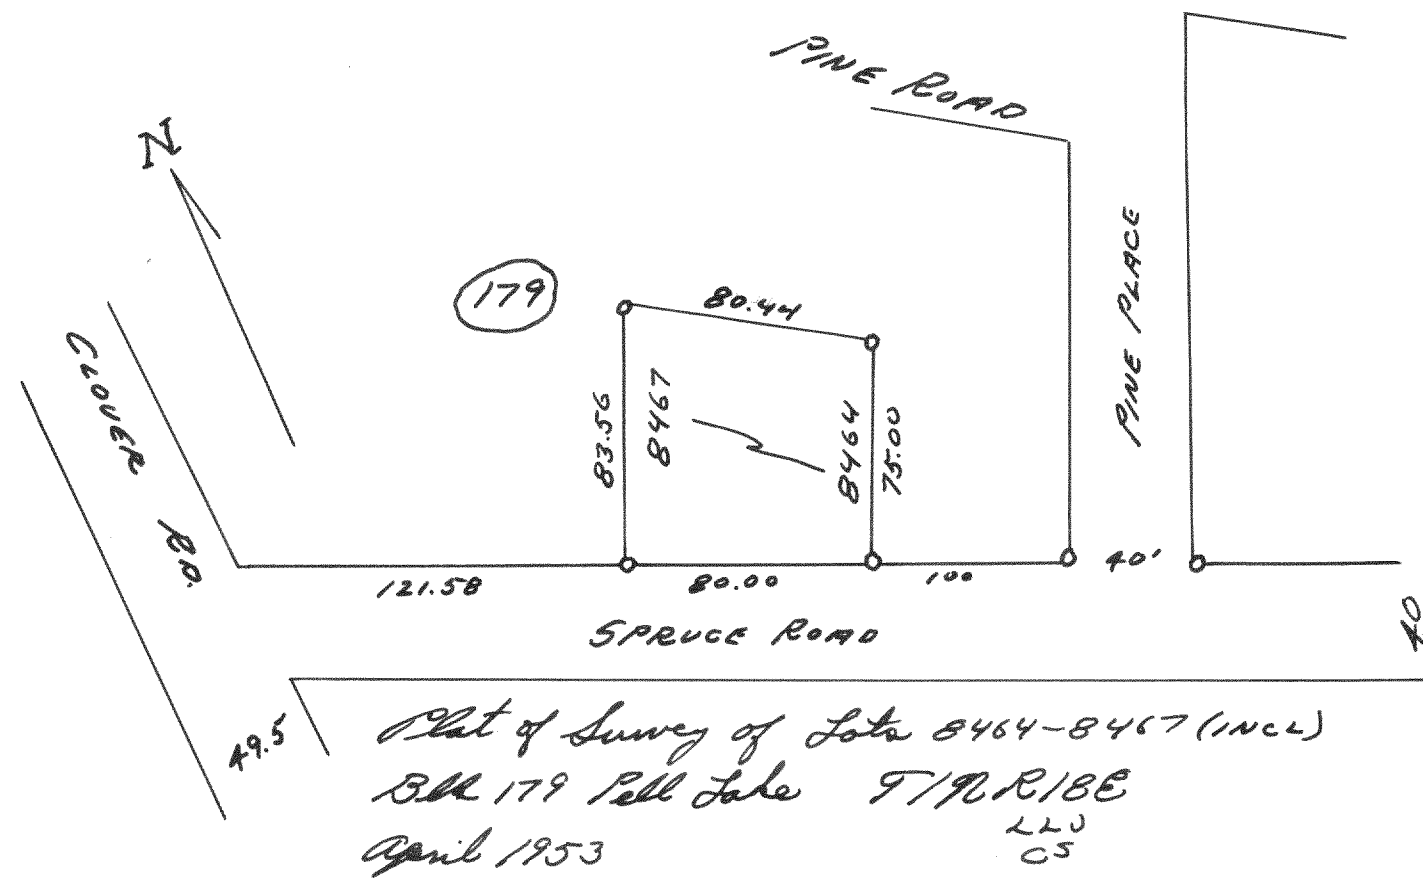


2717

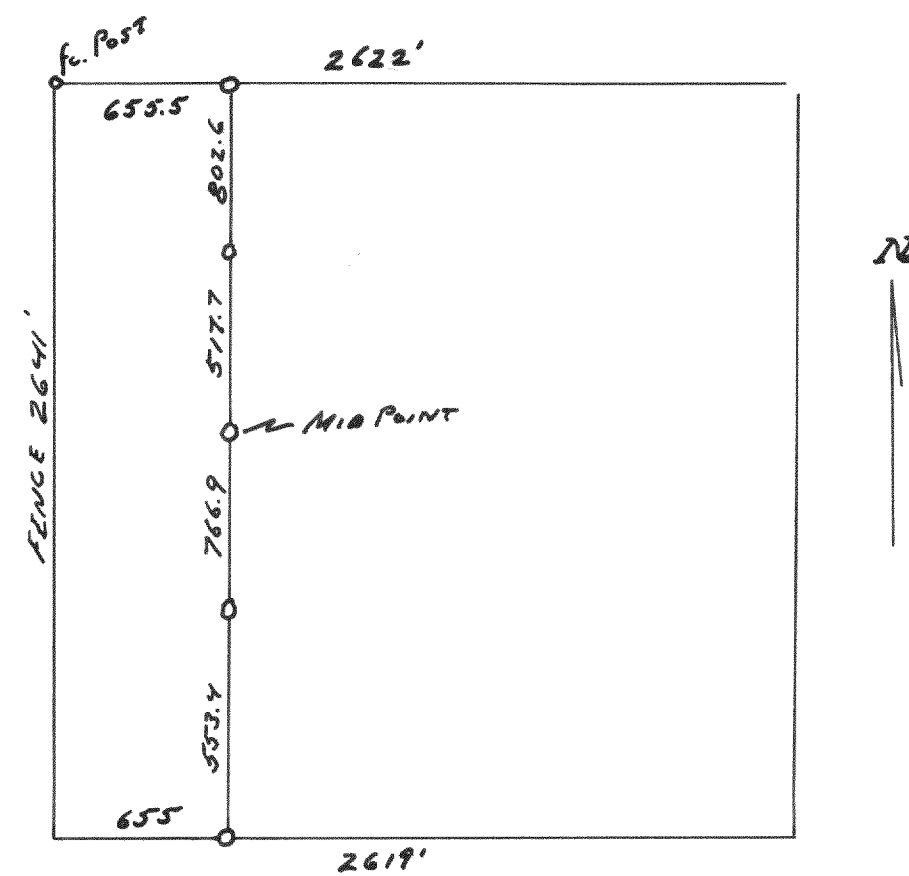


2718

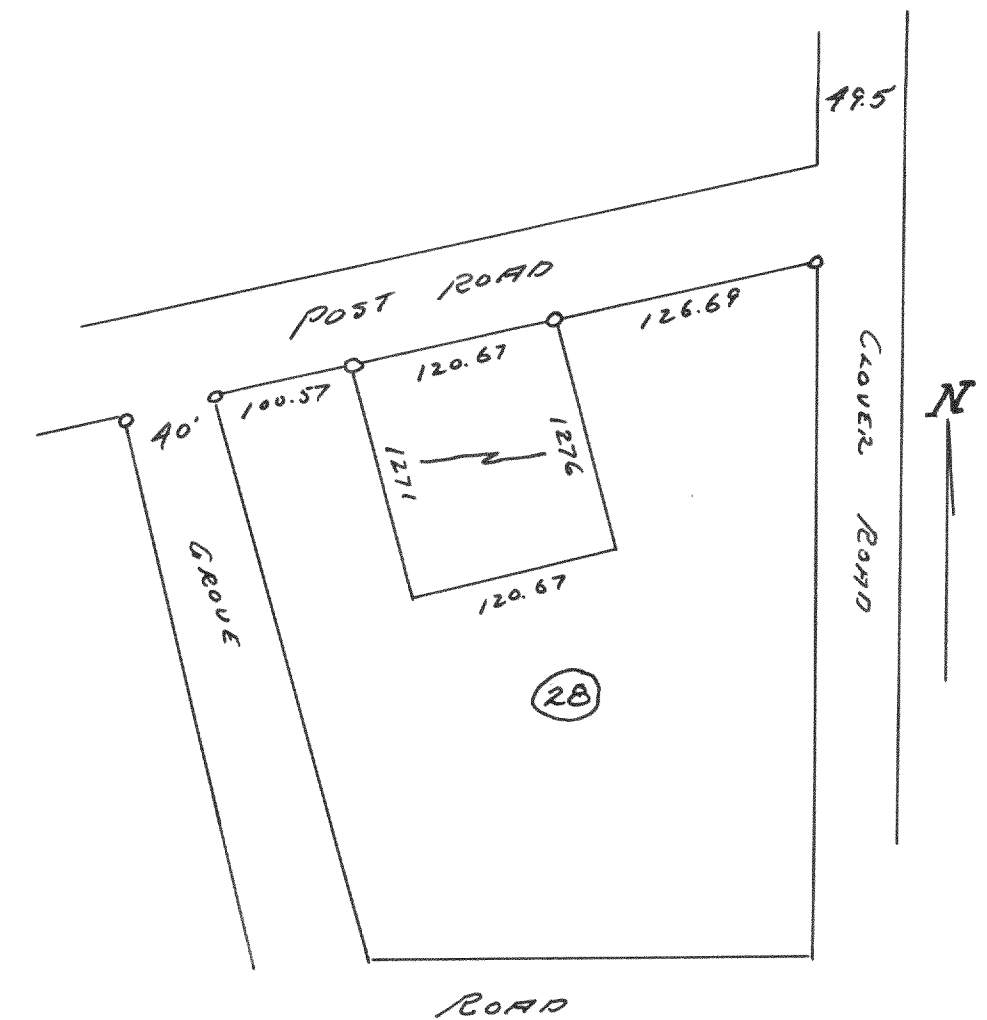

2719

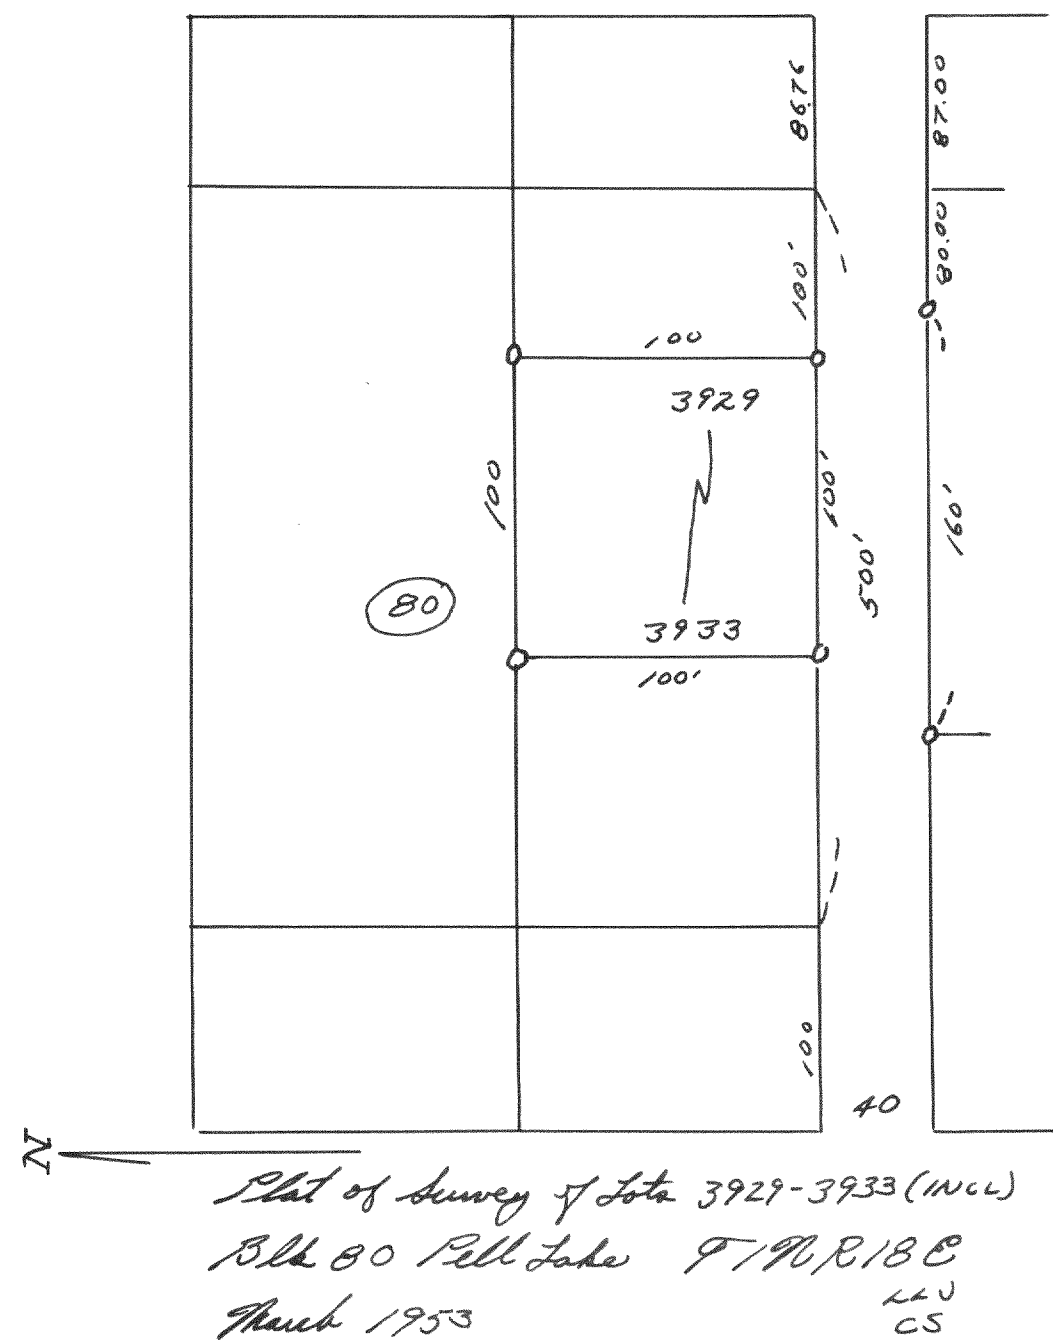

2720

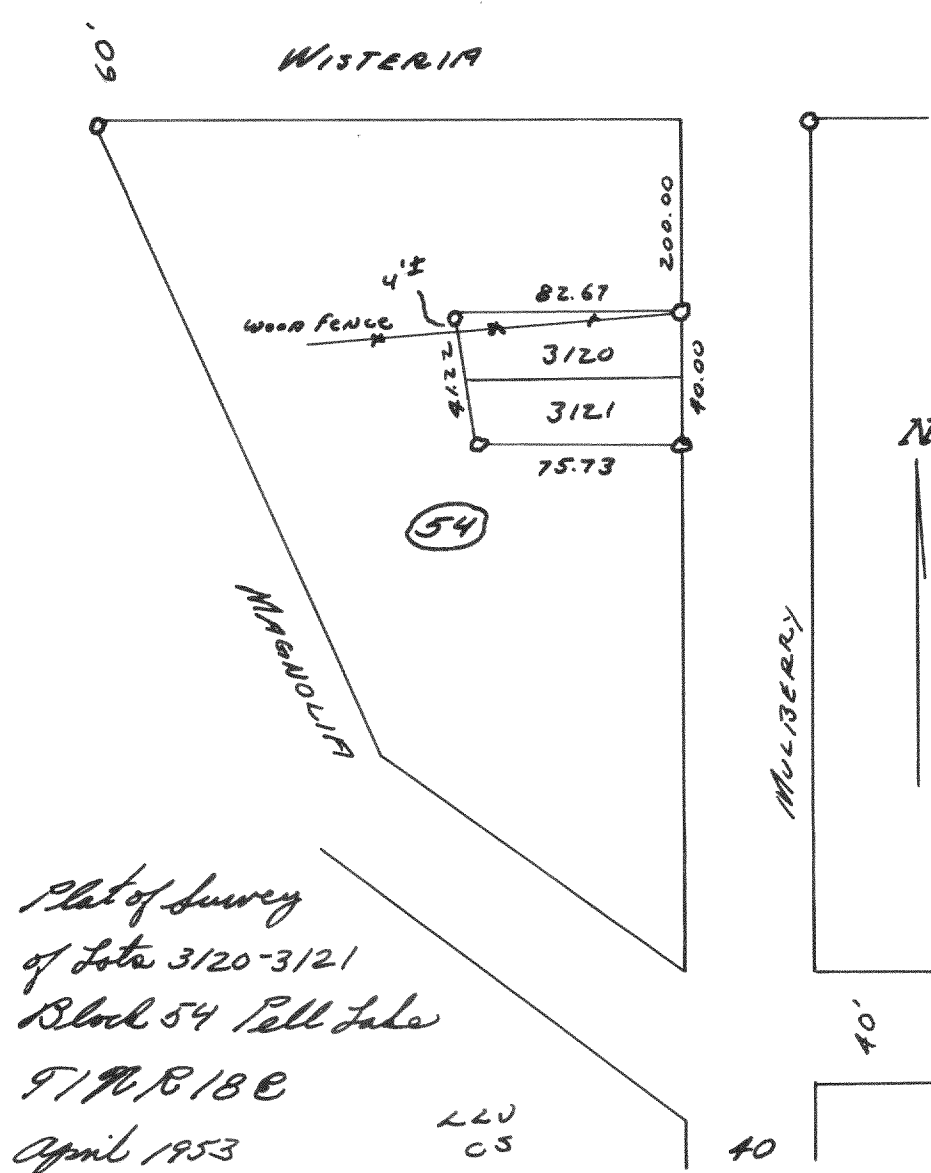

2721

