




N
A
T

#3876

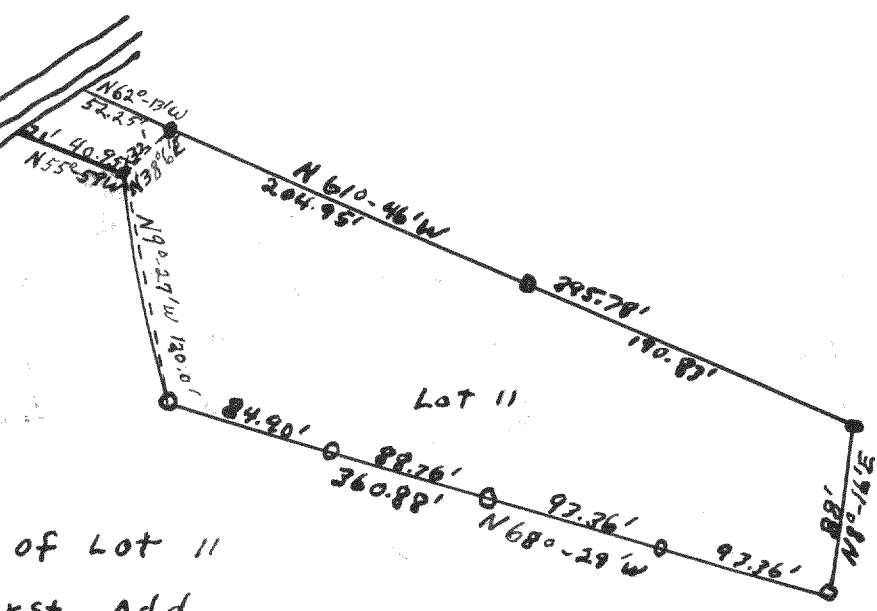

Survey of Lot 11
Birches First Add,
Town of Linn, Wal. Co. Wisc.
Lloyd L. Jensen
County Surveyor

~~#~~ 3877

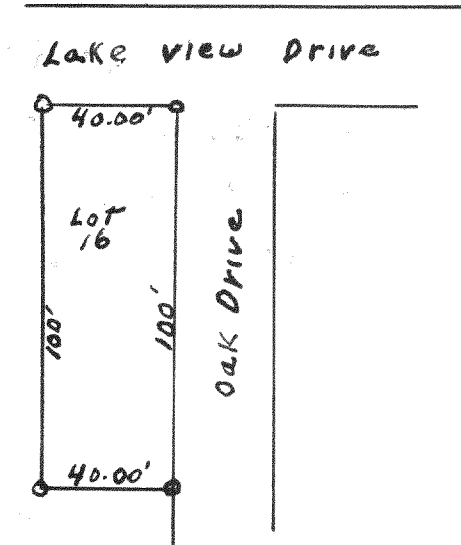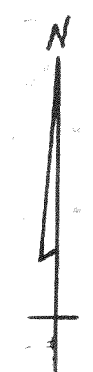


Survey of Lot 16,
Edge wood Terrace.
T, 1N, R17E Wal. Co. Wis.

Lloyd L. Jensen
County Surveyor

3878

Geneva
Lake

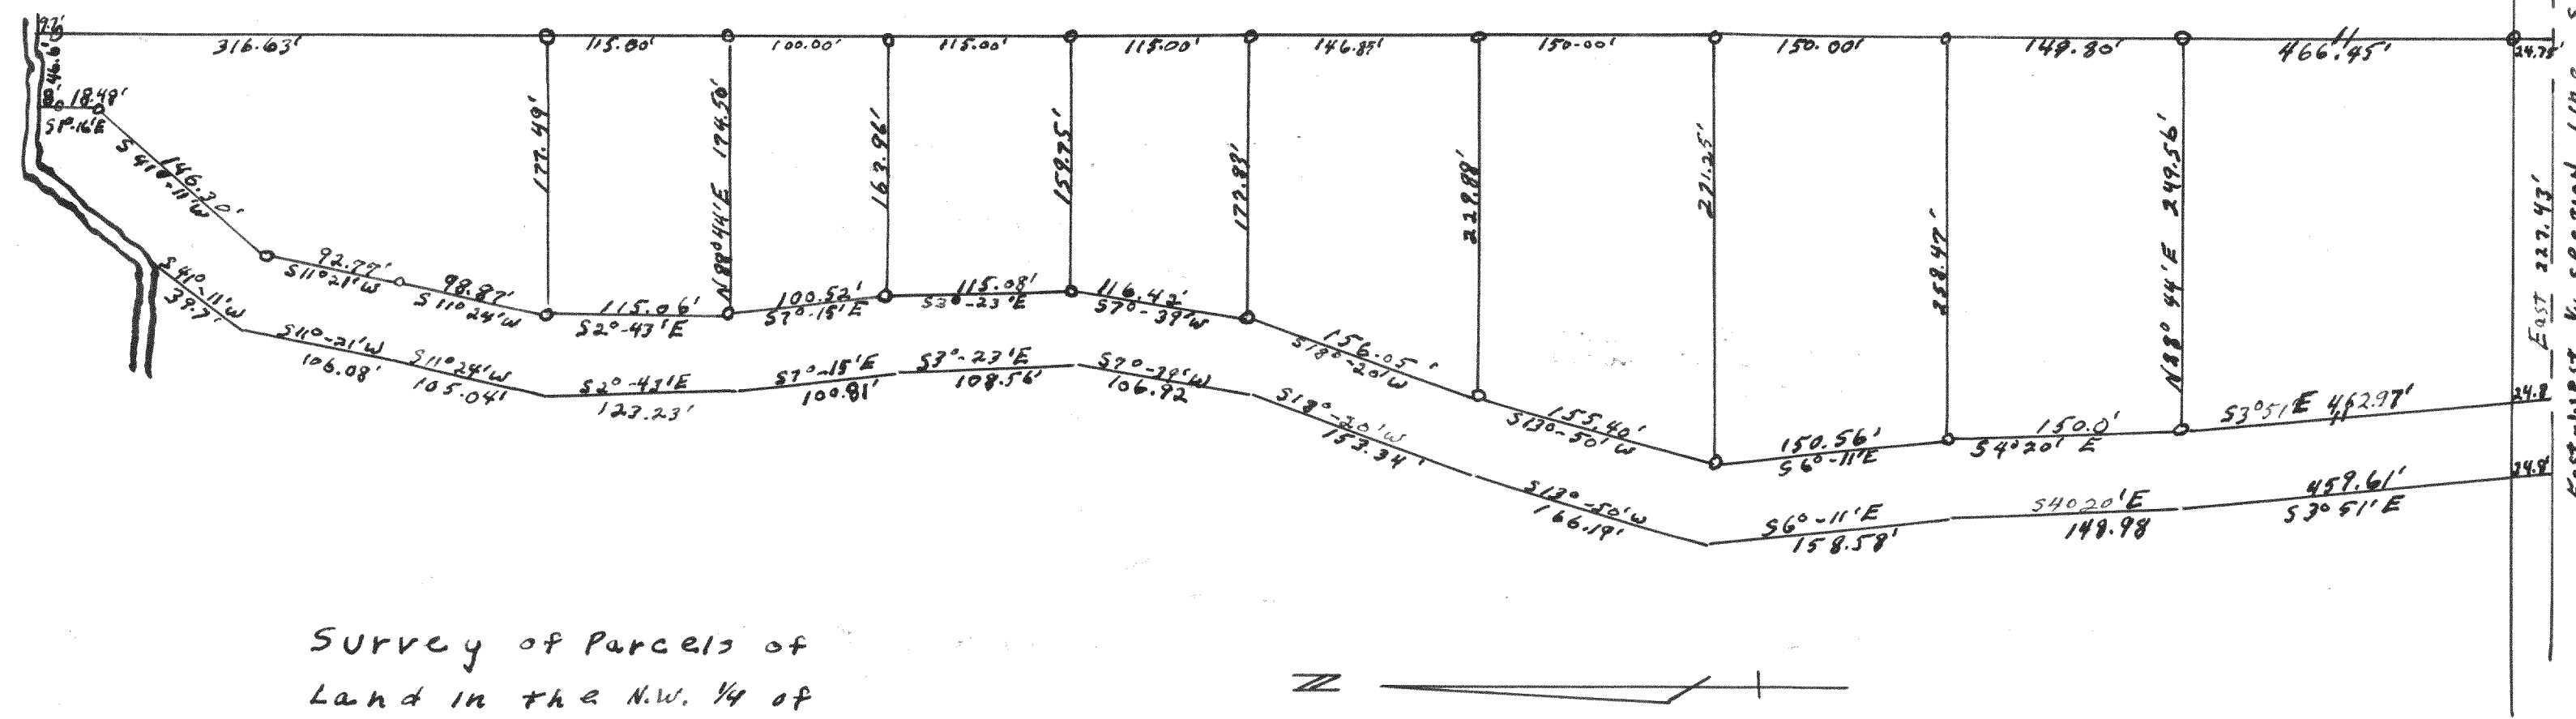

SURVEY of PARCELS of
Land in the N.W. 1/4 of
SECTION 18, T14N, R17E, W1A1,
CO. WISC.

Lloyd L. Jensen
County Surveyor

