


#3879

PLAT OF SURVEY OF
A PARCEL OF LAND LOCATED IN THE SE $\frac{1}{4}$ OF
THE NE $\frac{1}{4}$ OF SECTION 26, T2N, R17E,
WALWORTH COUNTY, WISCONSIN.

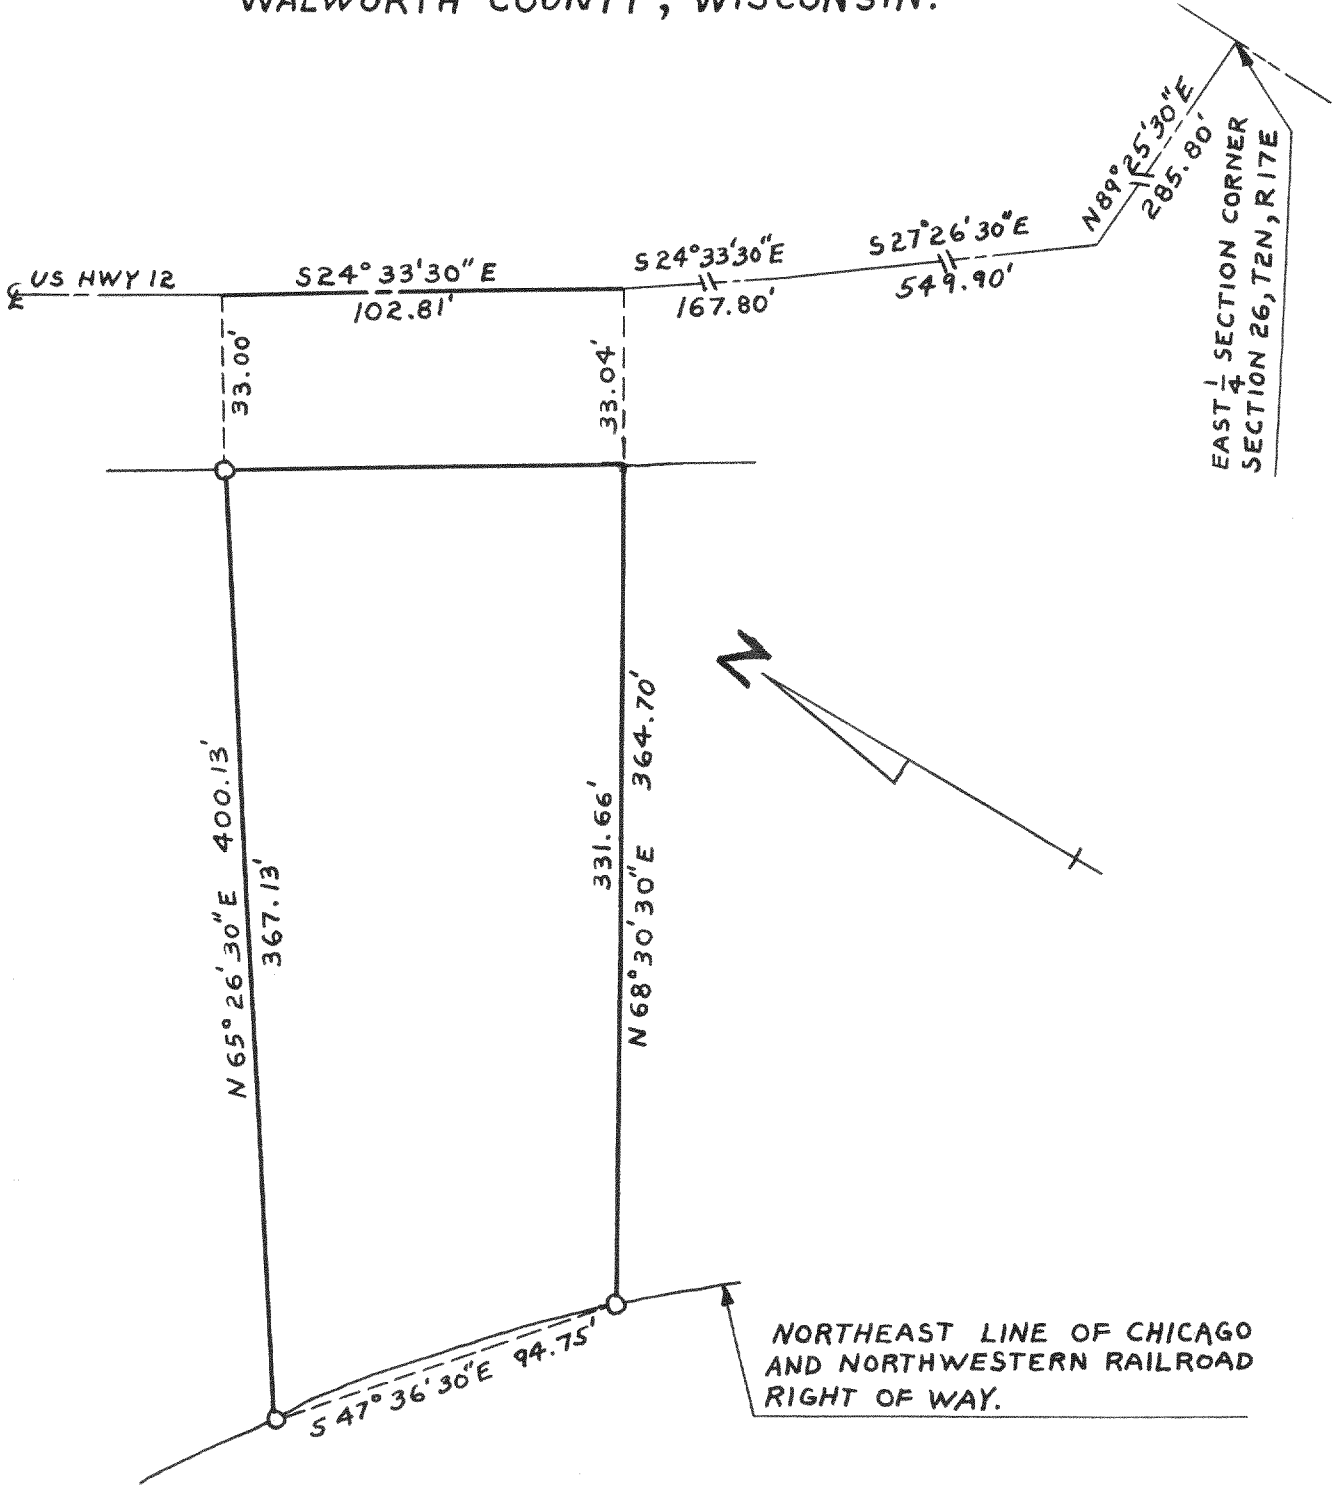


APRIL, 1960

Lloyd S. Jensen
COUNTY SURVEYOR

#3880

PLAT OF SURVEY OF
A PARCEL OF LAND LOCATED IN THE SW $\frac{1}{4}$
OF THE NE $\frac{1}{4}$ OF SECTION 35, T1N, R18E,
GENOA CITY, WALWORTH COUNTY, WISCONSIN.

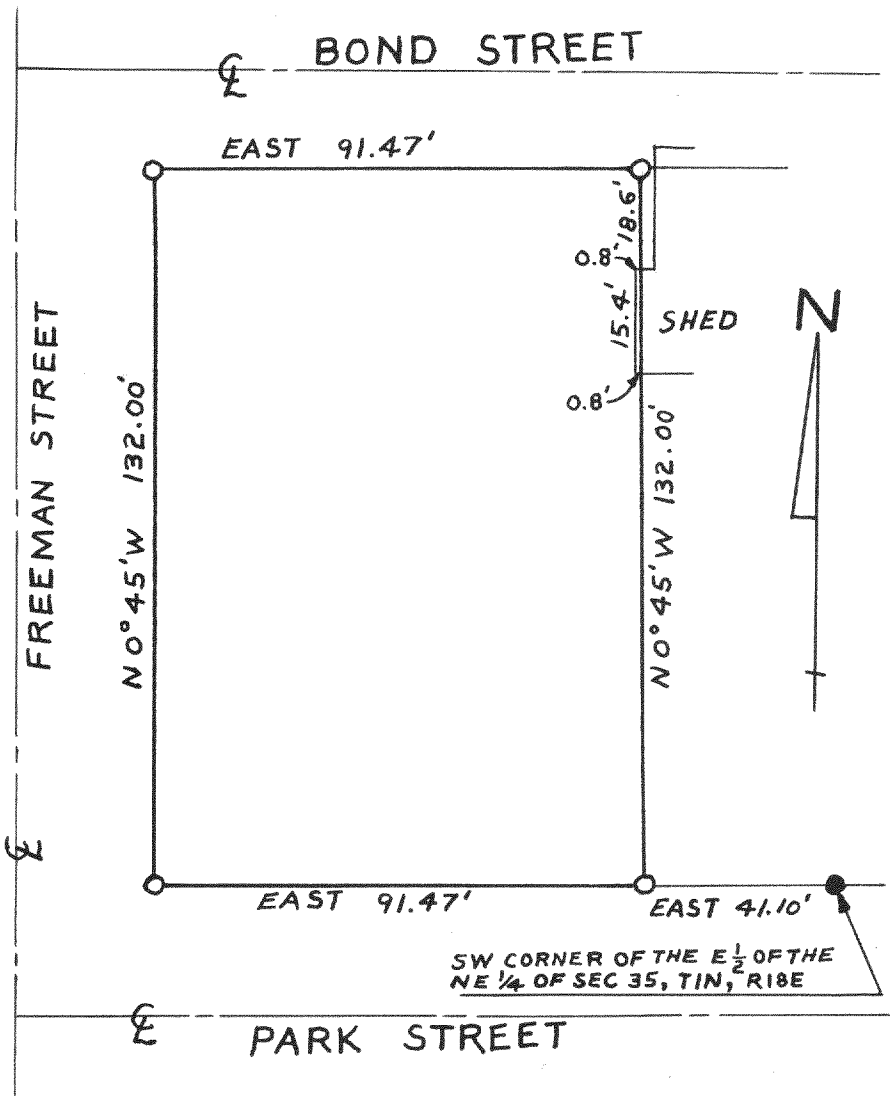


MAY, 1960

Lloyd S. Jensen
COUNTY SURVEYOR

#3881

PLAT OF SURVEY OF
A PARCEL OF LAND LOCATED IN THE SOUTHEAST $\frac{1}{4}$
OF THE SOUTHEAST $\frac{1}{4}$ OF SECTION 33, T2N, R17E,
WALWORTH COUNTY, WISCONSIN.

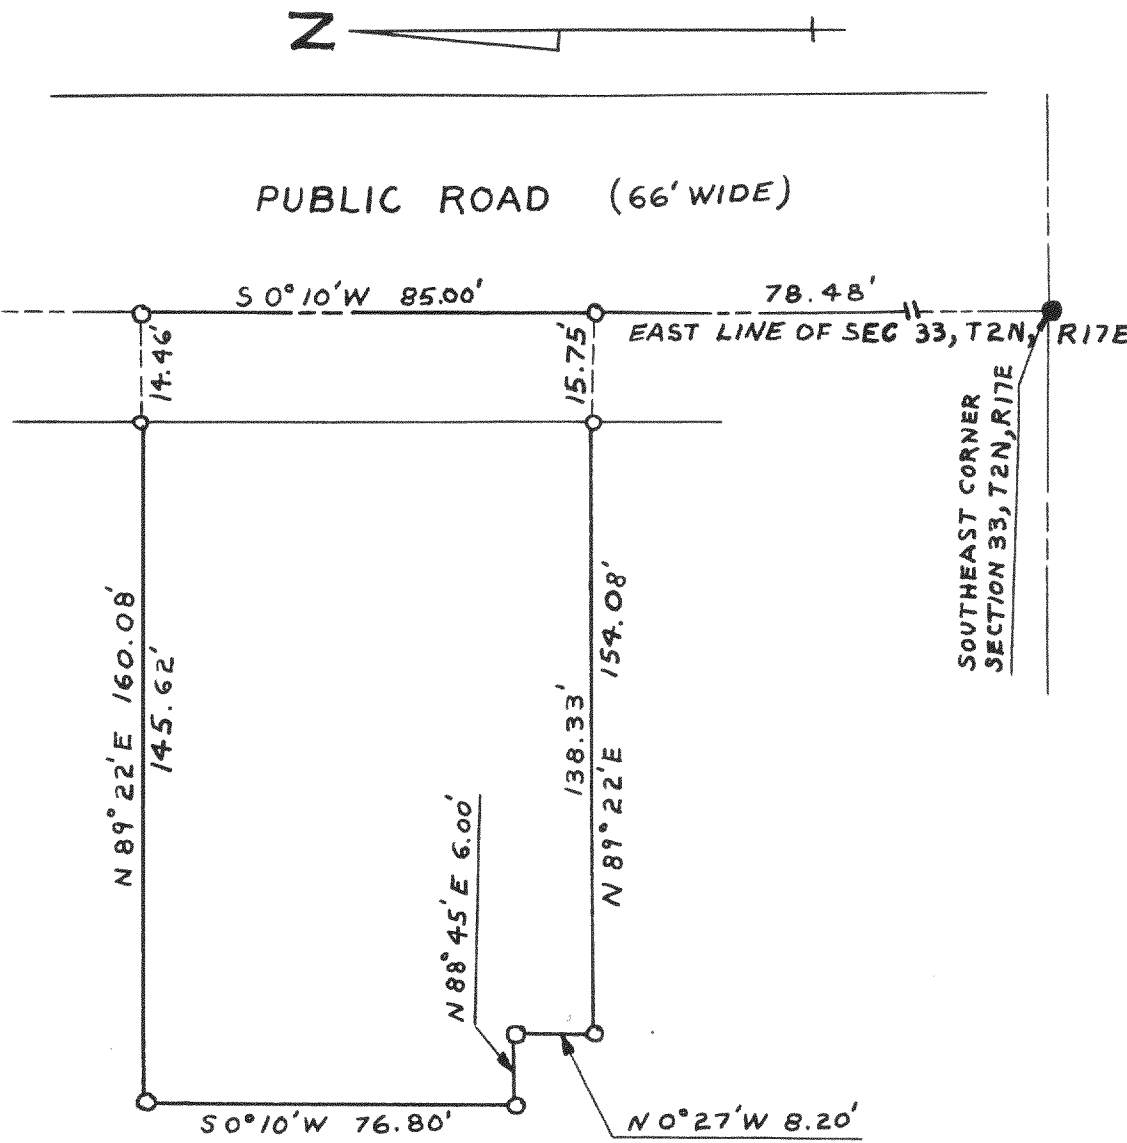

APRIL, 1960

Lloyd S. Jensen
COUNTY SURVEYOR