


#3882

PLAT OF SURVEY OF

A PARCEL OF LAND LOCATED IN THE NE $\frac{1}{4}$ OF
SECTION 35, T2N, T17E, CITY OF LAKE
GENEVA, WALWORTH COUNTY, WISCONSIN.

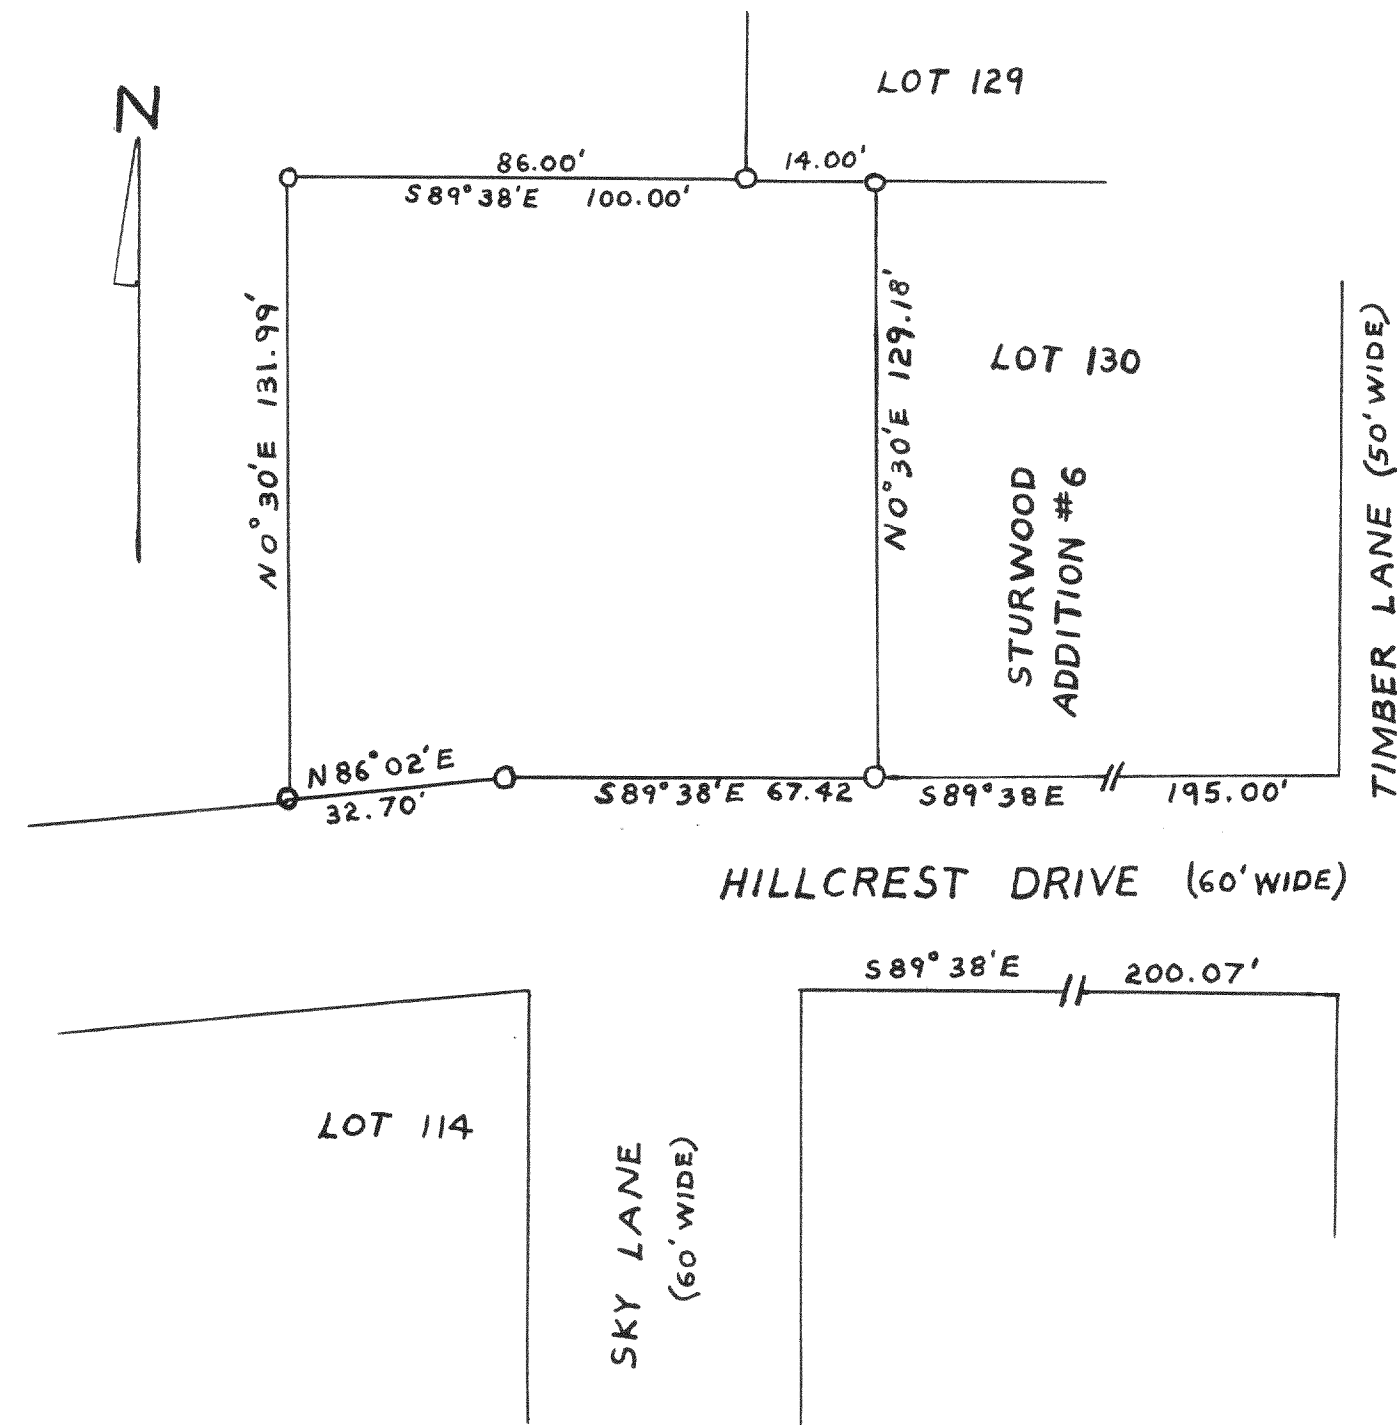


FEBRUARY, 1961

Lloyd L. Jensen
COUNTY SURVEYOR

#3883

PLAT OF SURVEY OF

LOT 8, ORIGINAL CEDAR POINT PARK,
VILLAGE OF WILLIAMS BAY, WALWORTH
COUNTY, WISCONSIN.

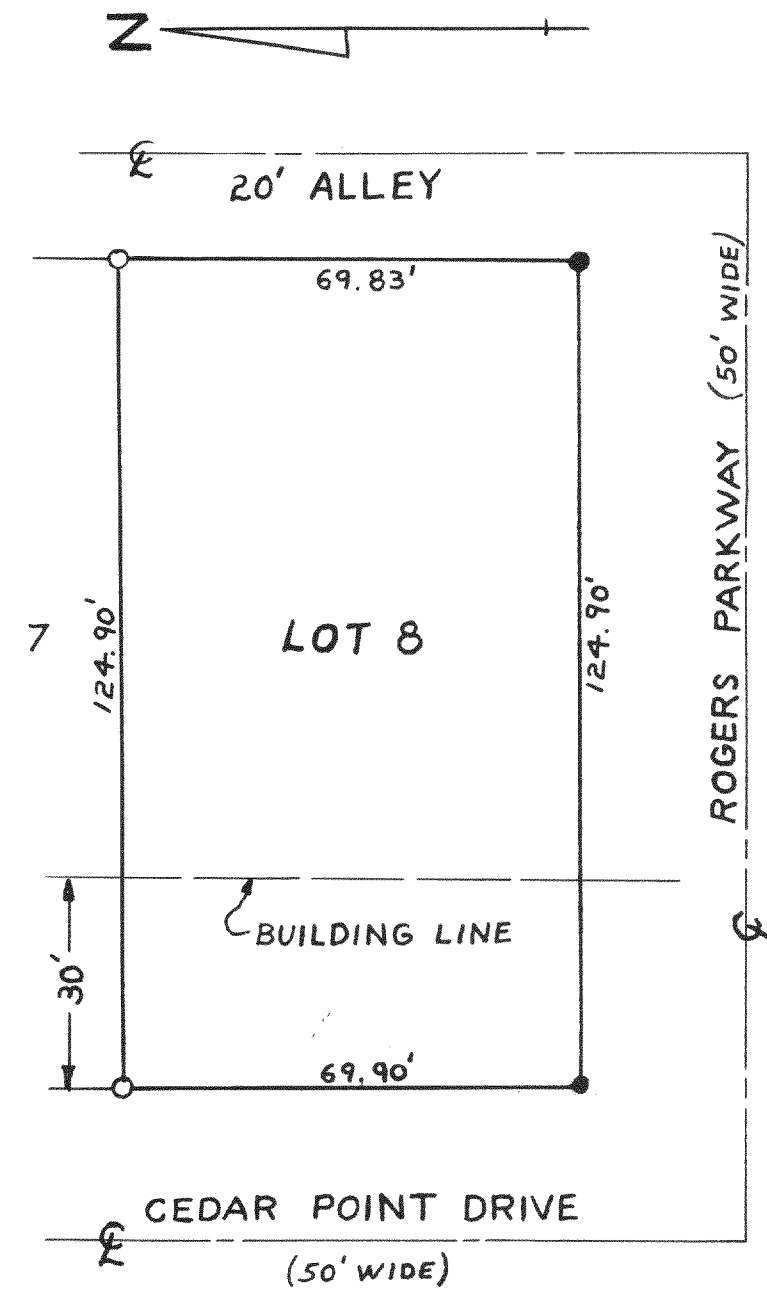


MARCH, 1960

Lloyd Jensen
COUNTY SURVEYOR

#3884

PLAT OF SURVEY OF

LOT 13, ORIGINAL CEDAR POINT PARK,
VILLAGE OF WILLIAMS BAY, WALWORTH
COUNTY, WISCONSIN.

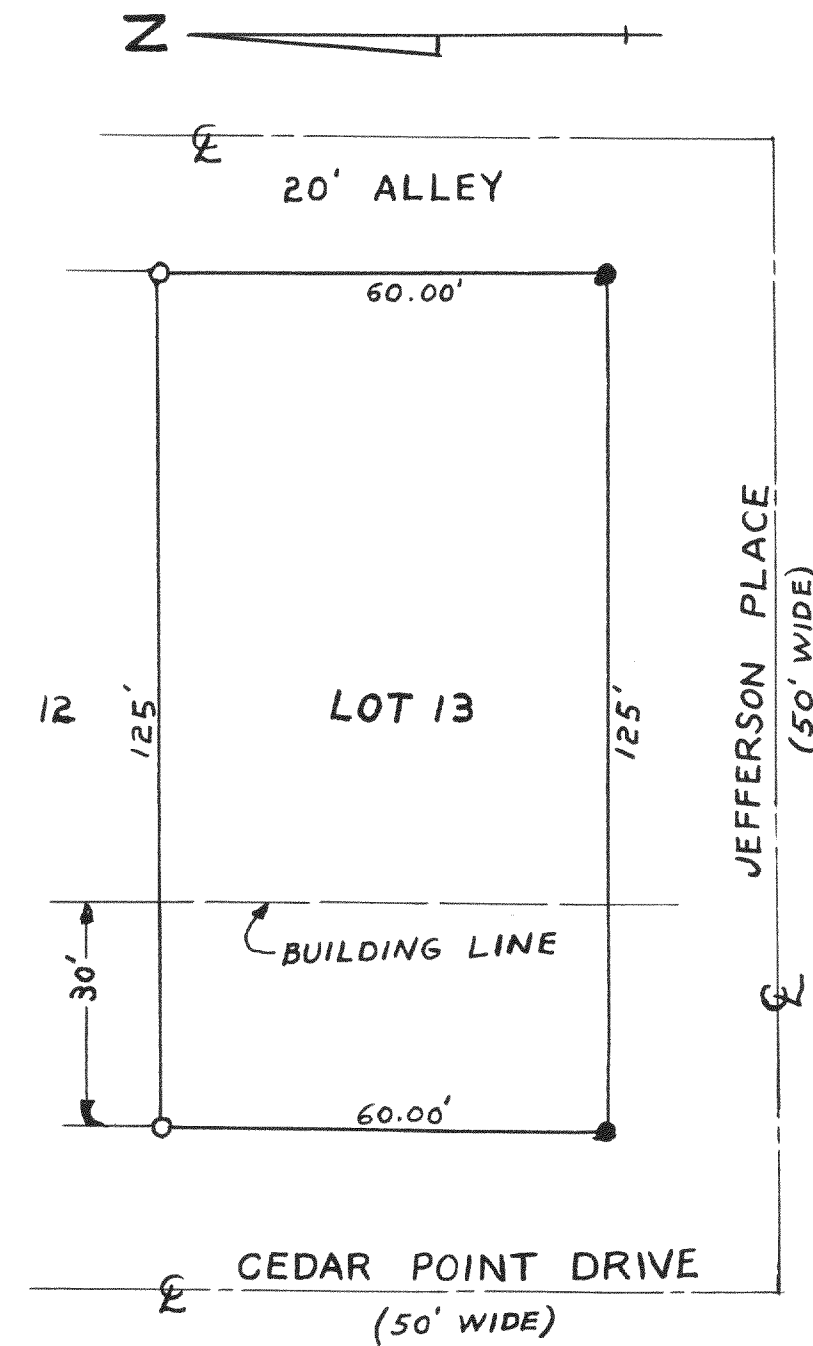

MARCH, 1960

Lloyd L Jensen
COUNTY SURVEYOR