



#3899

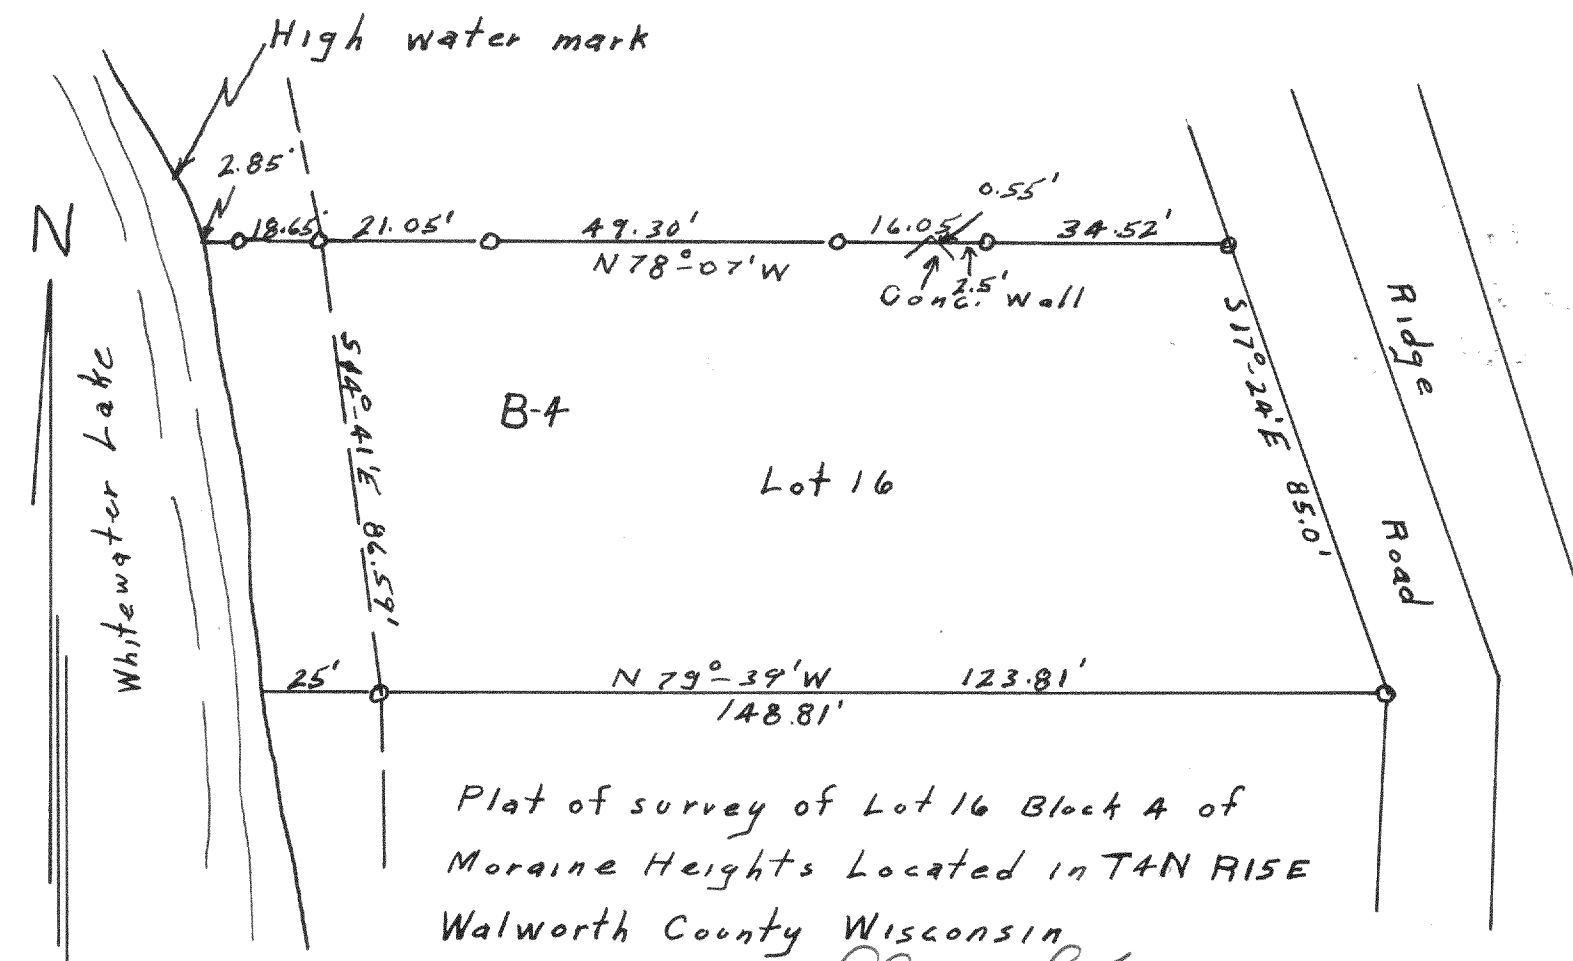

Plat of survey of Lot 16 Block 4 of
Moraine Heights Located in TAN RISE
Walworth County Wisconsin

Aug. 1960

Lloyd L Jensen
County Surveyor

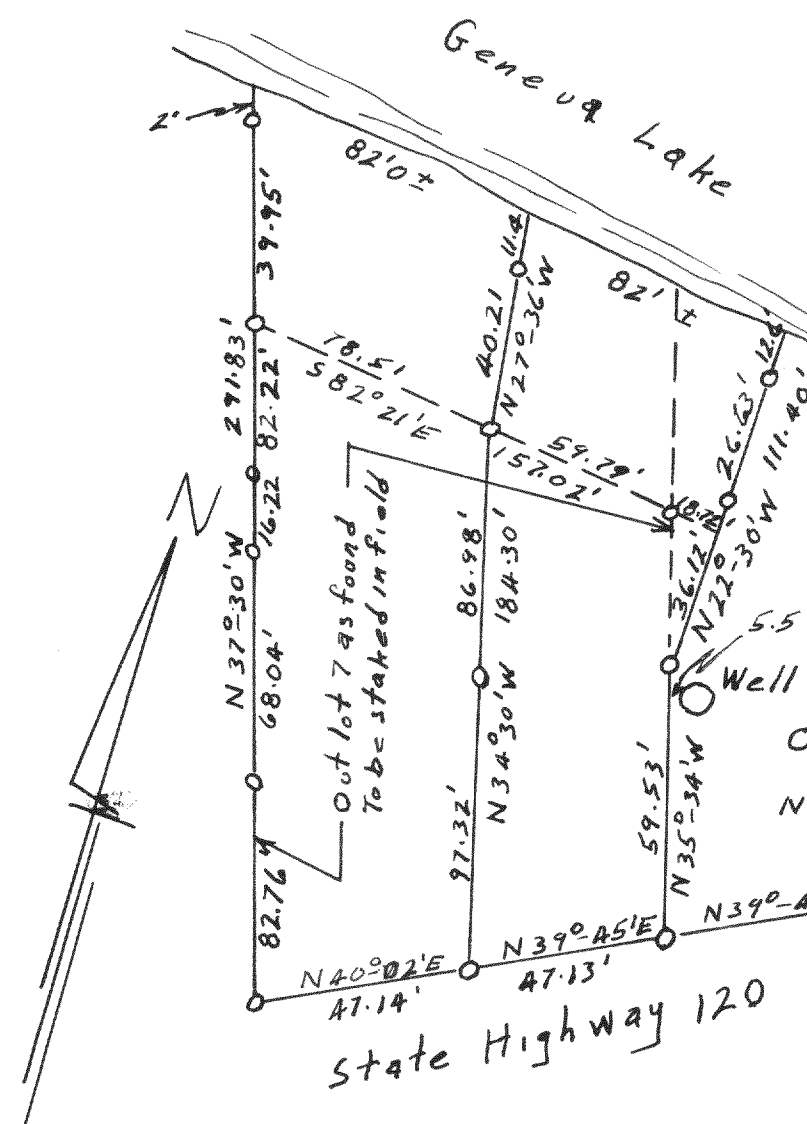~~A~~ 3901

Plat of survey of A parcel
of land being part of
Assessors Plat "B" located
in the NW 1/4 of Section 12
T1N R10E Walworth County
Wisconsin Sep. 1960


Lloyd L Jensen
County Surveyor

Oct 1st 8

N 14°-10'E 2.32

NE corner of Outlot 8
as found to be staked
in the field


3900

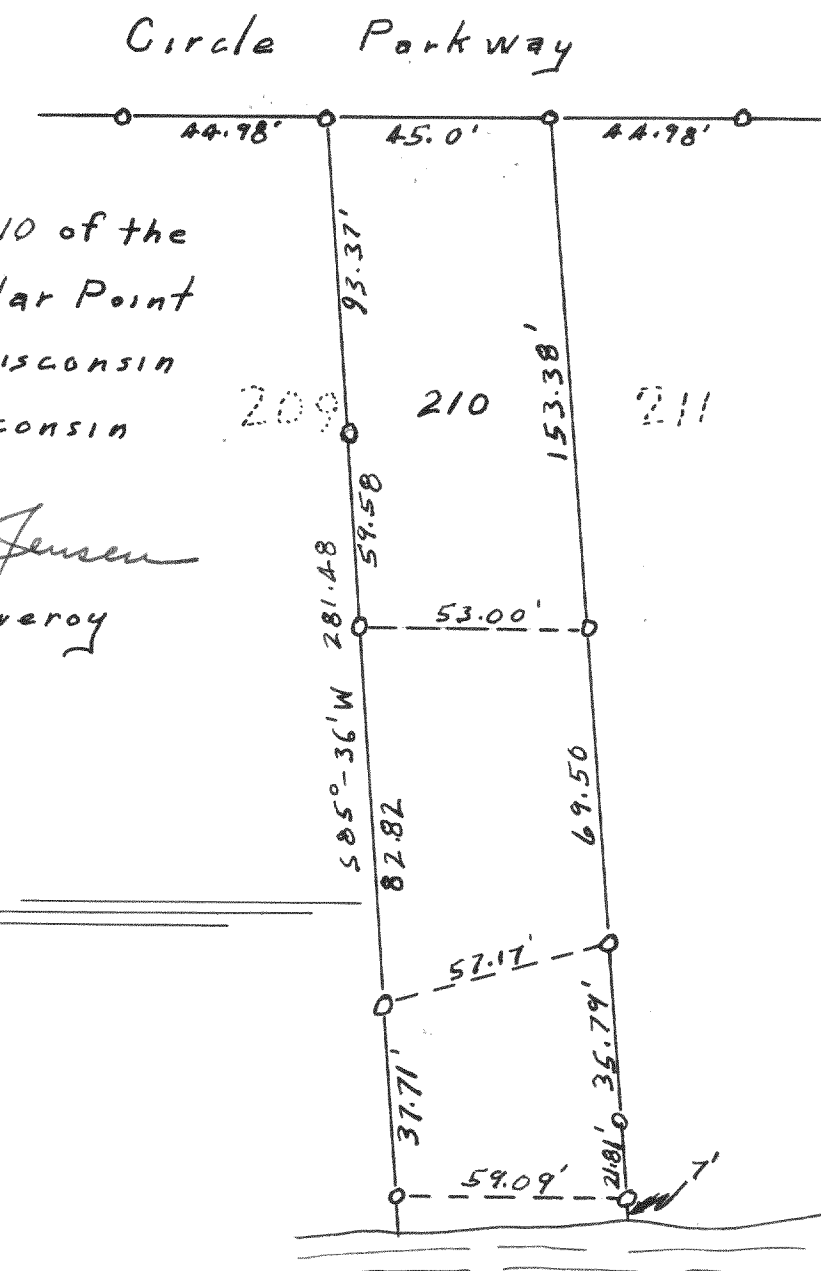

Plat of survey of lot 210 of the
Third Addition to Cedar Point
Park, William Bay Wisconsin
Walworth County Wisconsin
March 1960

Lloyd L Jensen
County Surveyor

3902

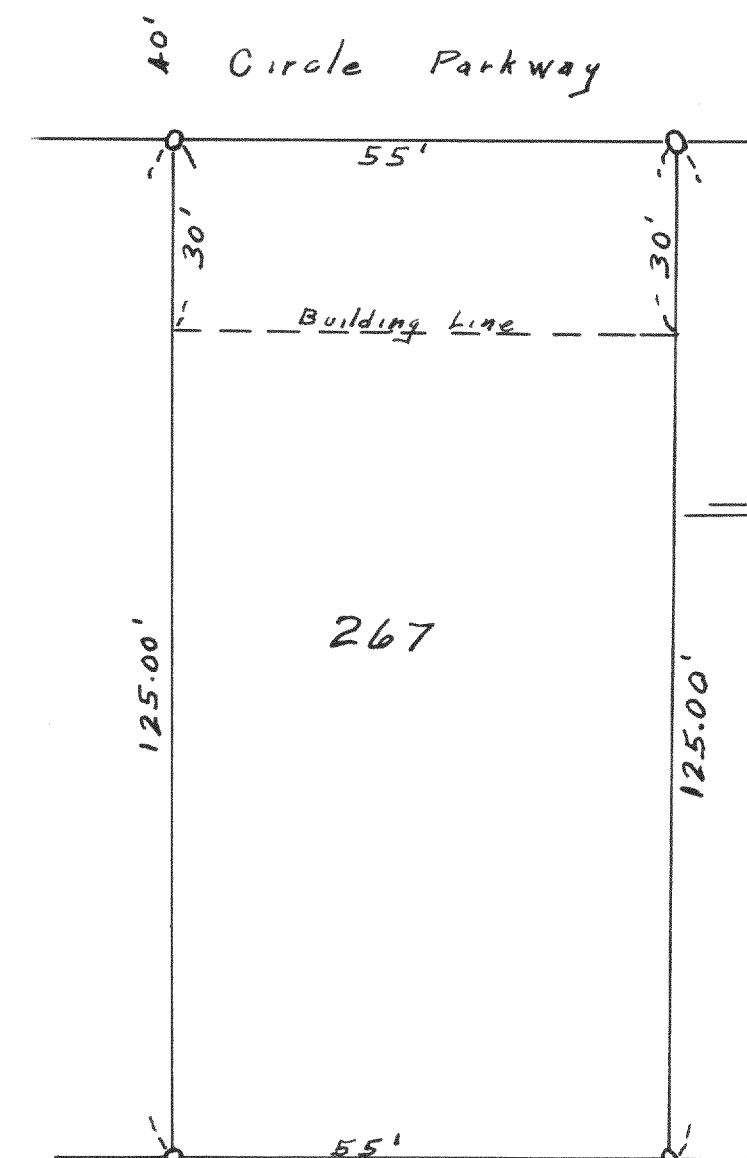

Plat of survey of lot 267
of the Third Addition of
Cedar Point Park Subd.
Williams Bay Wisconsin
Walworth County Wisconsin
April 1960

Lloyd L. Jensen
County Surveyor