



#3903

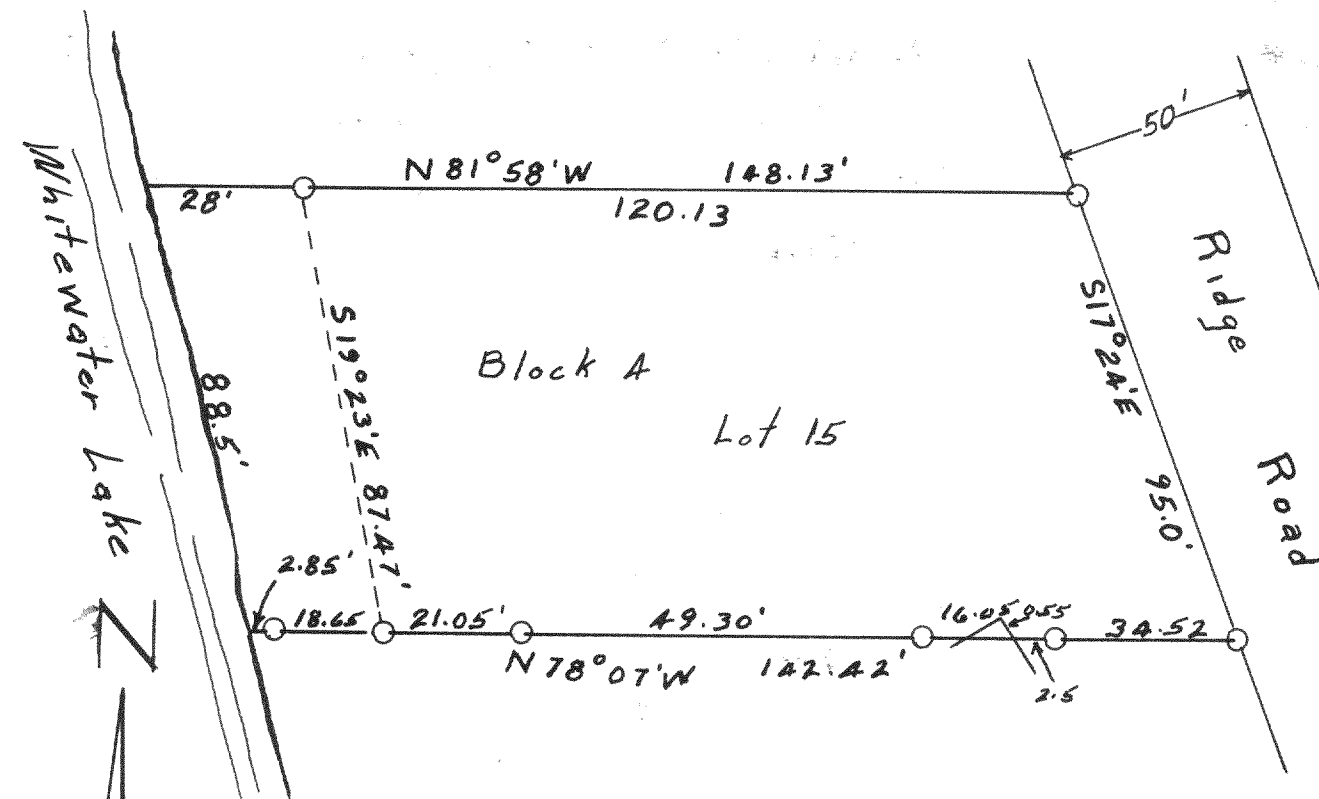

Plat of survey of Lot 15
Block A Moraine Heights
Located in TAN RISE
Walworth County Wisconsin
Aug. 1960

Lloyd L. Jensen
County Surveyor


#3905

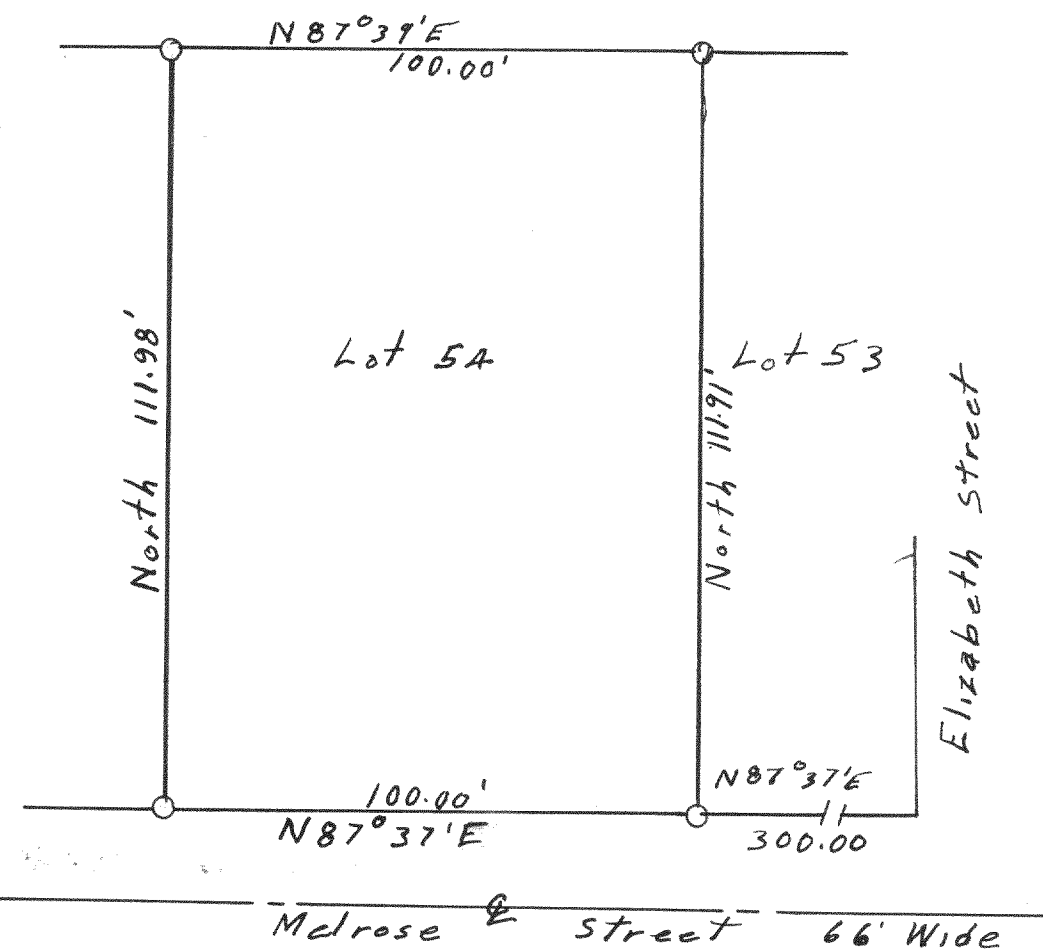

Plat of survey of Lot 54 Westpark
Addition, City of Whitewater,
Walworth County Wisconsin
May 1960

Lloyd L. Jensen
County Surveyor


#3906

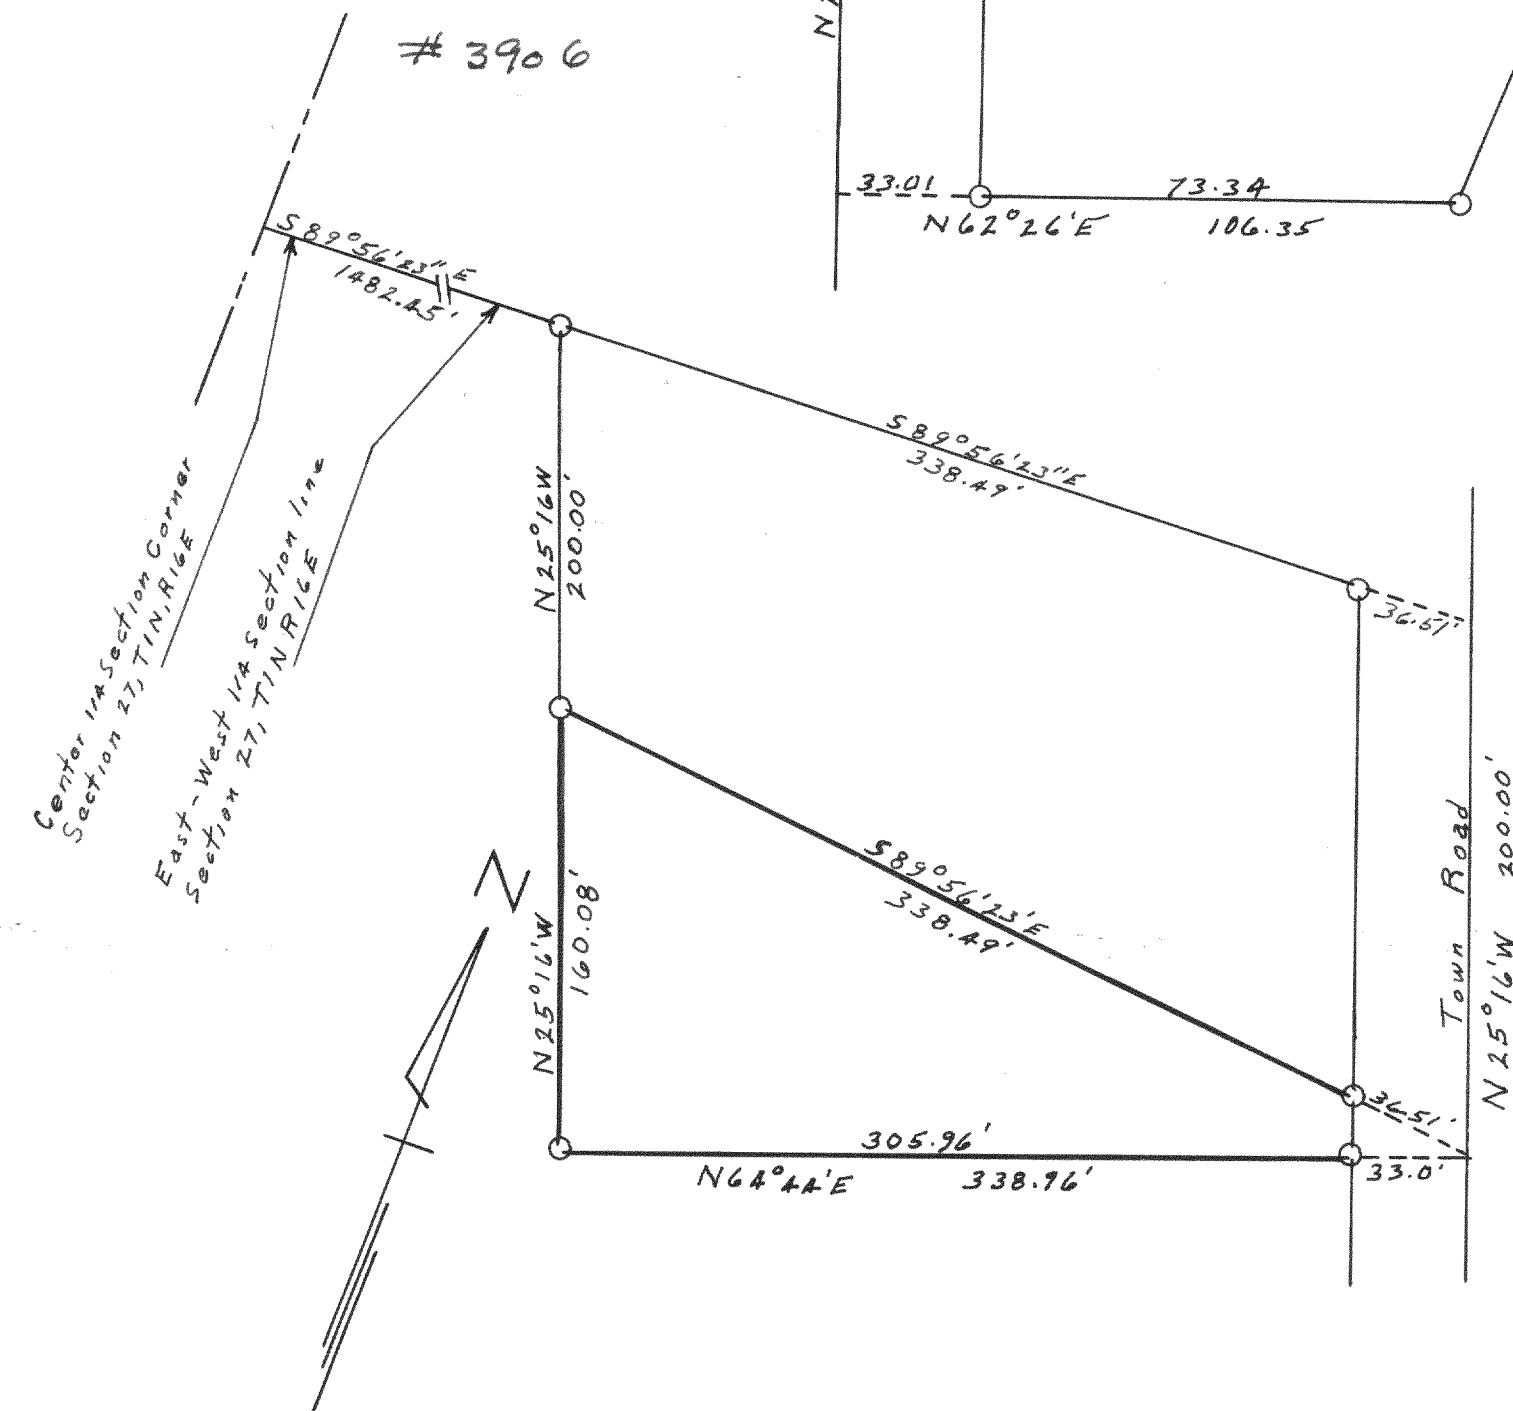

Plat of survey of a parcel of land
located in the NE 1/4 of the SE
1/4 Section 27, TIN RISE
Walworth County, Wisconsin
May 1960

Lloyd L. Jensen
County Surveyor

#3904

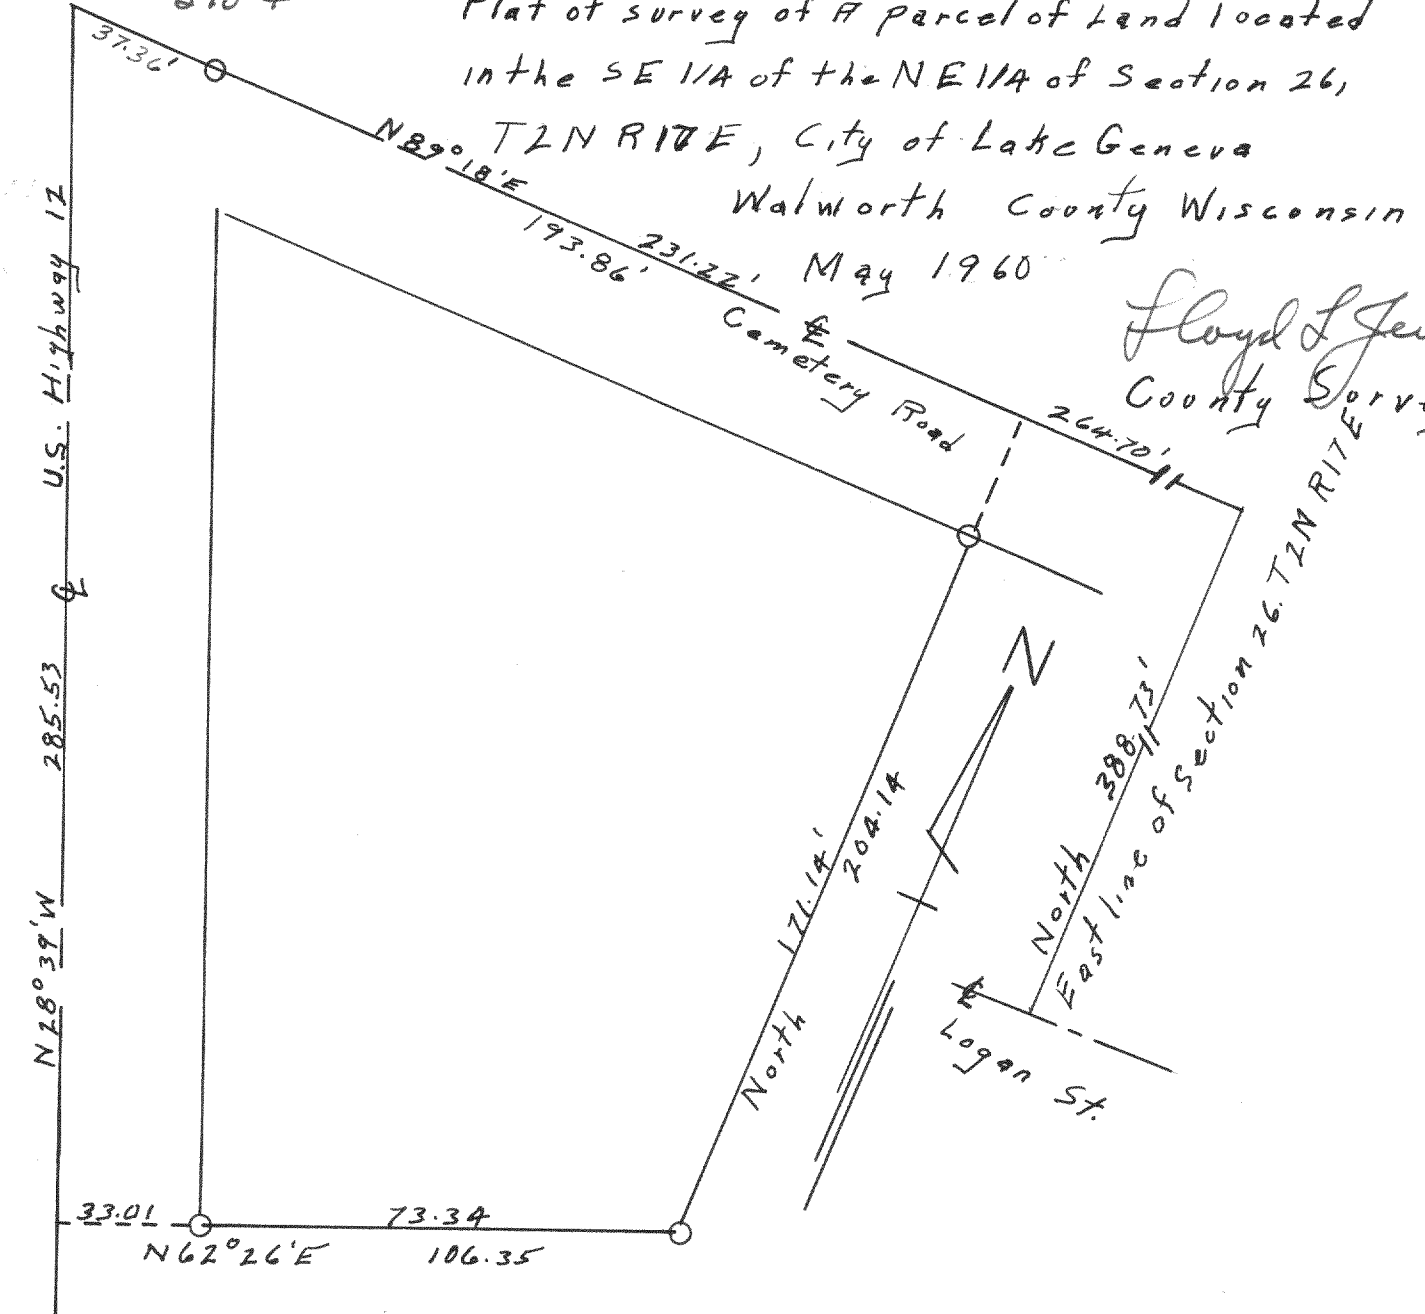

Plat of survey of a parcel of land located
in the SE 1/4 of the NE 1/4 of Section 26,
TAN RISE, City of Lake Geneva
Walworth County Wisconsin
May 1960

Lloyd L. Jensen
County Surveyor