

#3919

PLAT. OF SURVEY OF

A PARCEL OF LAND LOCATED IN GOVERNMENT
LOT 2 (FRACTIONAL SW $\frac{1}{4}$ OF THE SW $\frac{1}{4}$)
OF SECTION 25, T4N, R15E, WALWORTH
COUNTY, WISCONSIN.

#3920


PLAT OF SURVEY OF

LOT 15 AND THE EAST $\frac{1}{2}$ OF LOT 16, BLOCK II,
DELAVER LAKE ASSEMBLY GROUNDS, LOCATED
IN TOWN 2 N, RANGE 16 E, WALWORTH COUNTY,
WISCONSIN.

#3921


PLAT OF SURVEY OF

LOTS 3 AND 4, BLOCK 5, GENEVISTA SUBDIVISION,
IN THE SW $\frac{1}{4}$ OF SECTION 10, T1N, R17E, TOWN OF
LINN, WALWORTH COUNTY, WISCONSIN.

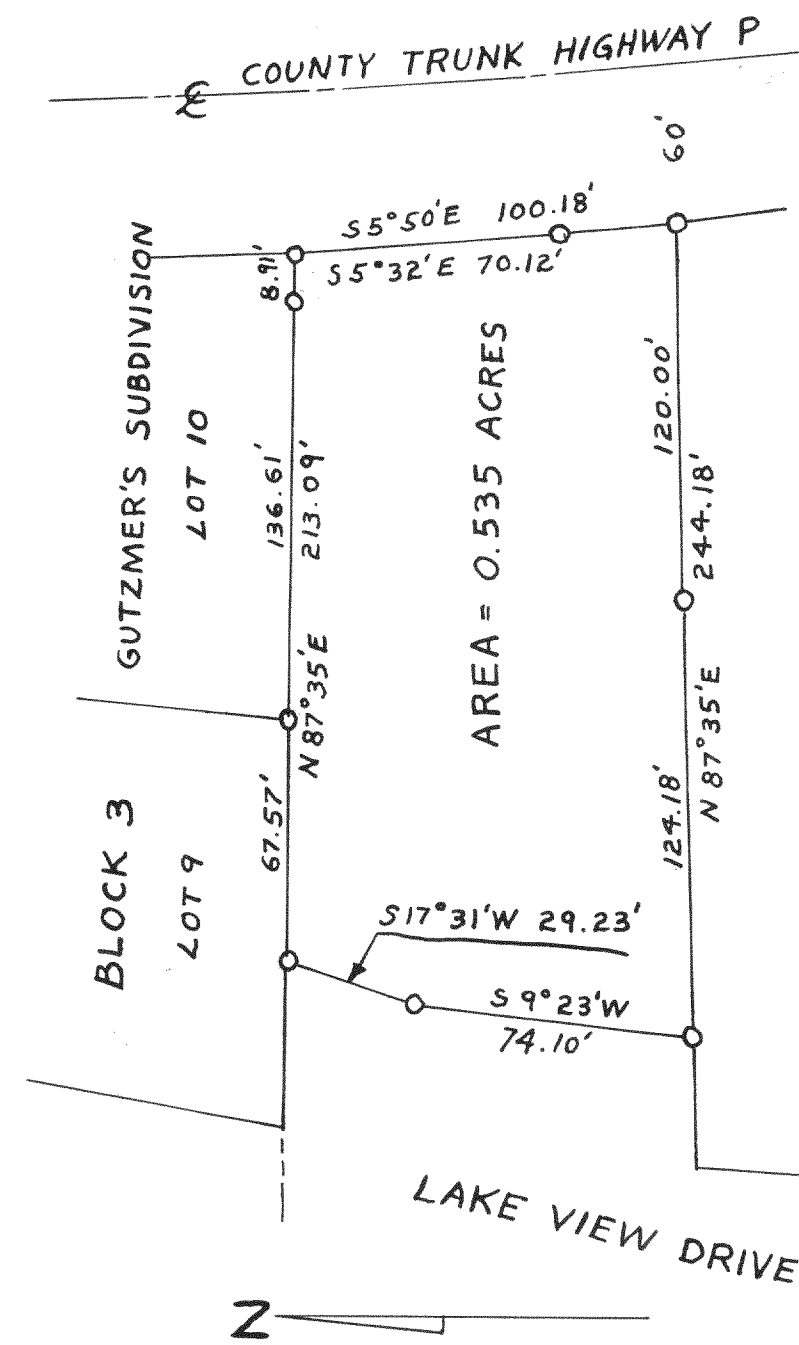


FEBRUARY, 1961

Lloyd S Jensen
COUNTY SURVEYOR

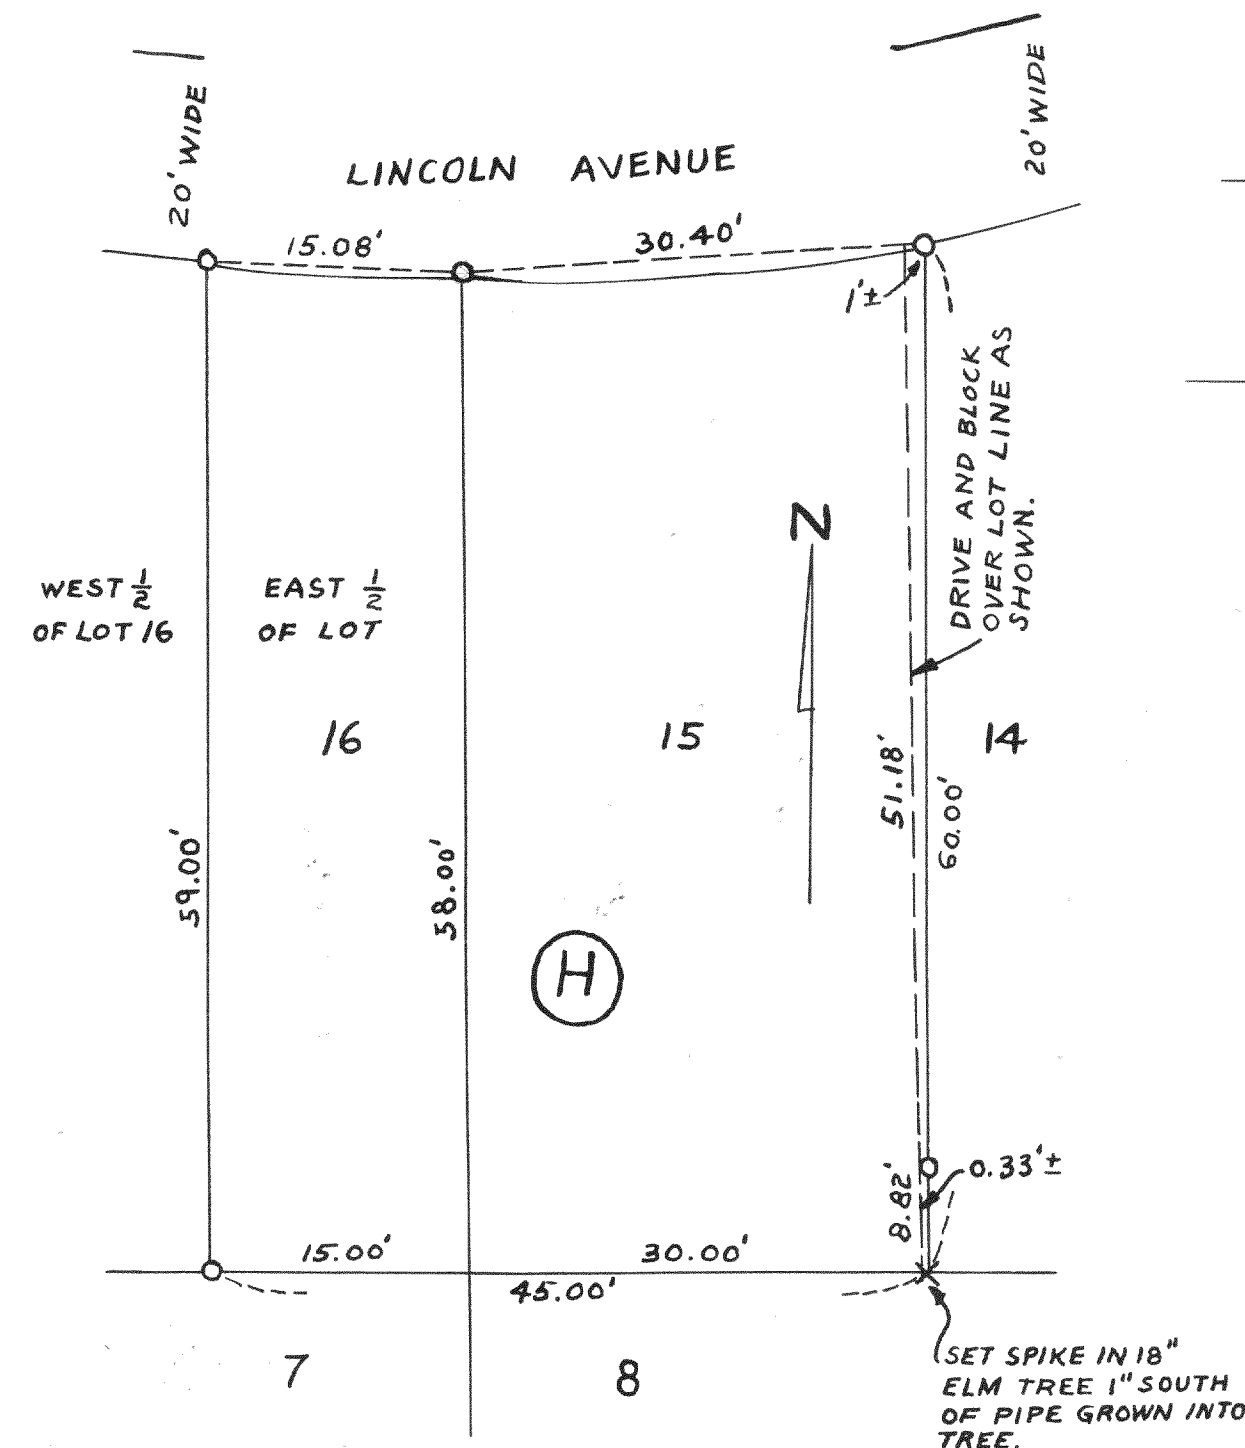

AUGUST, 1960

Lloyd S Jensen
COUNTY SURVEYOR

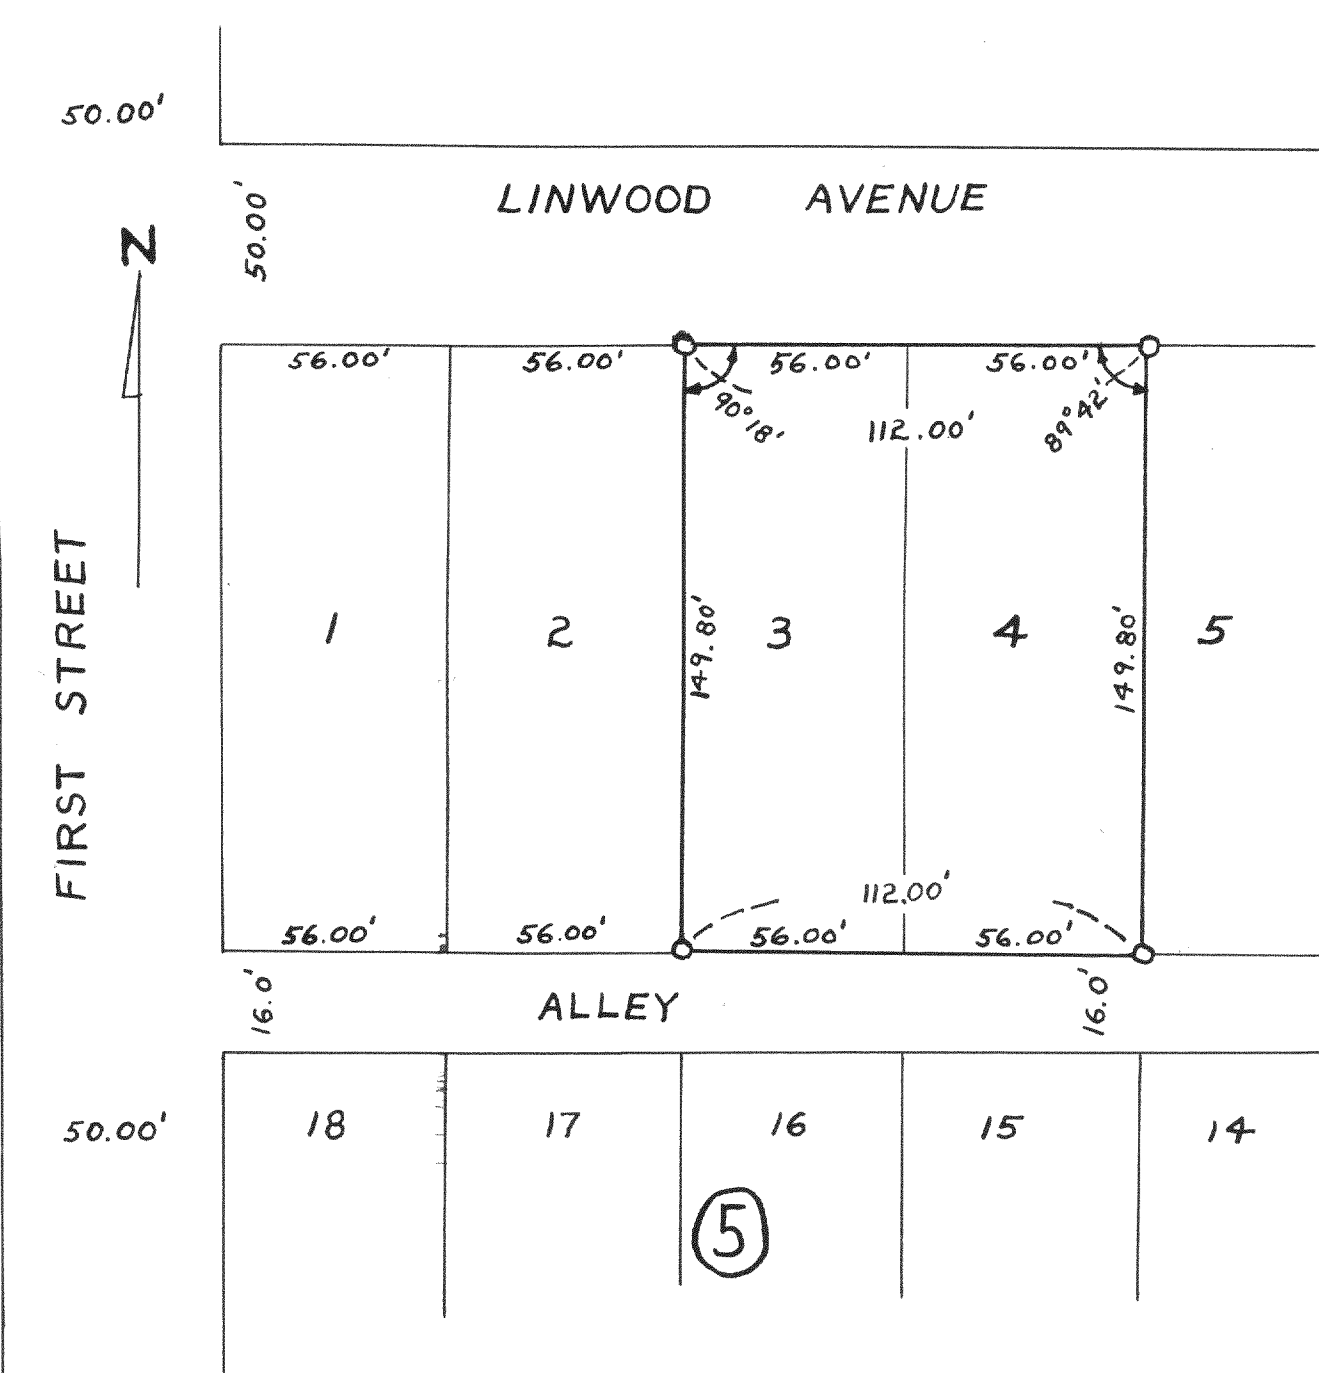

JULY 5, 1960

Lloyd L. Jensen
COUNTY SURVEYOR