


#3922

PLAT OF SURVEY OF
LOT 3, LAKE GENEVA HIGHLANDS, LOCATED
IN SECTION 8, T1N, R17E, WALWORTH COUNTY,
WISCONSIN.

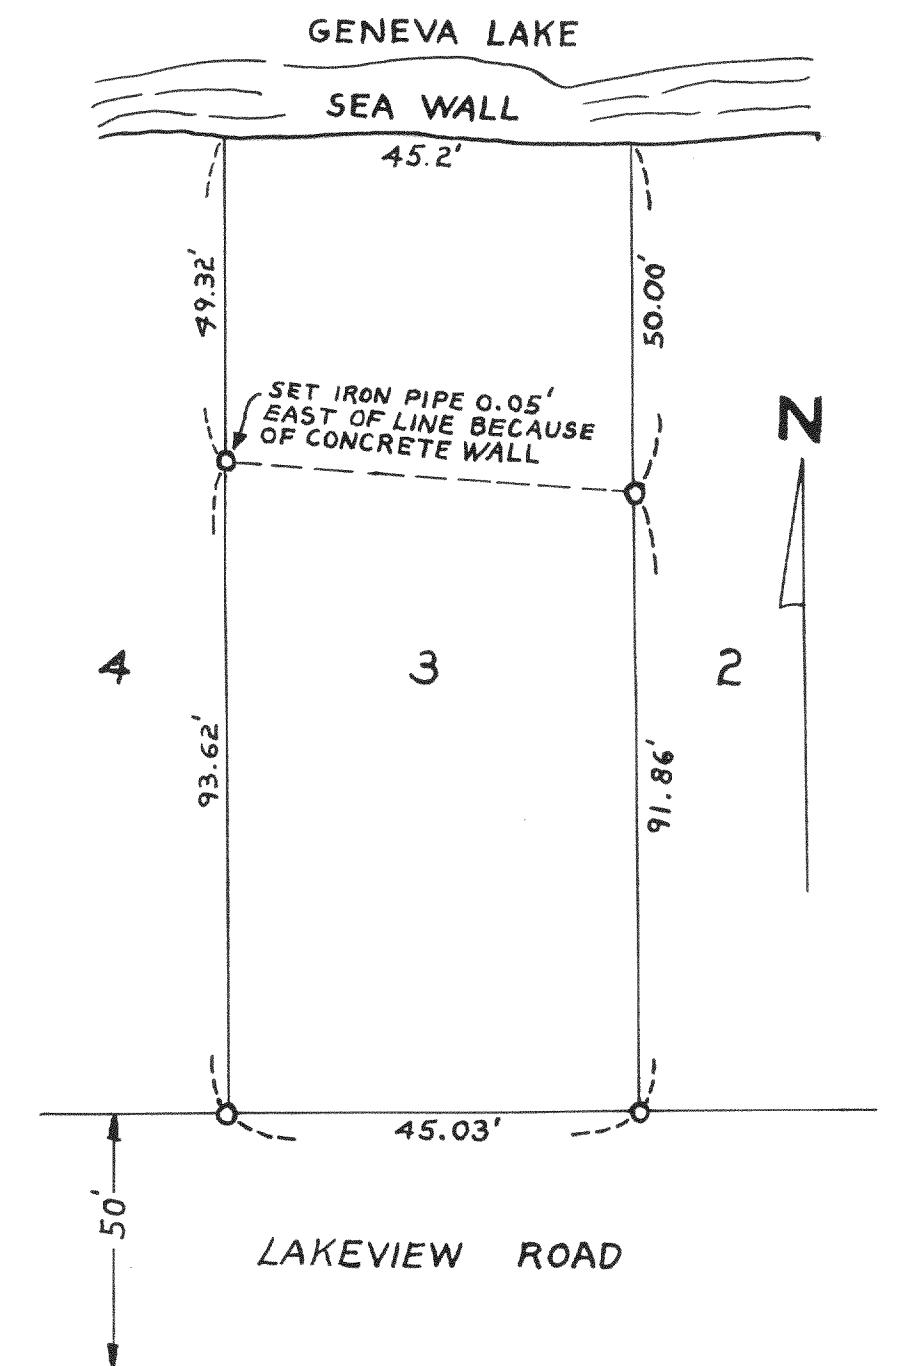


APRIL 21, 1960

Lloyd L. Jensen
COUNTY SURVEYOR

#3923

PLAT OF SURVEY OF
THE SOUTH 105 FEET OF LOT 3, BLOCK 10,
ORIGINAL PLAT OF THE VILLAGE OF EAST TROY,
WALWORTH COUNTY, WISCONSIN.

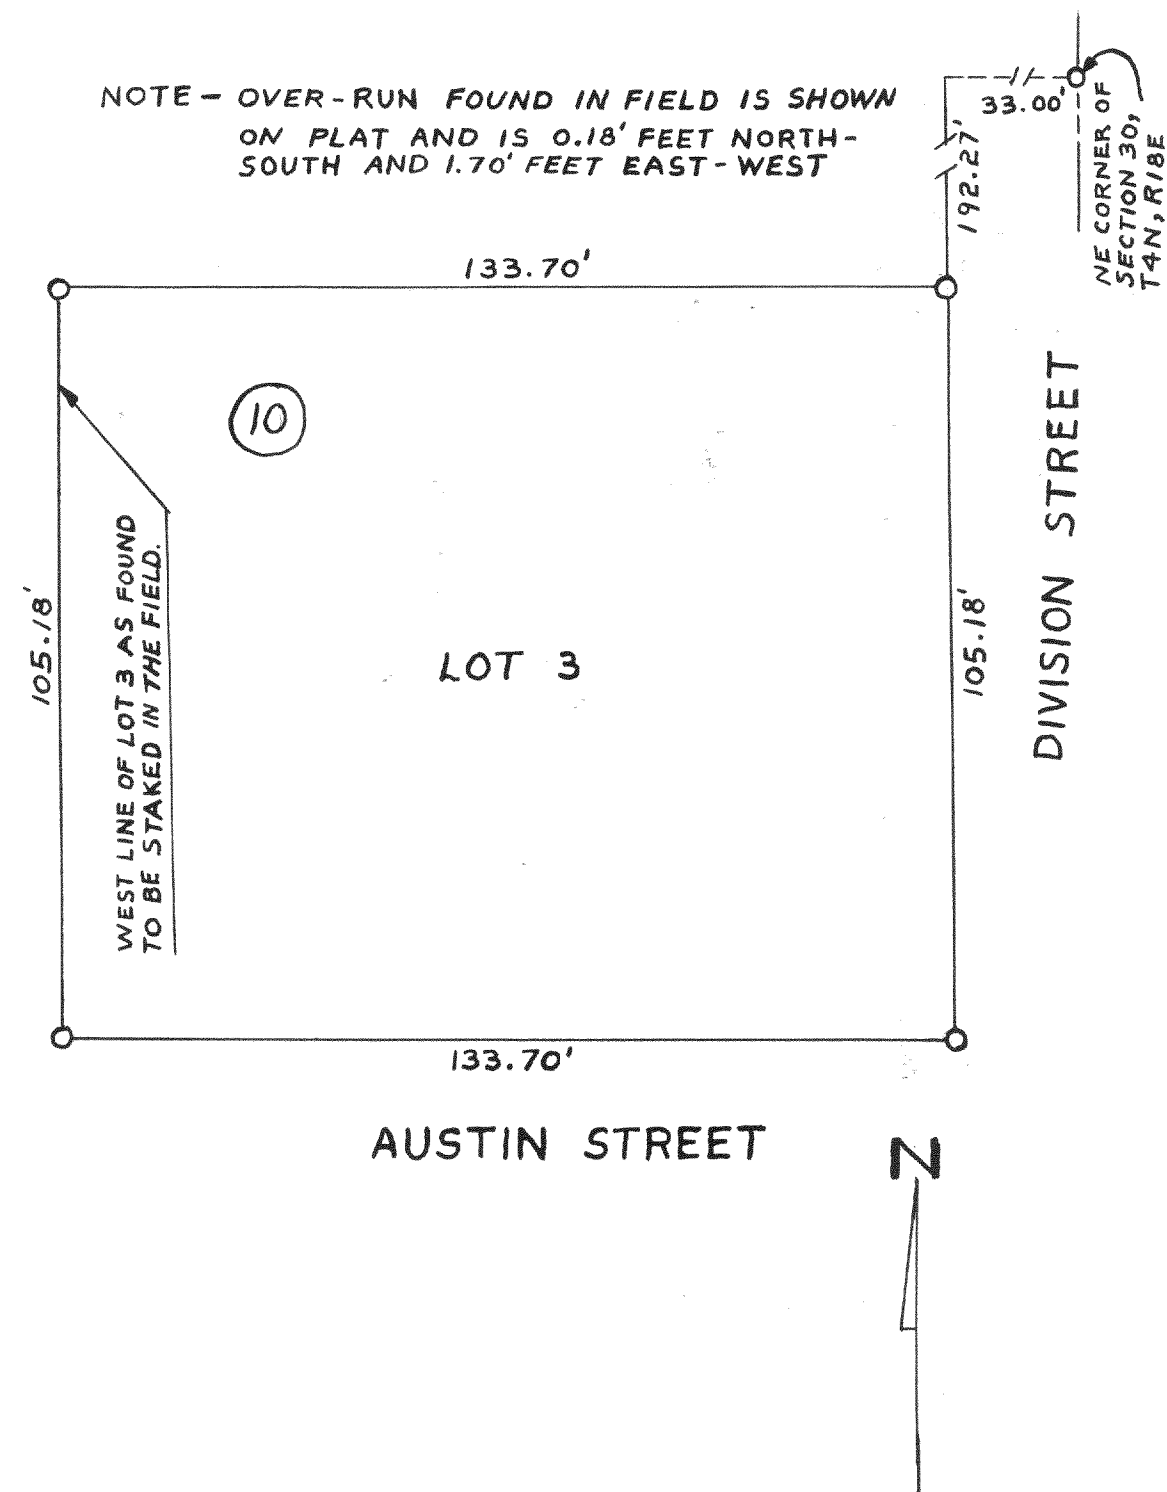


FEBRUARY, 1960

Lloyd L. Jensen
COUNTY SURVEYOR

#3924

PLAT OF SURVEY OF
LOTS 9097 TO 9102, BLOCK 163, LAKE
COMO BEACH, LOCATED IN T2N, R17E,
WALWORTH COUNTY, WISCONSIN.

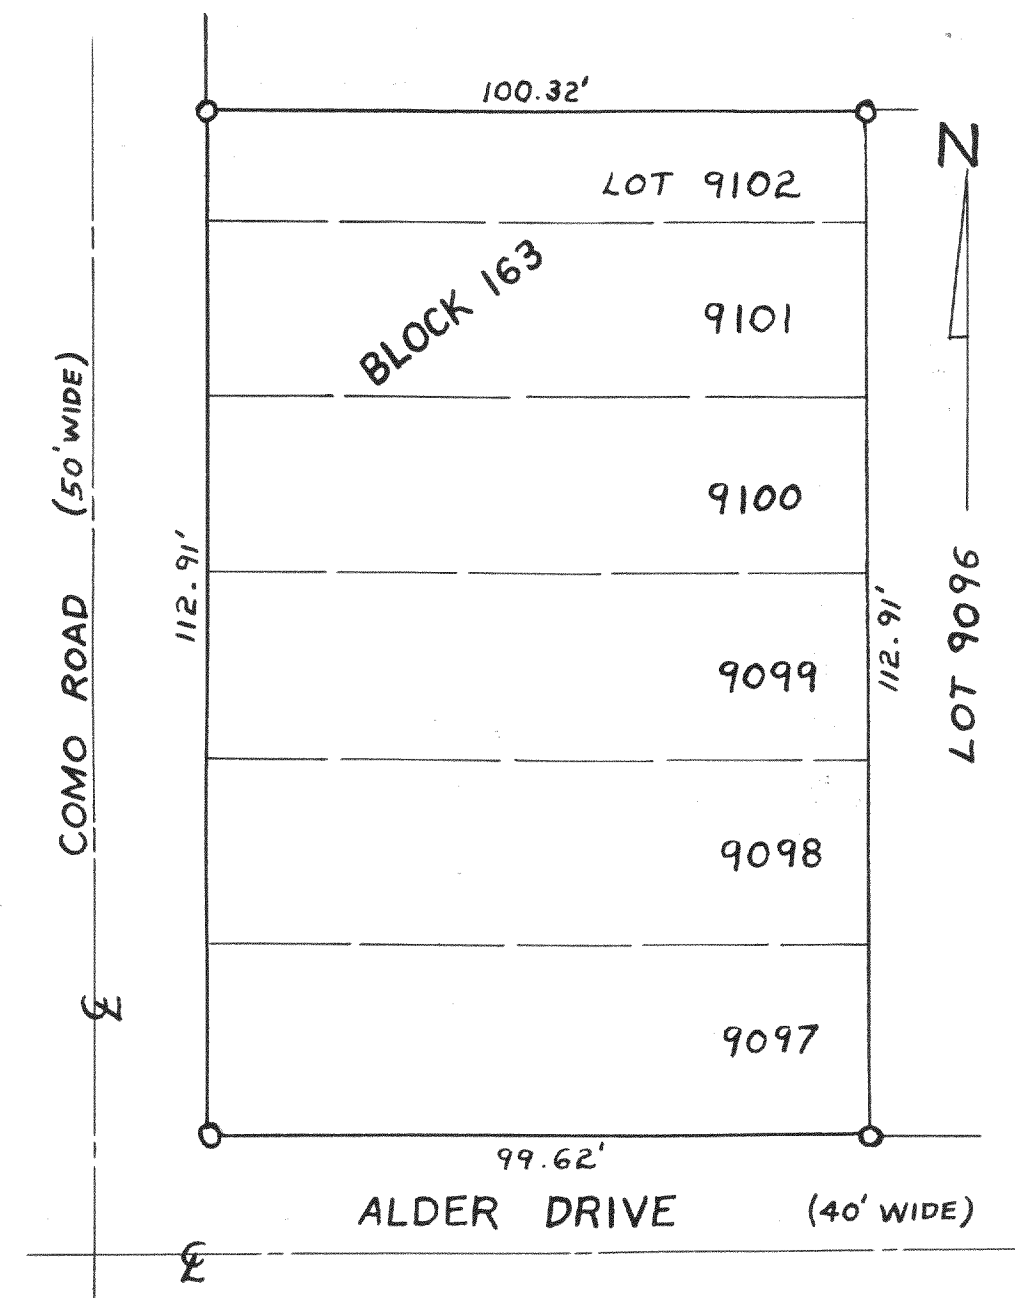

MAY, 1960

Lloyd L. Jensen
COUNTY SURVEYOR