


#3928

PLAT OF SURVEY OF

A PARCEL OF LAND LOCATED IN THE SE $\frac{1}{4}$ OF
SECTION 24, T4N, R16E, WALWORTH COUNTY,
WISCONSIN.

DECEMBER, 1960

Lloyd L Jensen
COUNTY SURVEYOR

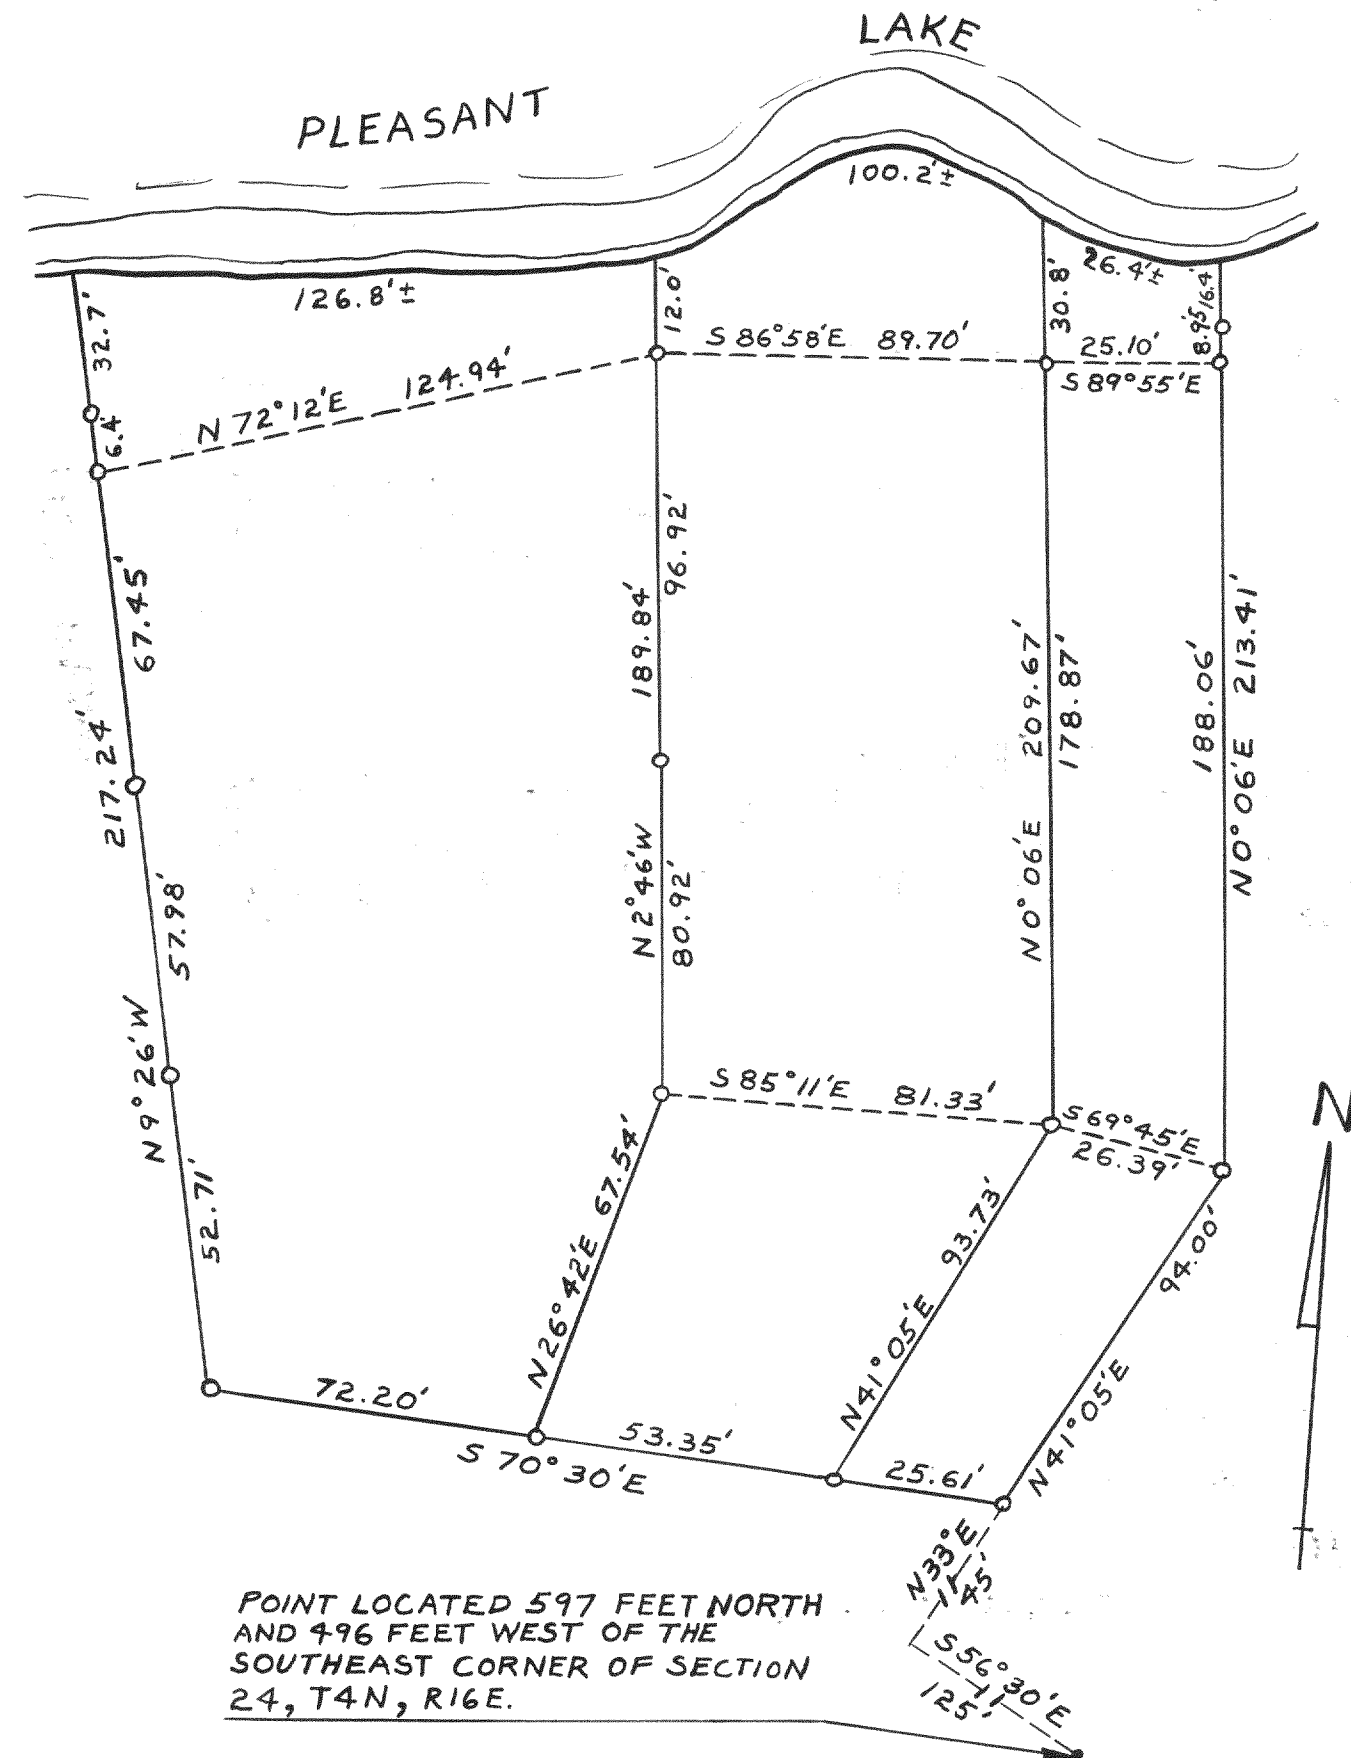


#3929

PLAT OF SURVEY OF

PART OF SE $\frac{1}{4}$ OF SECTION 24-4-16
WALWORTH COUNTY, WISCONSIN.

NOVEMBER, 1959

Lloyd L Jensen
COUNTY SURVEYOR

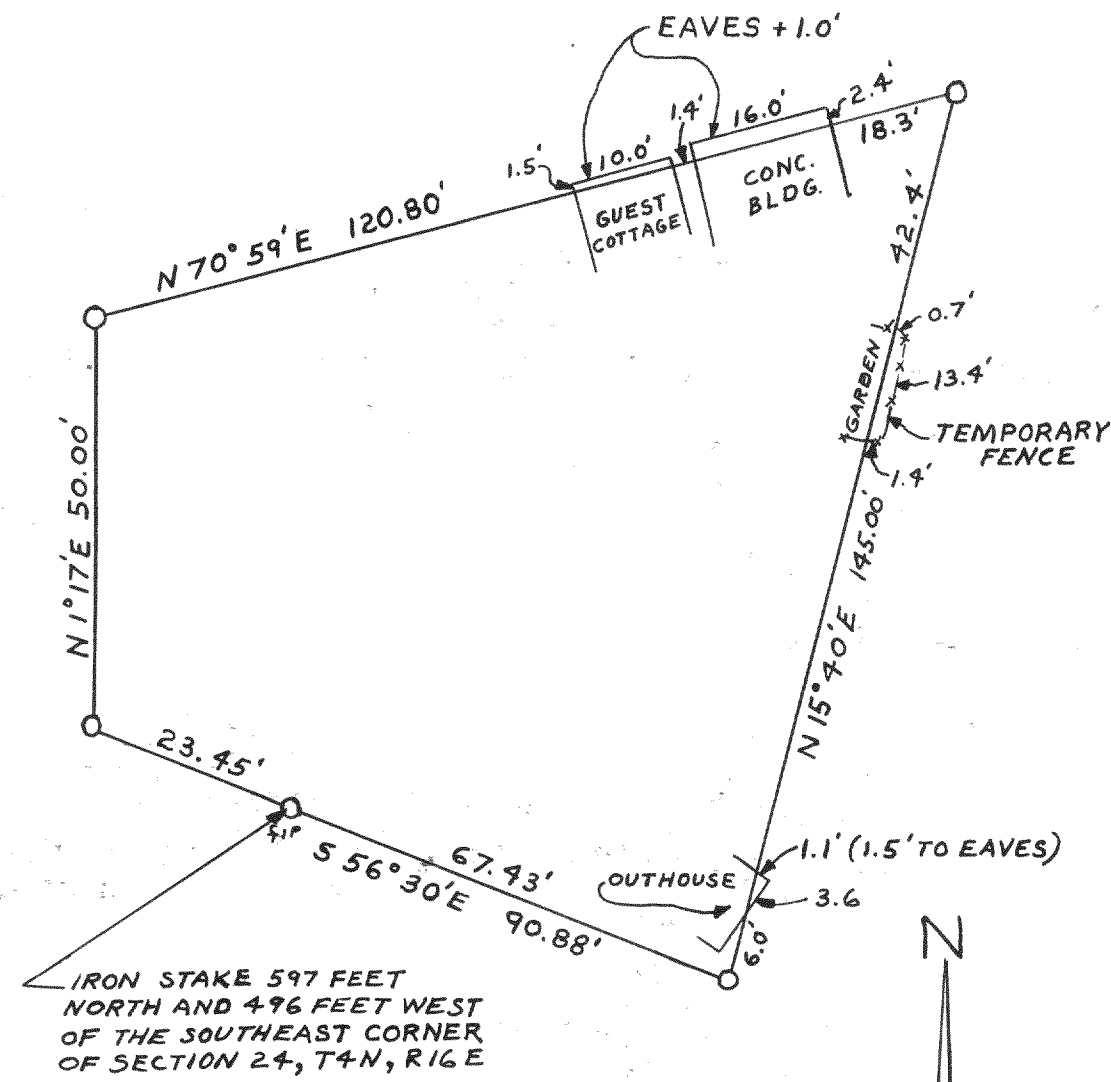

#3930

PLAT OF SURVEY OF

A PARCEL OF LAND LOCATED IN THE SOUTH $\frac{1}{2}$
OF THE NORTH $\frac{1}{2}$ OF THE NORTHEAST $\frac{1}{4}$ OF
SECTION 35, T1N, R18E, VILLAGE OF GENOA CITY,
WALWORTH COUNTY, WISCONSIN.

MARCH, 1961

Lloyd L Jensen
COUNTY SURVEYOR

