


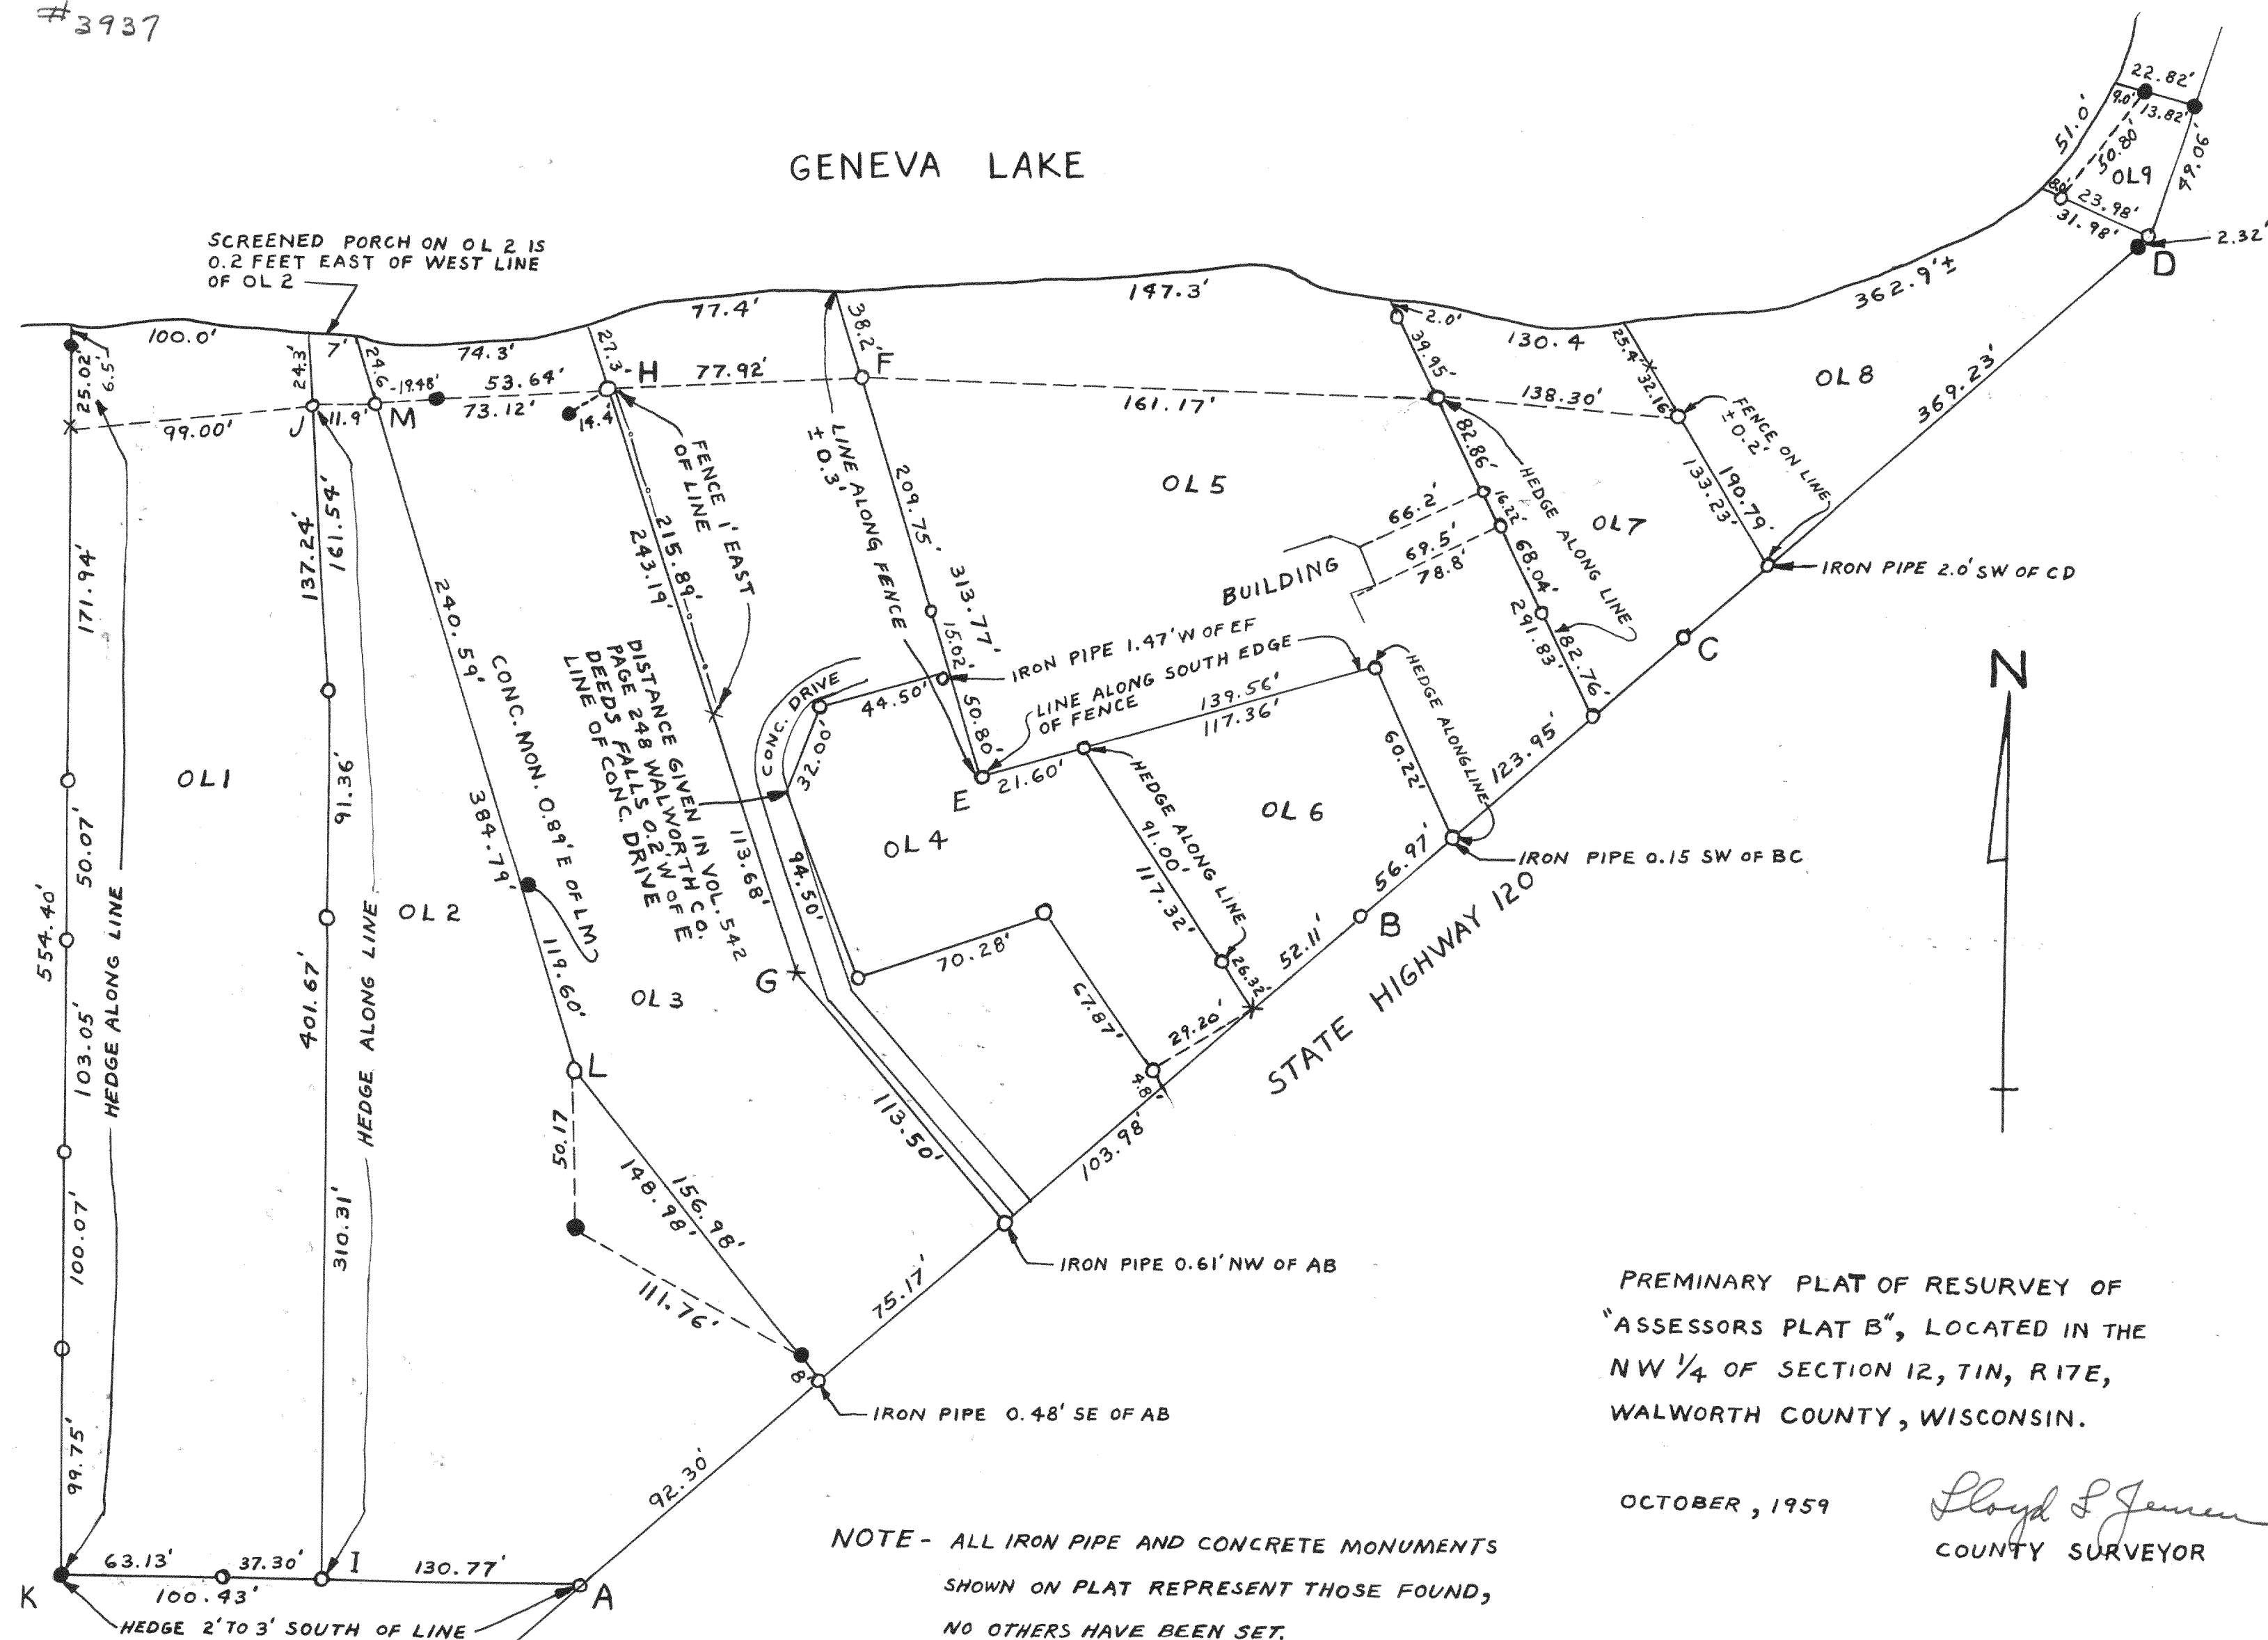

PREMINARY PLAT OF RESURVEY OF
"ASSESSORS PLAT B", LOCATED IN THE
NW 1/4 OF SECTION 12, T1N, R17E,
WALWORTH COUNTY, WISCONSIN.

OCTOBER, 1959

Lloyd S Jensen
COUNTY SURVEYOR

NOTE - ALL IRON PIPE AND CONCRETE MONUMENTS
SHOWN ON PLAT REPRESENT THOSE FOUND,
NO OTHERS HAVE BEEN SET.

NOTE - LINES CD, GH, IJ, AND AK ARE NOT STRAIGHT LINES.