



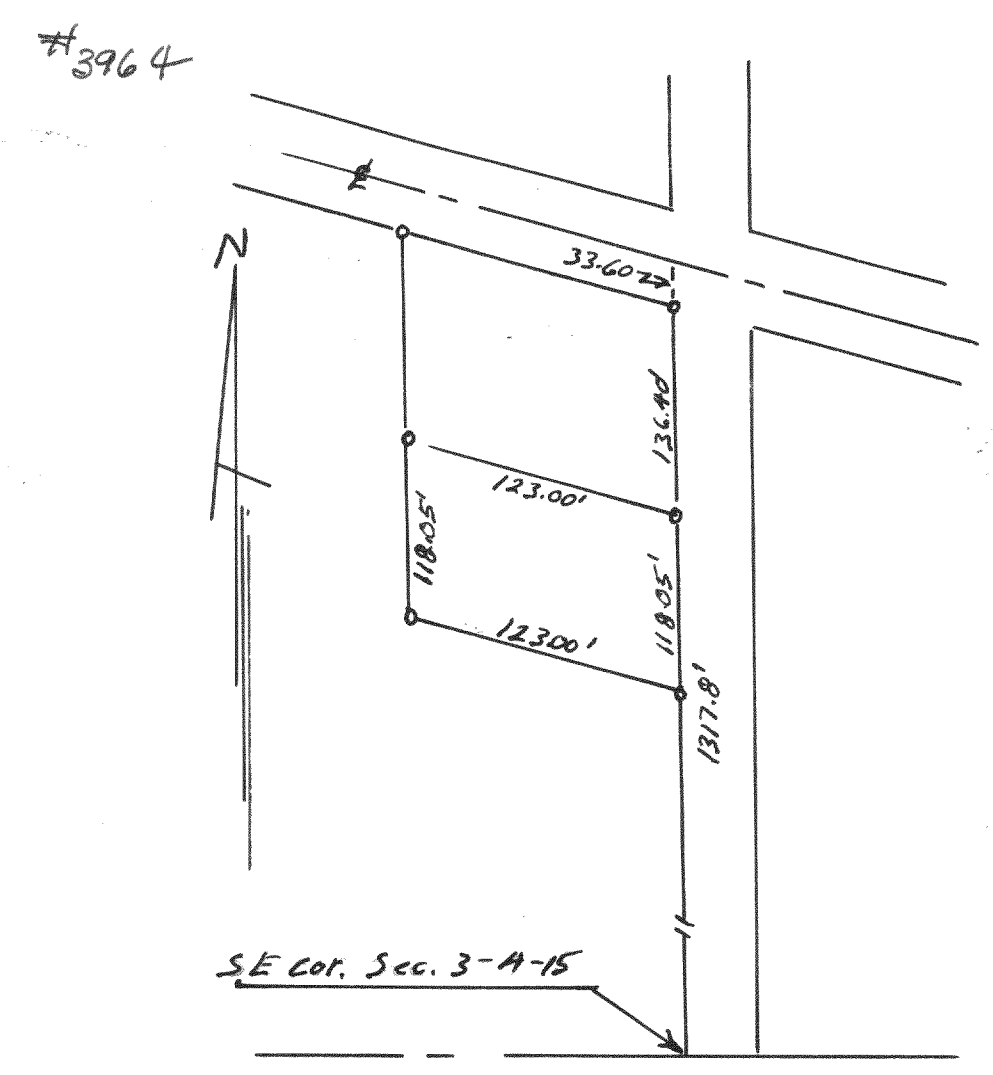


Survey of parcel in SE 1/4 Sec 3-A-15
Feb 10, 1960
Floyd L. Jensen
Wal. Co. Surveyor

#3967

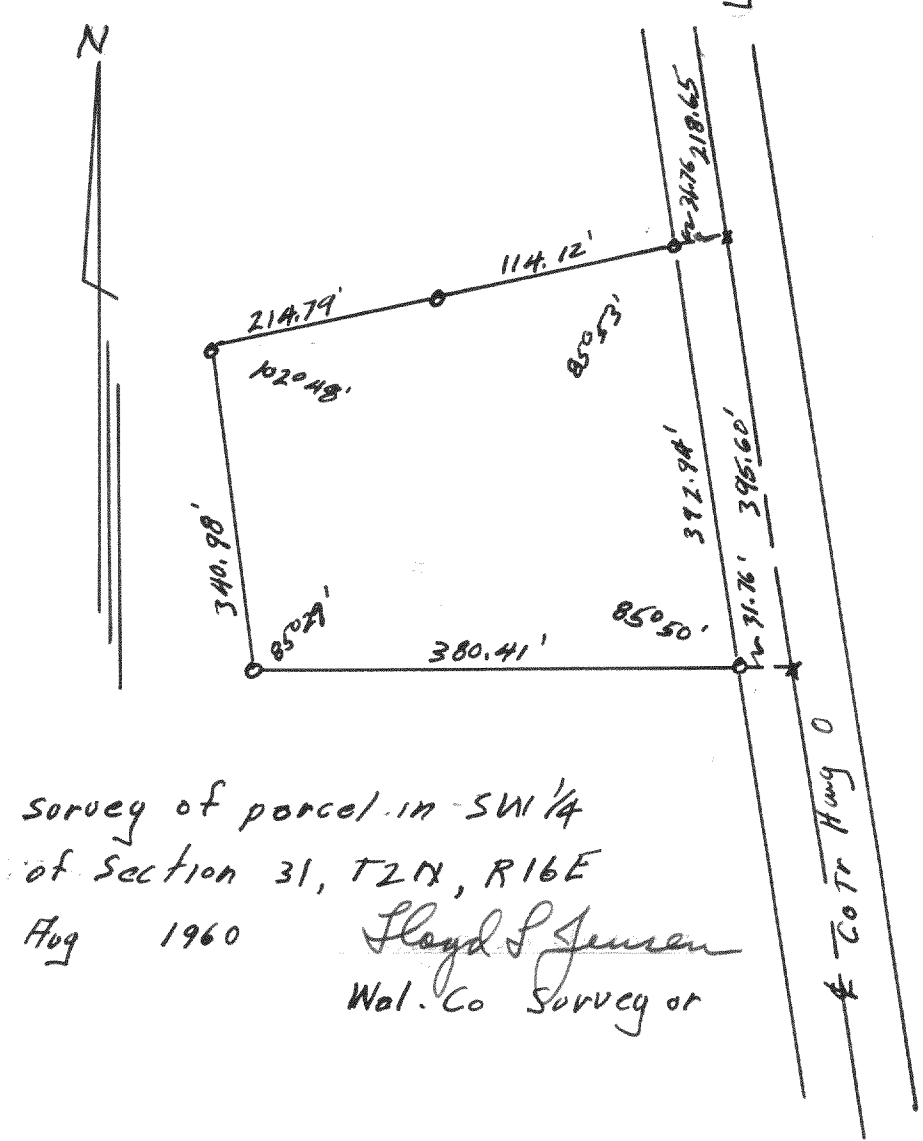


Survey of parcel in SW 1/4
of Section 31, T2N, R16E
Aug 1960
Floyd L. Jensen
Wal. Co. Surveyor

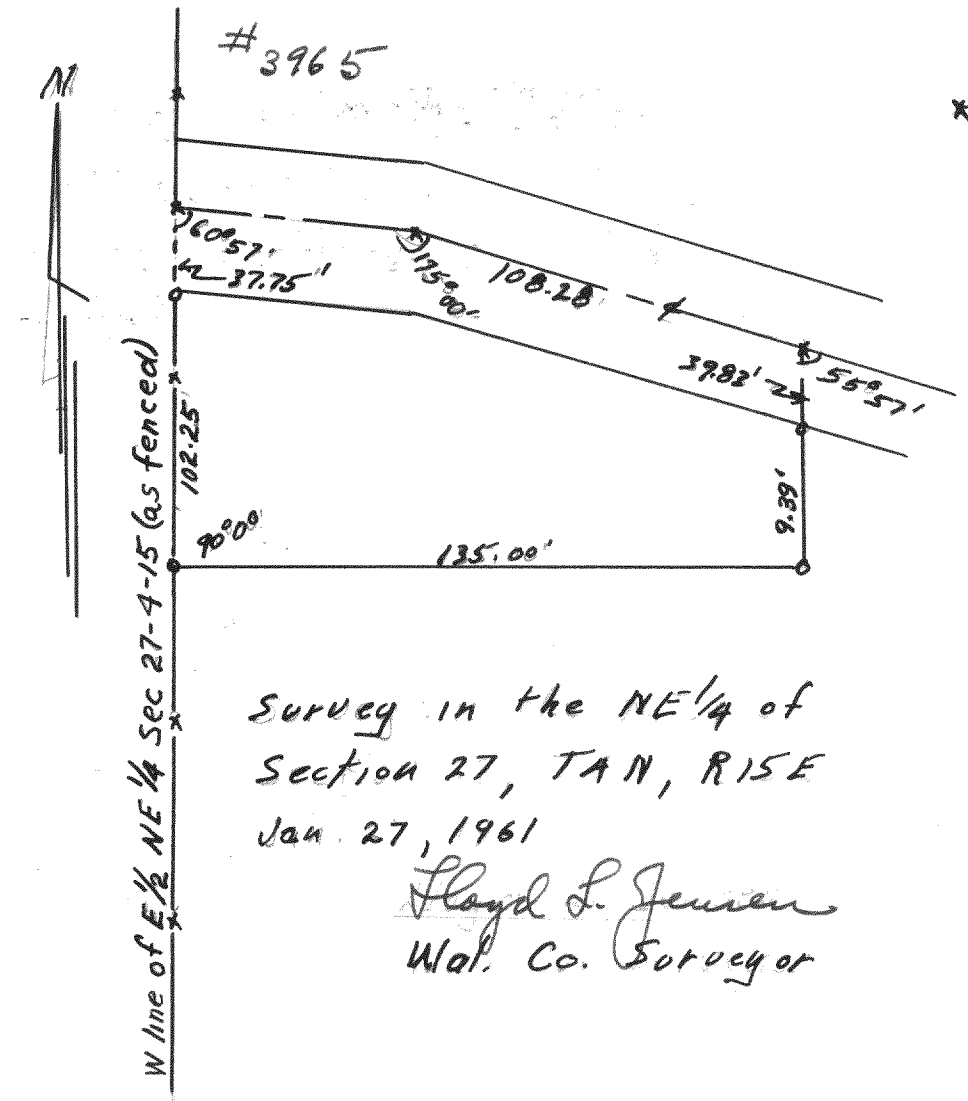


Survey in the NE 1/4 of
Section 27, T2N, R15E
Jan 27, 1961
Floyd L. Jensen
Wal. Co. Surveyor

#3968

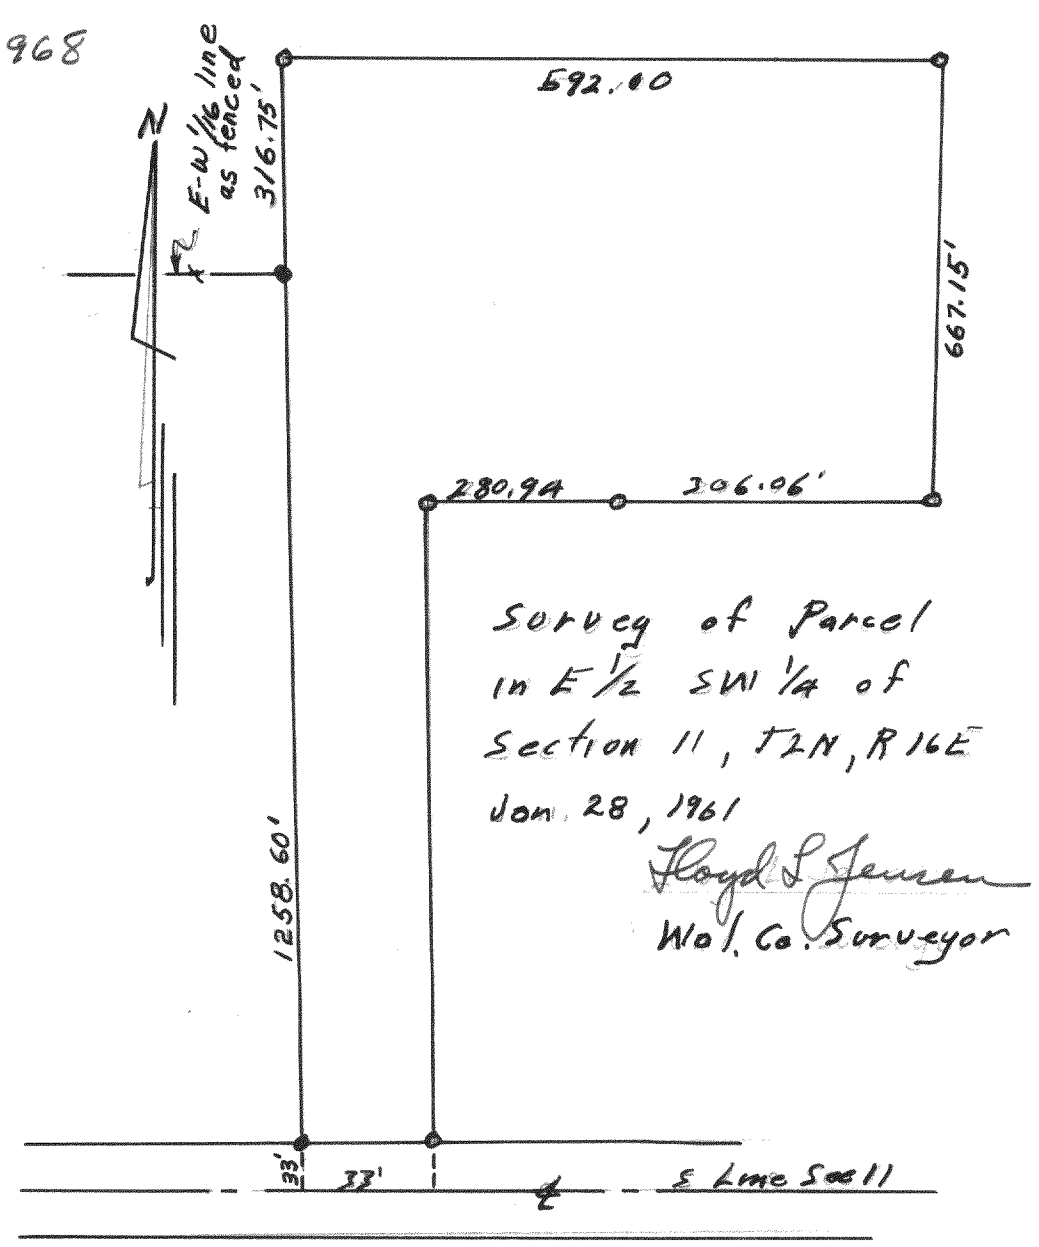


Survey of Parcel
in E 1/2 SW 1/4 of
Section 11, T2N, R16E
Jan 28, 1961
Floyd L. Jensen
Wal. Co. Surveyor

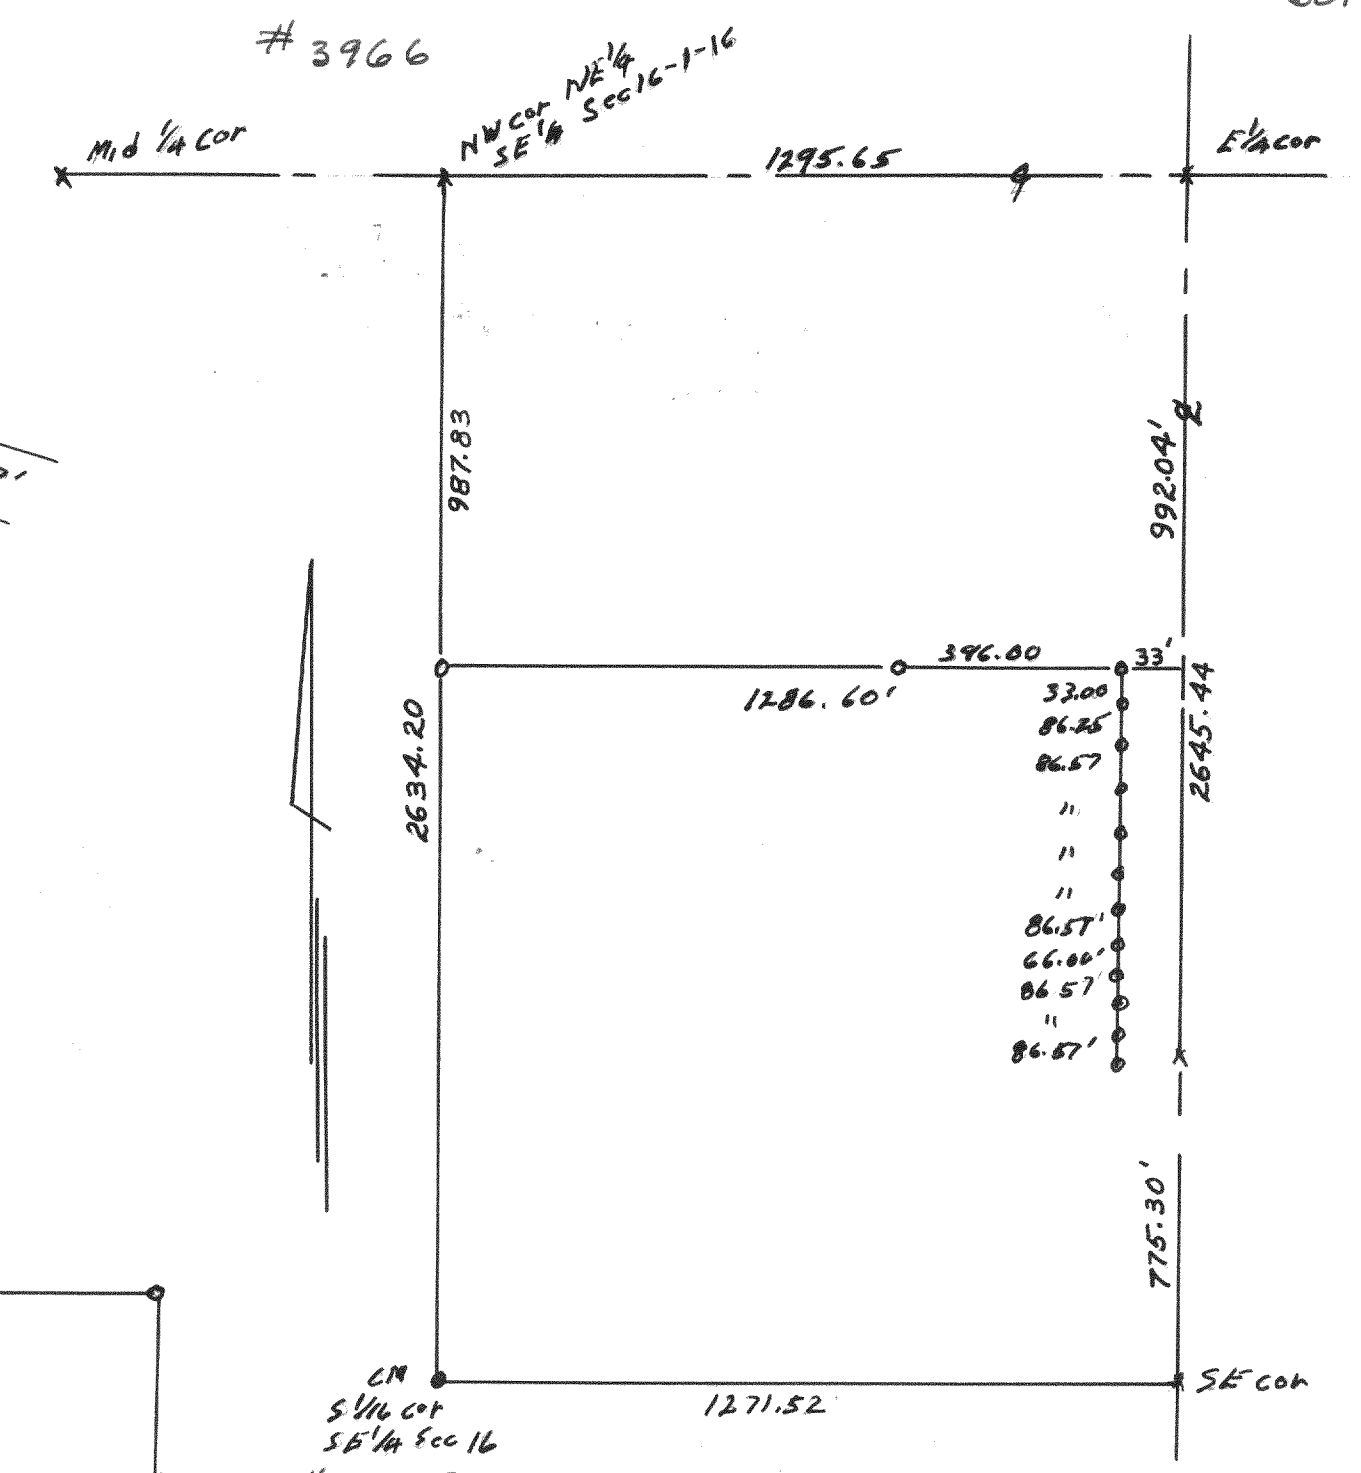

#3969

Survey in NE 1/4 SE 1/4 Sec 16-1-16
Apr. 1960, 1960

Floyd L. Jensen
Wal. Co. Surveyor

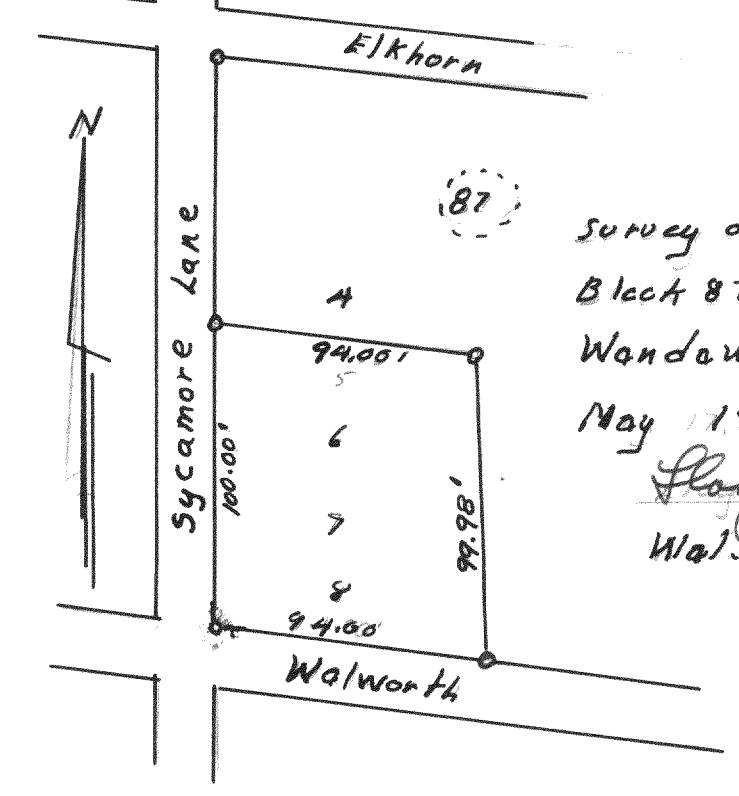

Survey of Lots 5-8
Block 87, Lake
Wandawega
May 1960
Floyd L. Jensen
Wal. Co. Surveyor