


#3970

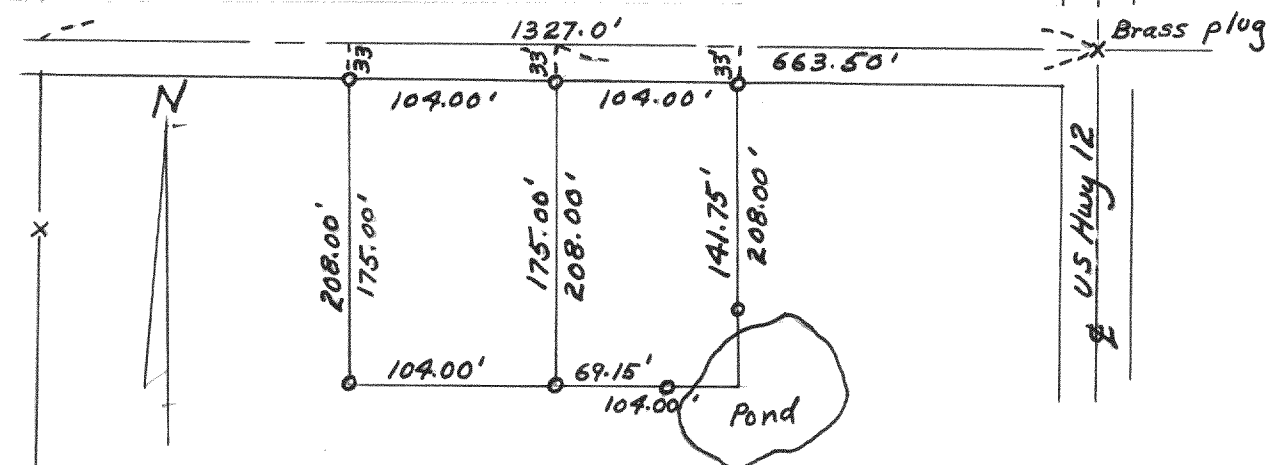


Survey in NE 1/4 SE 1/4 of Sec 24, T3N, R16E

Oct 24, 1960

Floyd L. Jensen
Wal. Co. Surveyor

#3971

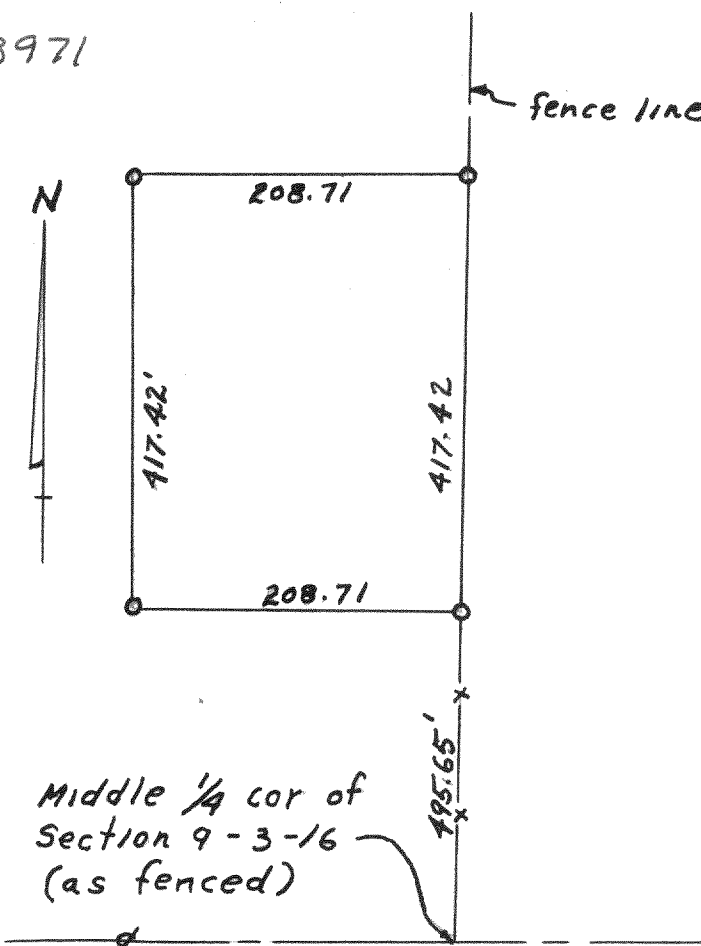


Middle 1/4 cor of
Section 9-3-16
(as fenced)

Survey in SE 1/4 NW 1/4 Sec 9-3-16

Mar 22, 1961

Floyd L. Jensen
Wal. Co. Surveyor

#3972

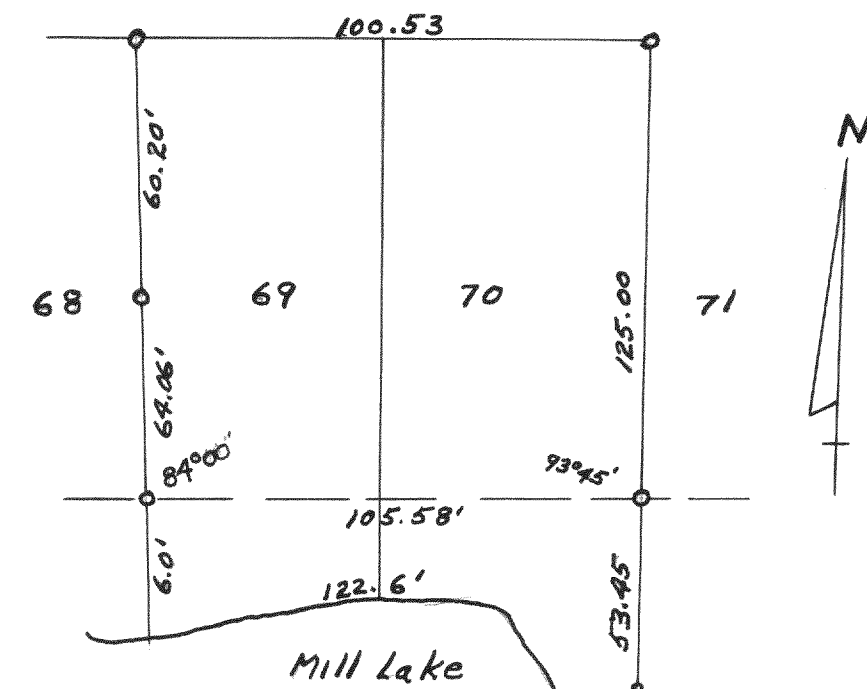


Survey of Lots 69 & 70
Lauderdale Heights T4N, R16E

July 14, 1960

Floyd L. Jensen
Wal. Co. Surveyor


#3973

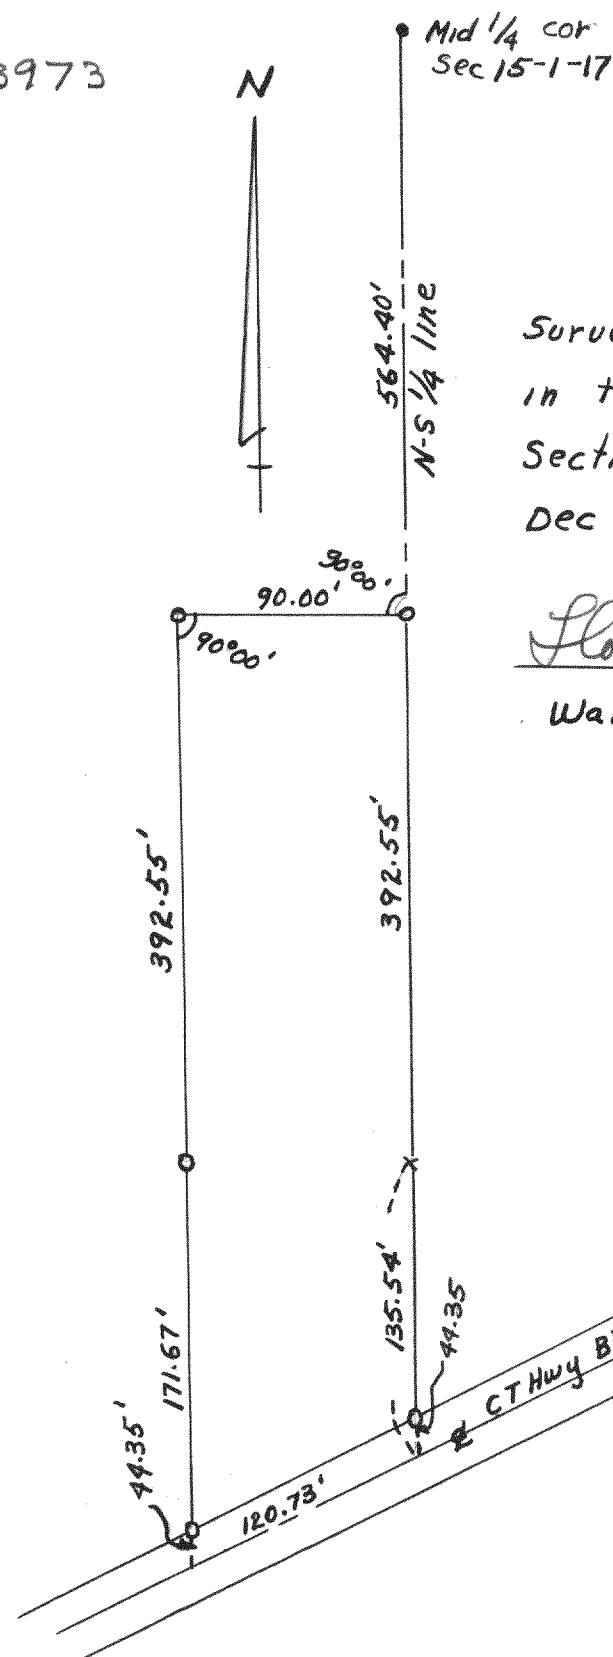

Survey of Parcel
in the SW 1/4 of
Section 15-1-17
Dec 16, 1960

Floyd L. Jensen
Wal. Co. Surveyor

#3974

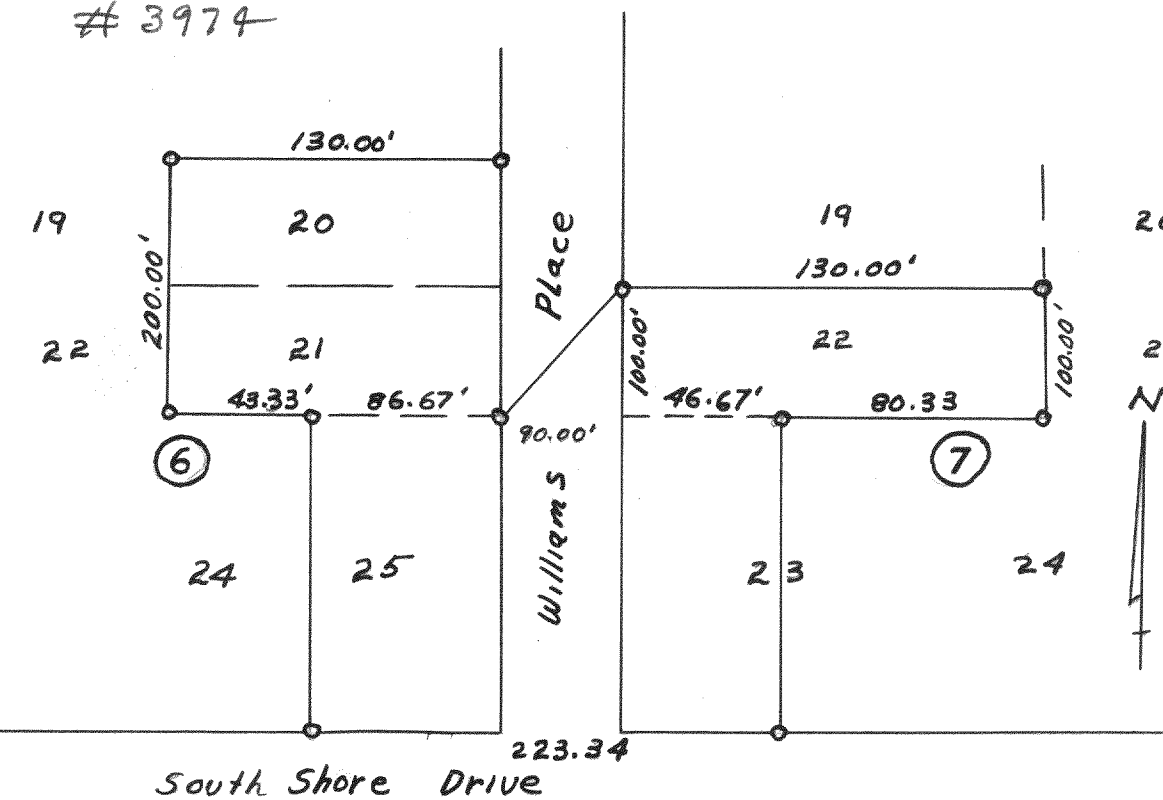


Survey of Part of Blocks 6 & 7, Lake
Geneva Terrace. T1N, R17E

Aug 18, 1960

Floyd L. Jensen
Wal. Co. Surveyor

#3975

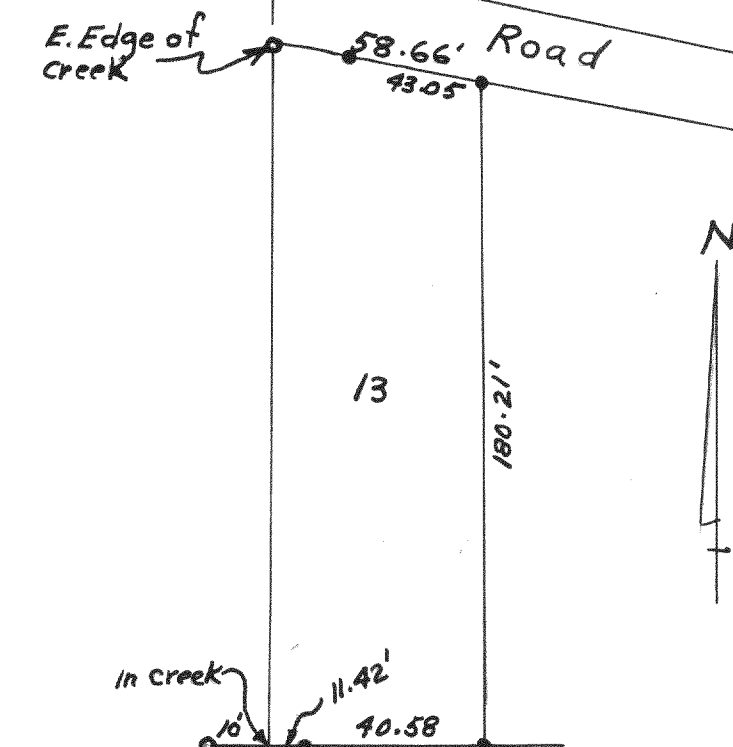

Survey of Lot 13, Lake
Geneva Beach, T1N, R17E

Sept. 15, 1960

Floyd L. Jensen
Wal. Co. Surveyor