



#3988

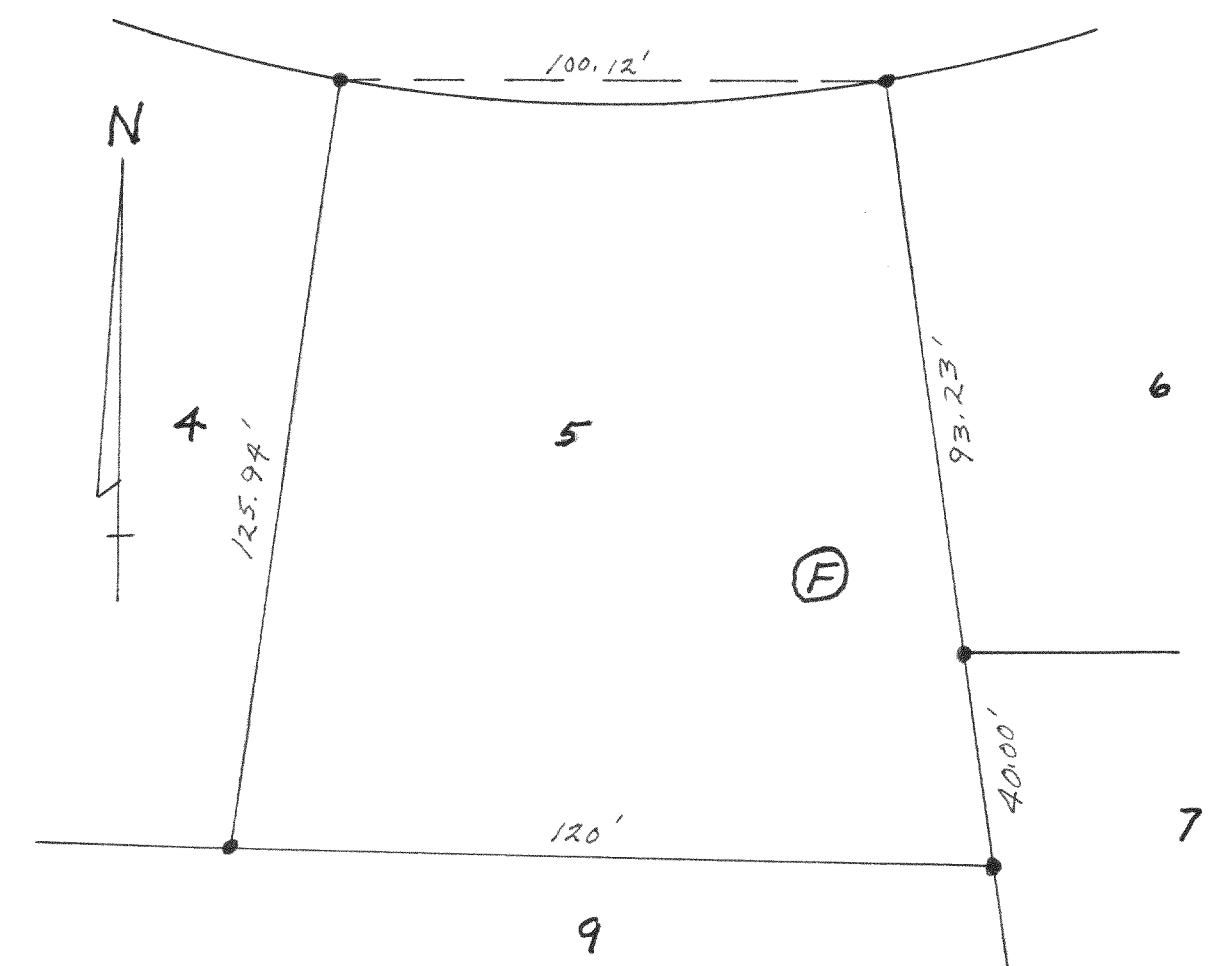


Survey of Lot 5, Block F, Unit 3,
Country Club Estates, Village of
Fontana-on-Geneva Lake
Date 8-10-61 Lloyd L Jensen
(County Surveyor)

#3990

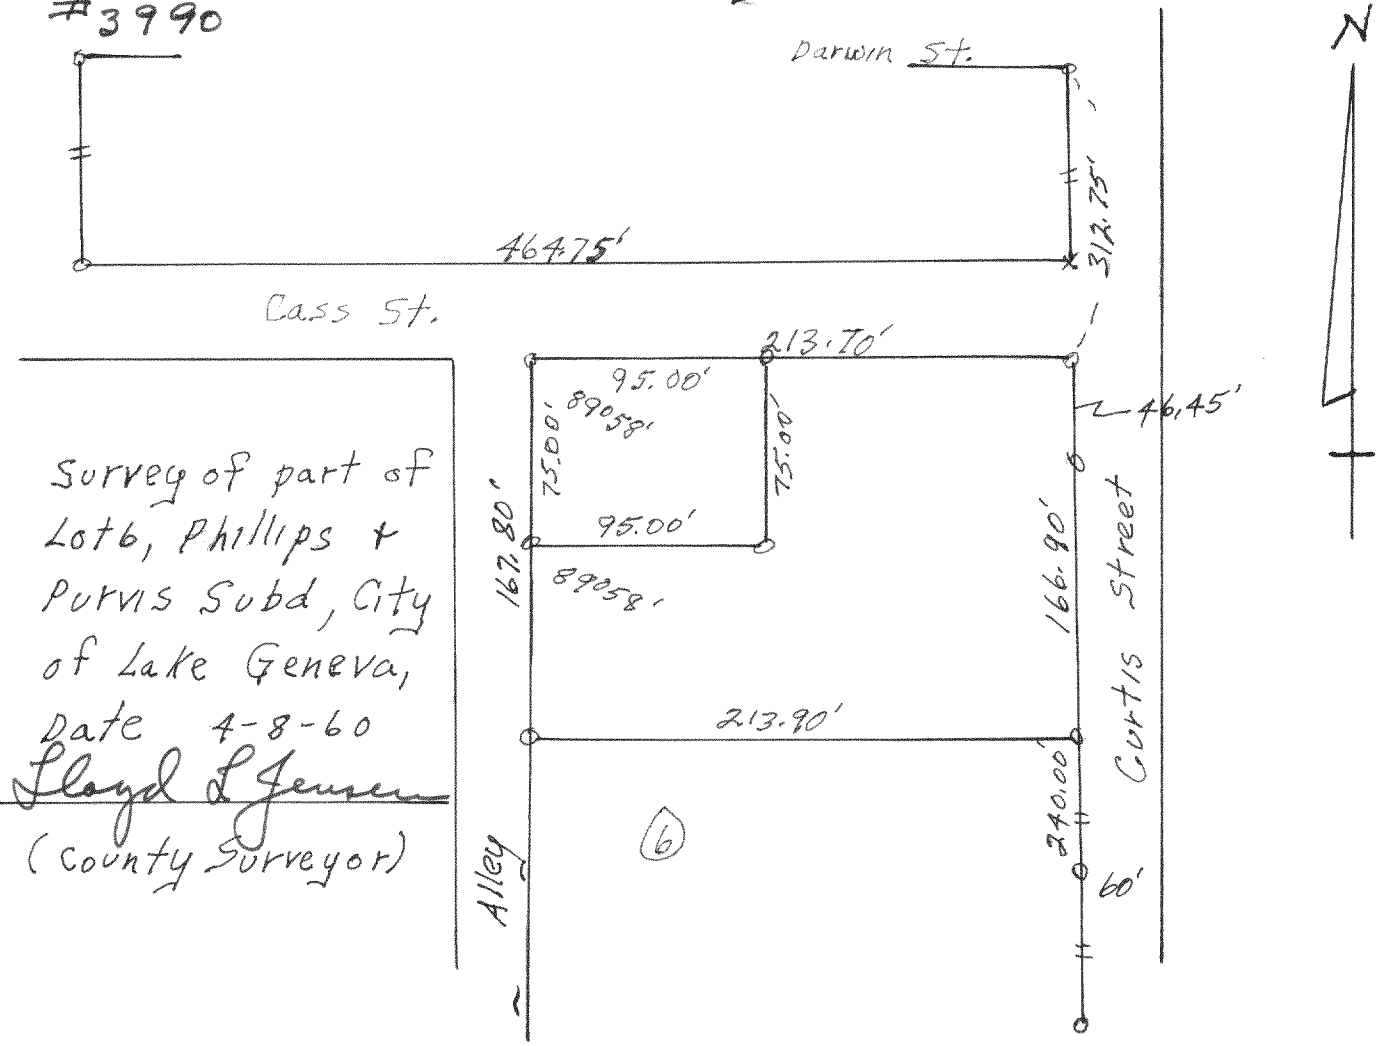


Survey of part of
Lot 6, Phillips +
Purvis Subd, City
of Lake Geneva,
Date 4-8-60
Lloyd L Jensen
(County Surveyor)

#3989

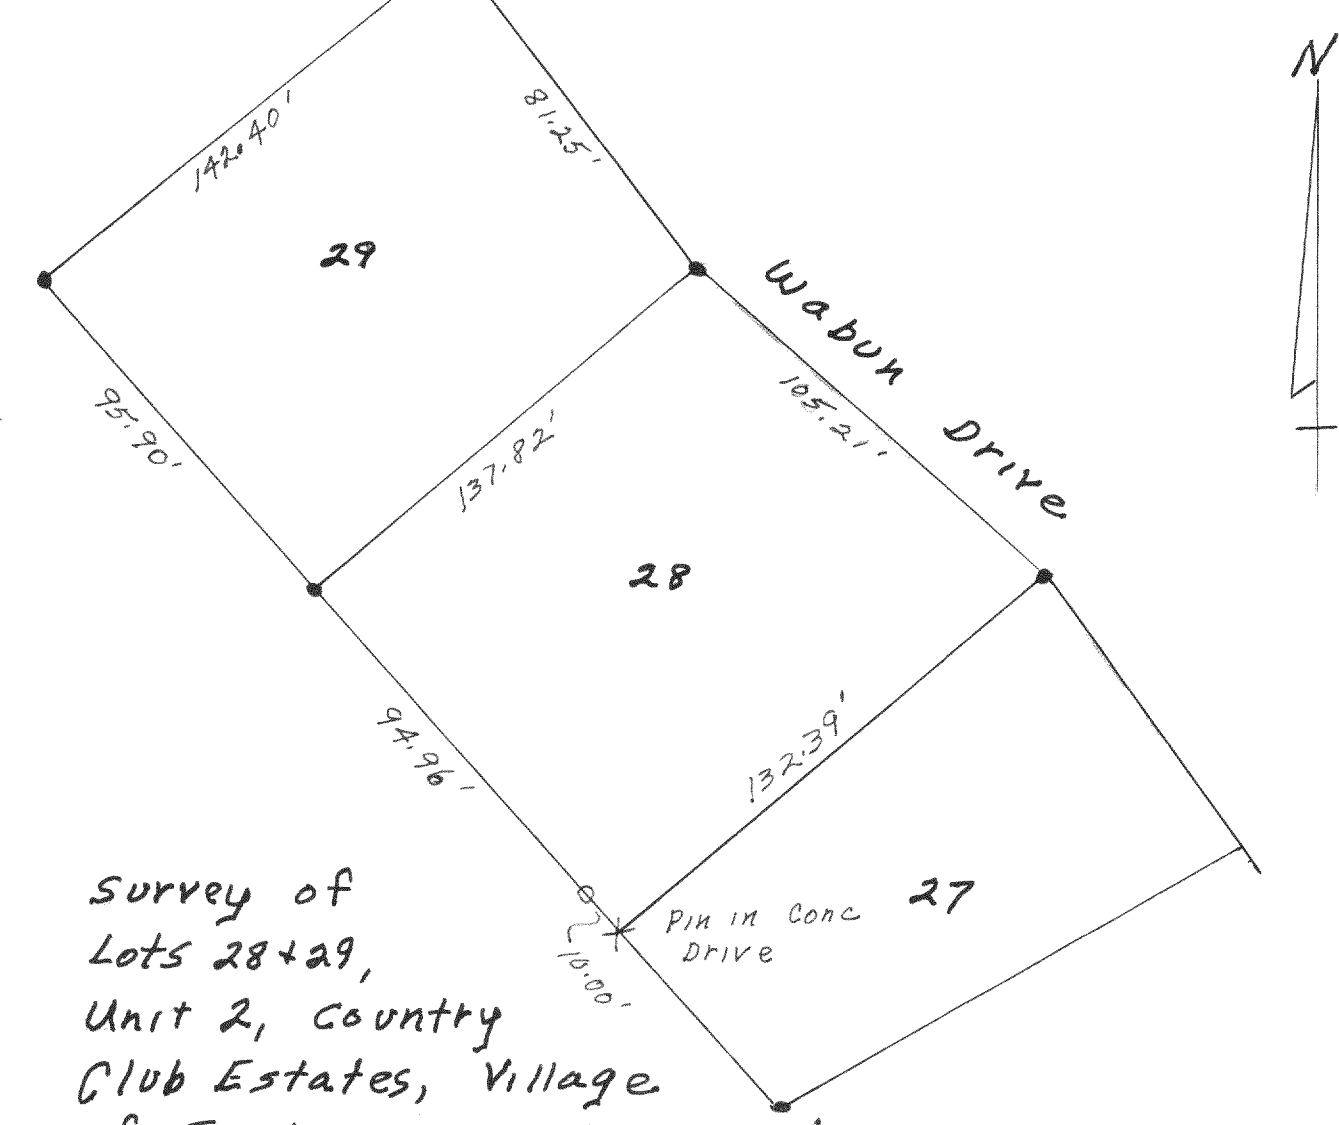

Survey of
Lots 28+29,
Unit 2, Country
Club Estates, Village
of Fontana-on-Geneva-Lake
Date 11-7-61 Lloyd L Jensen
(County Surveyor)

#3991

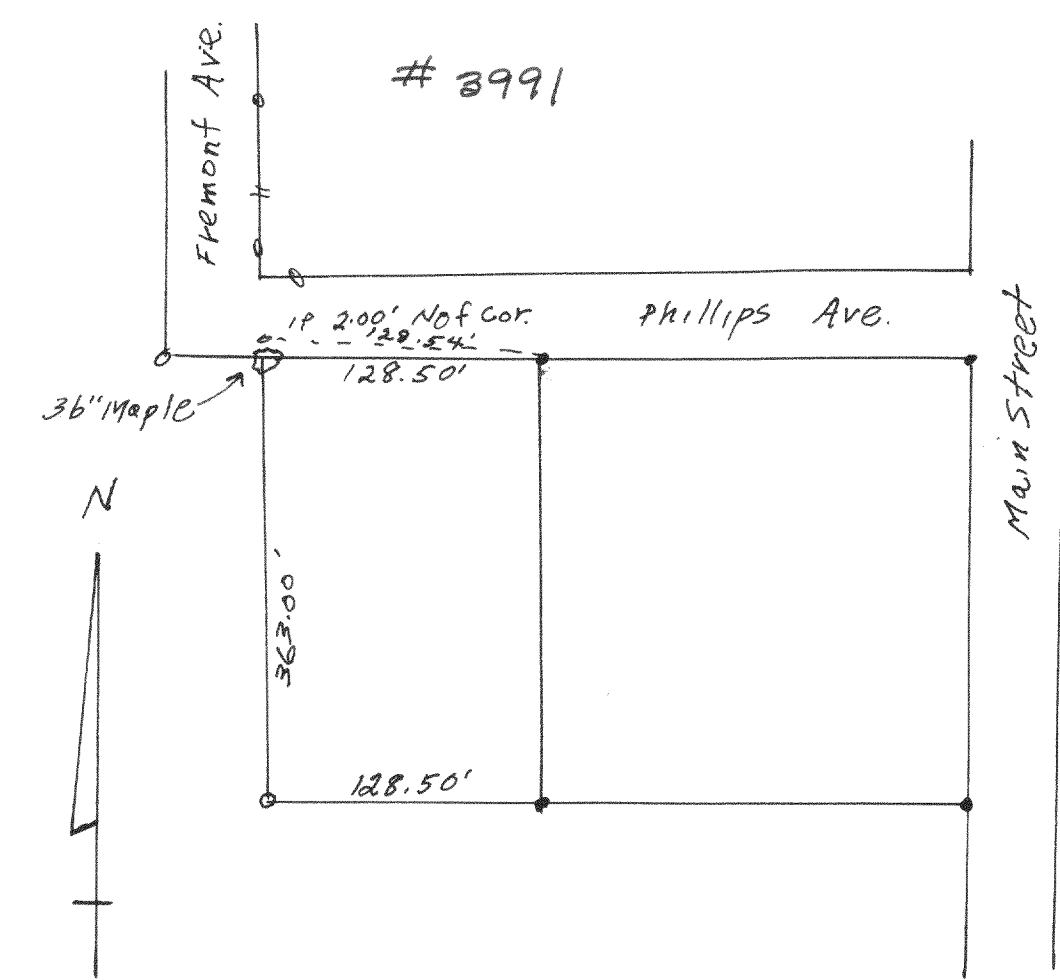

Survey in the SE 1/4
of Sec 21-1-16,
Village of Walworth
Date 1-10-60
Lloyd L Jensen
(County Surveyor)