




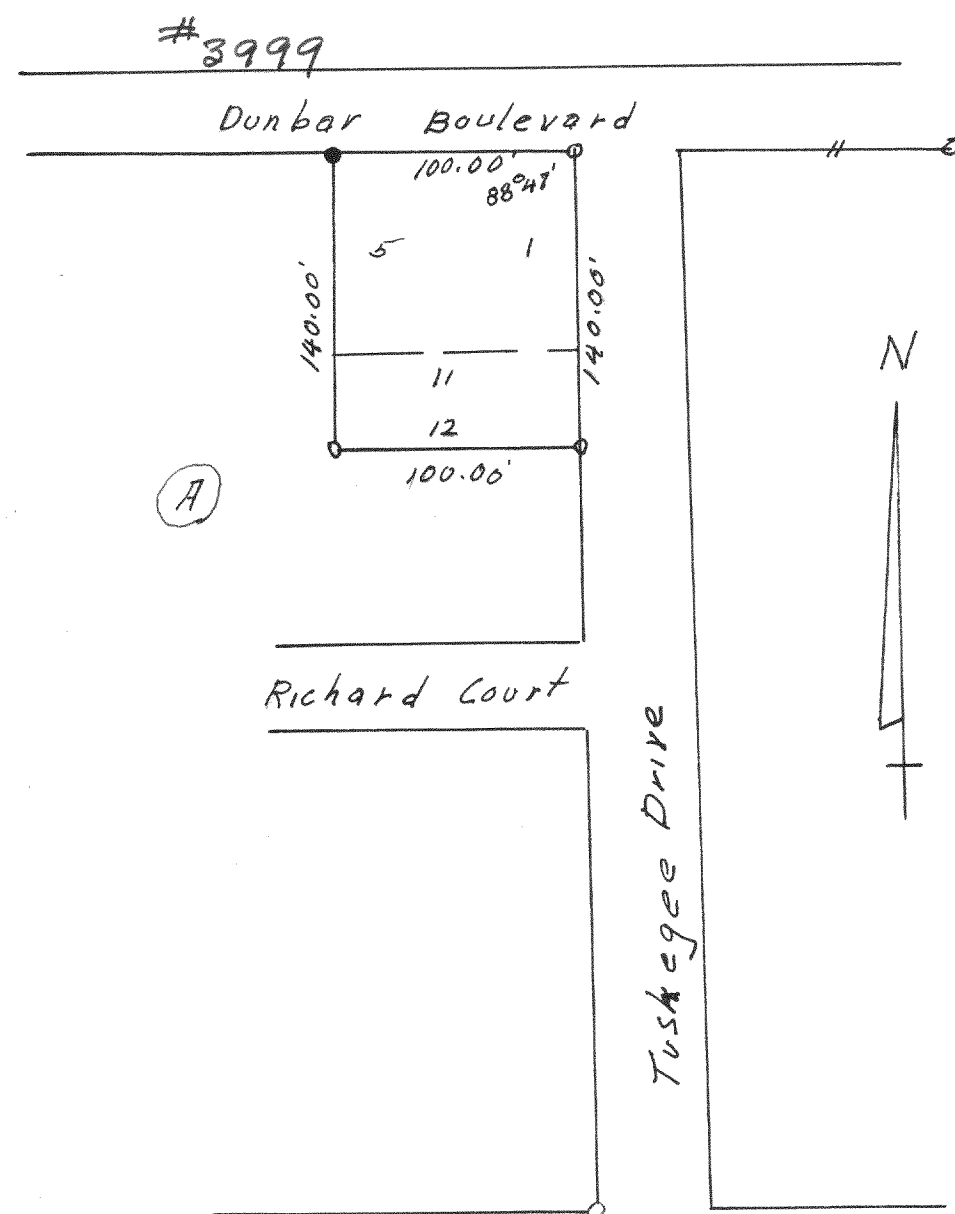


Washington Ave
Survey of Lots 1-5 & 11-12, Block A,
Lake Ivanhoe, T1N, R18E
Date 10-16-61 Lloyd S. Jensen
(County Surveyor)

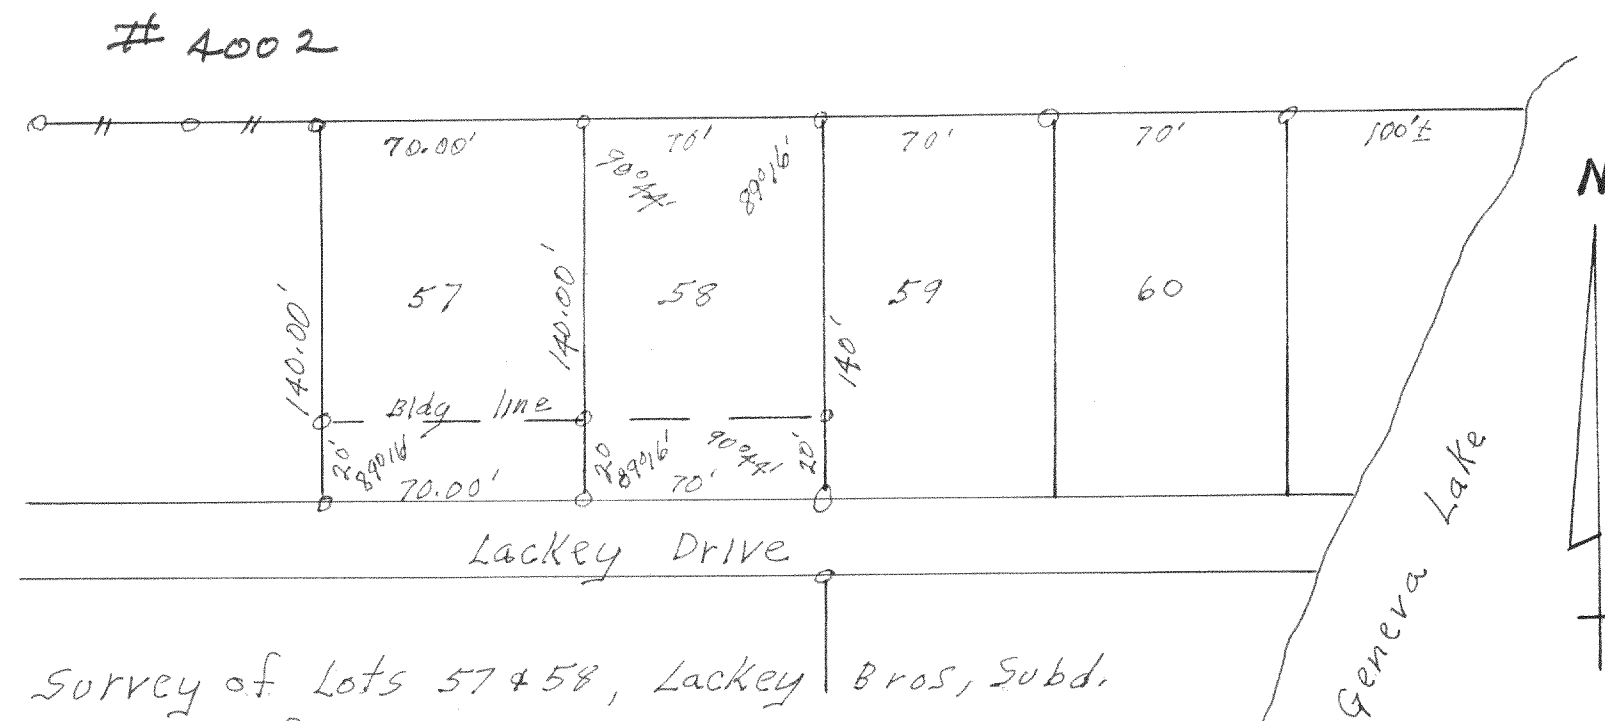

Survey of Lots 57 & 58, Lackey Bros, Subd.
Village of Williams Bay

Date - Lot 58 - 4-26-61 Lloyd S. Jensen
Lot 57 - 8-22-61 (County Surveyor)

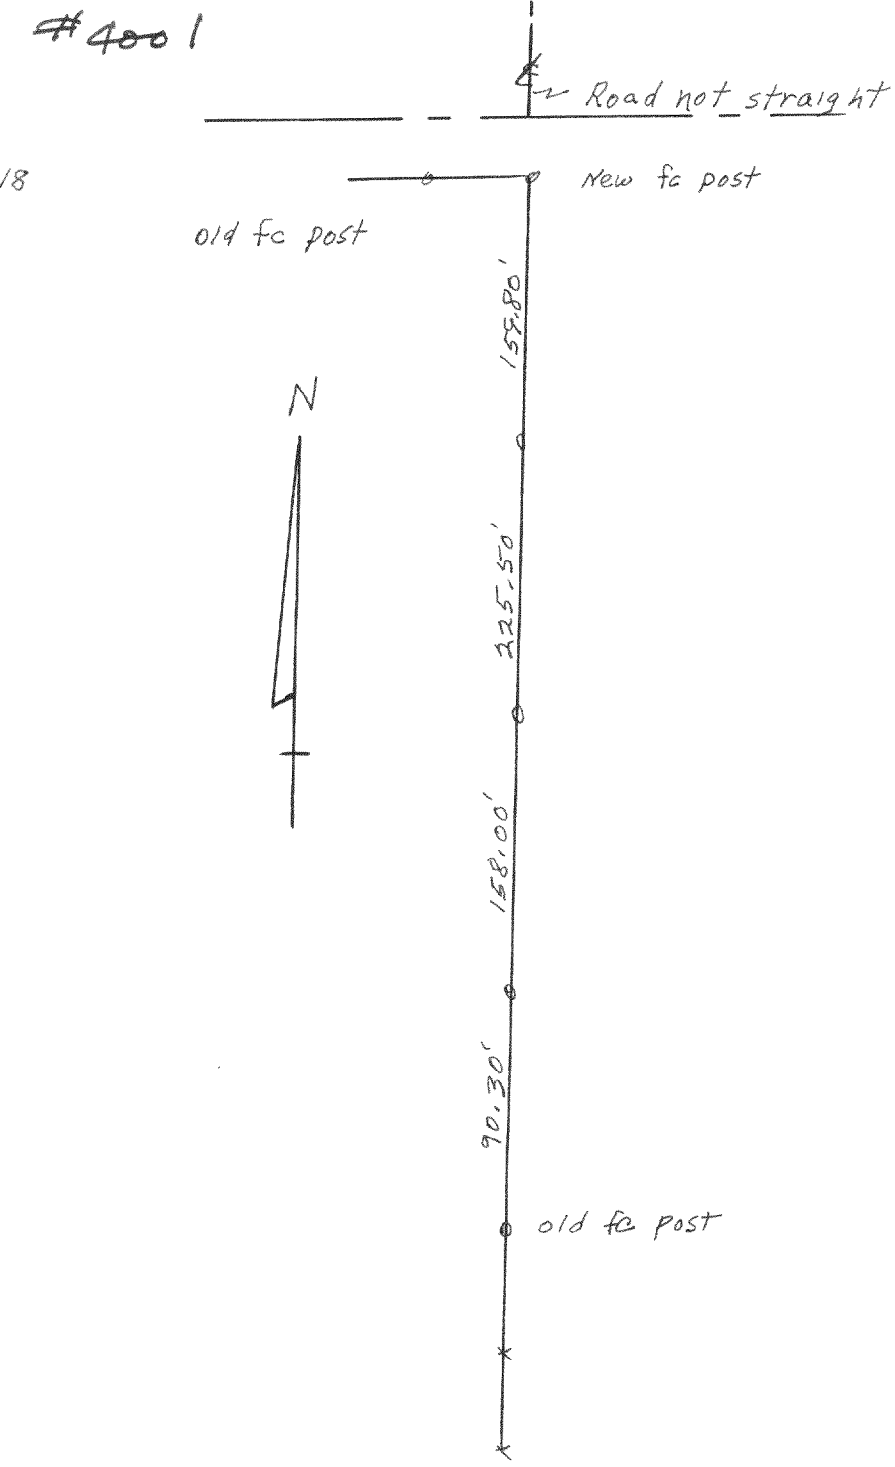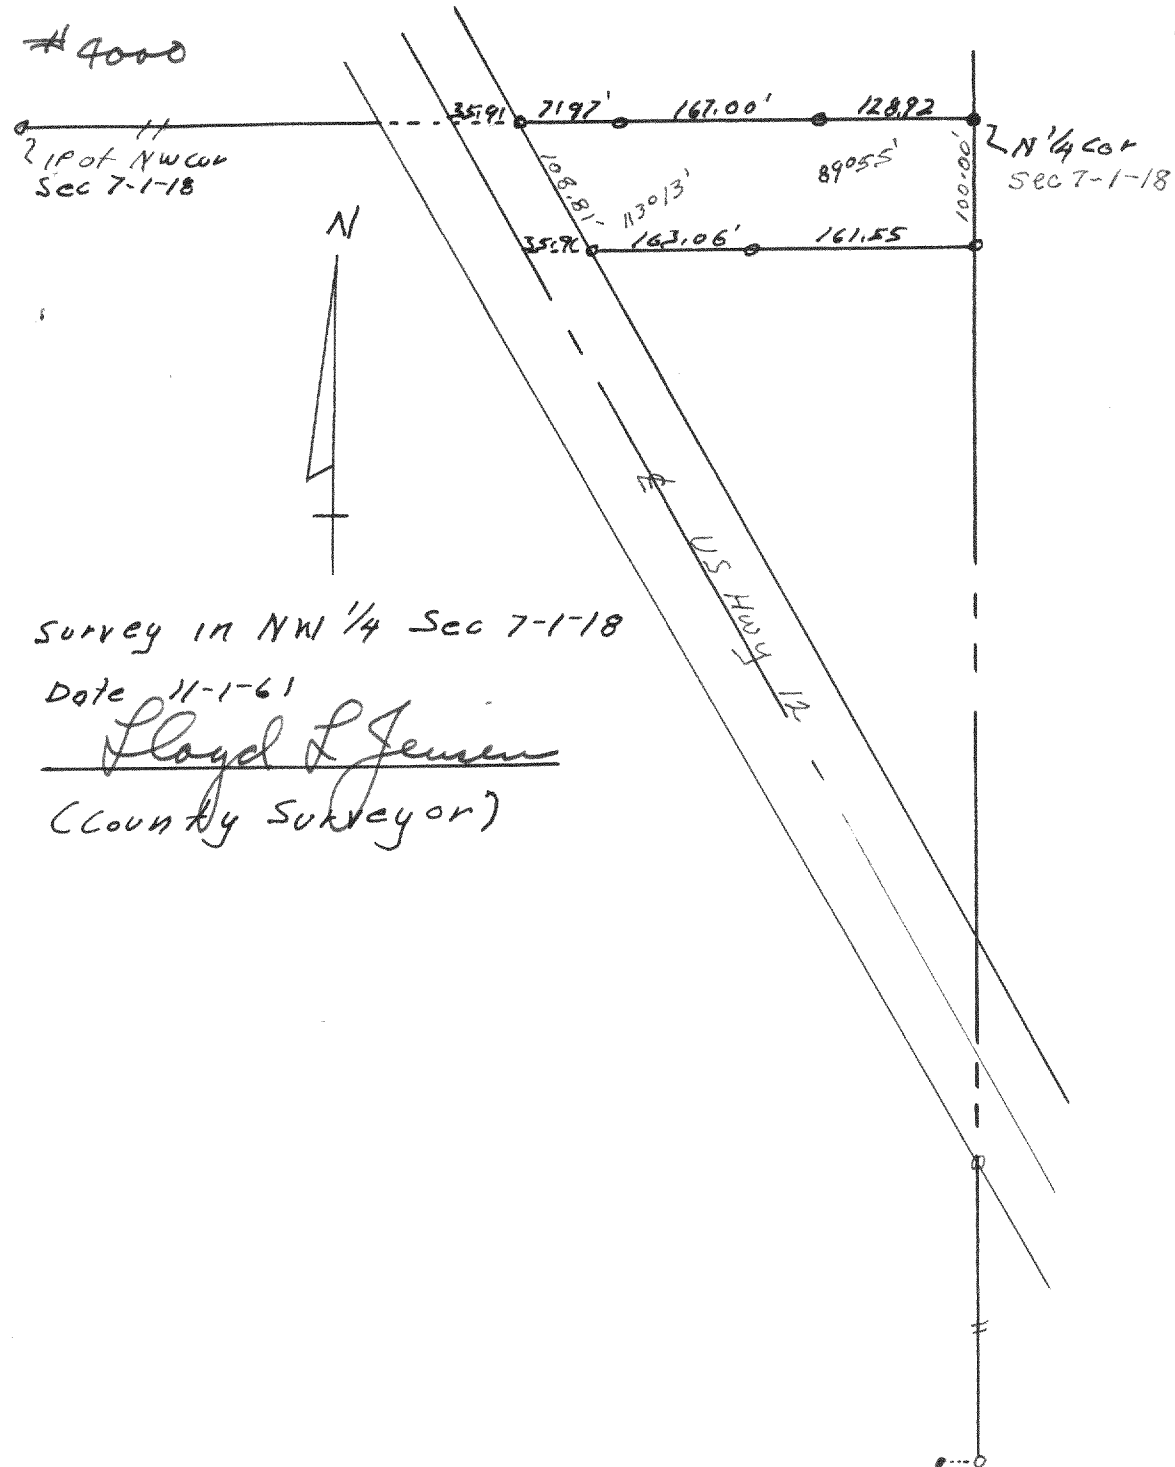

Survey of N-S 1/4 line
Section 24-2-18
date 2-10-61 Lloyd S. Jensen
(County Surveyor)