




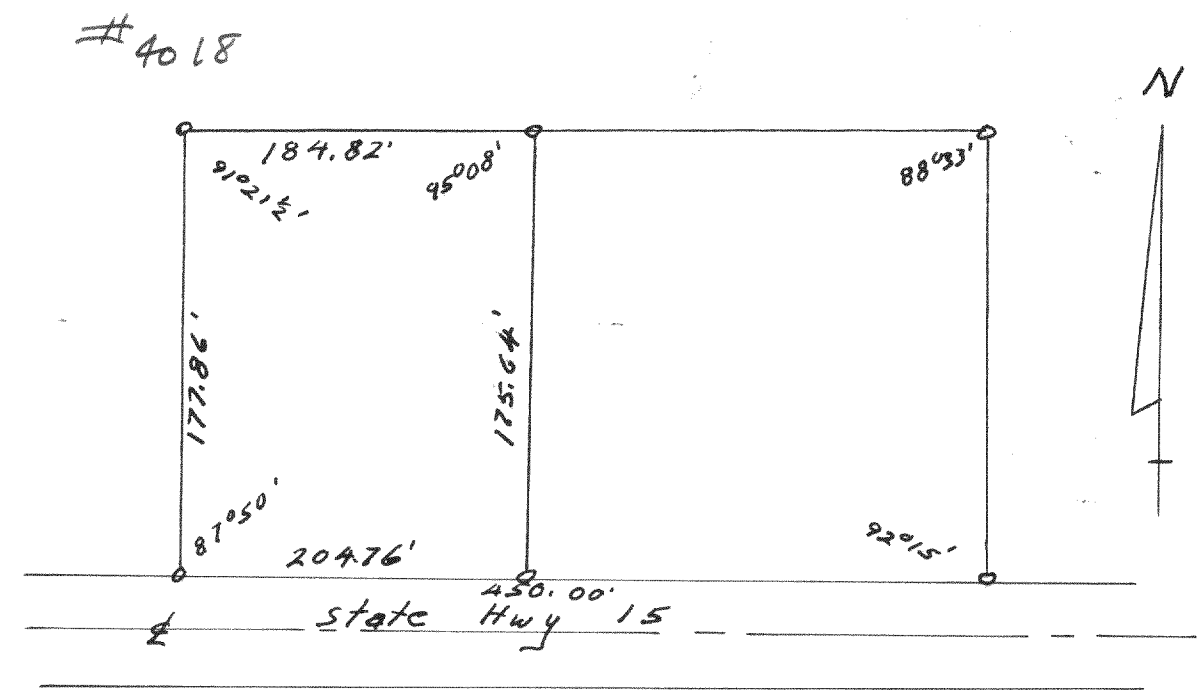

Survey in NE 1/4 of Section 25-4-17
Date 5-12-60
Lloyd S. Jensen
(County Surveyor)

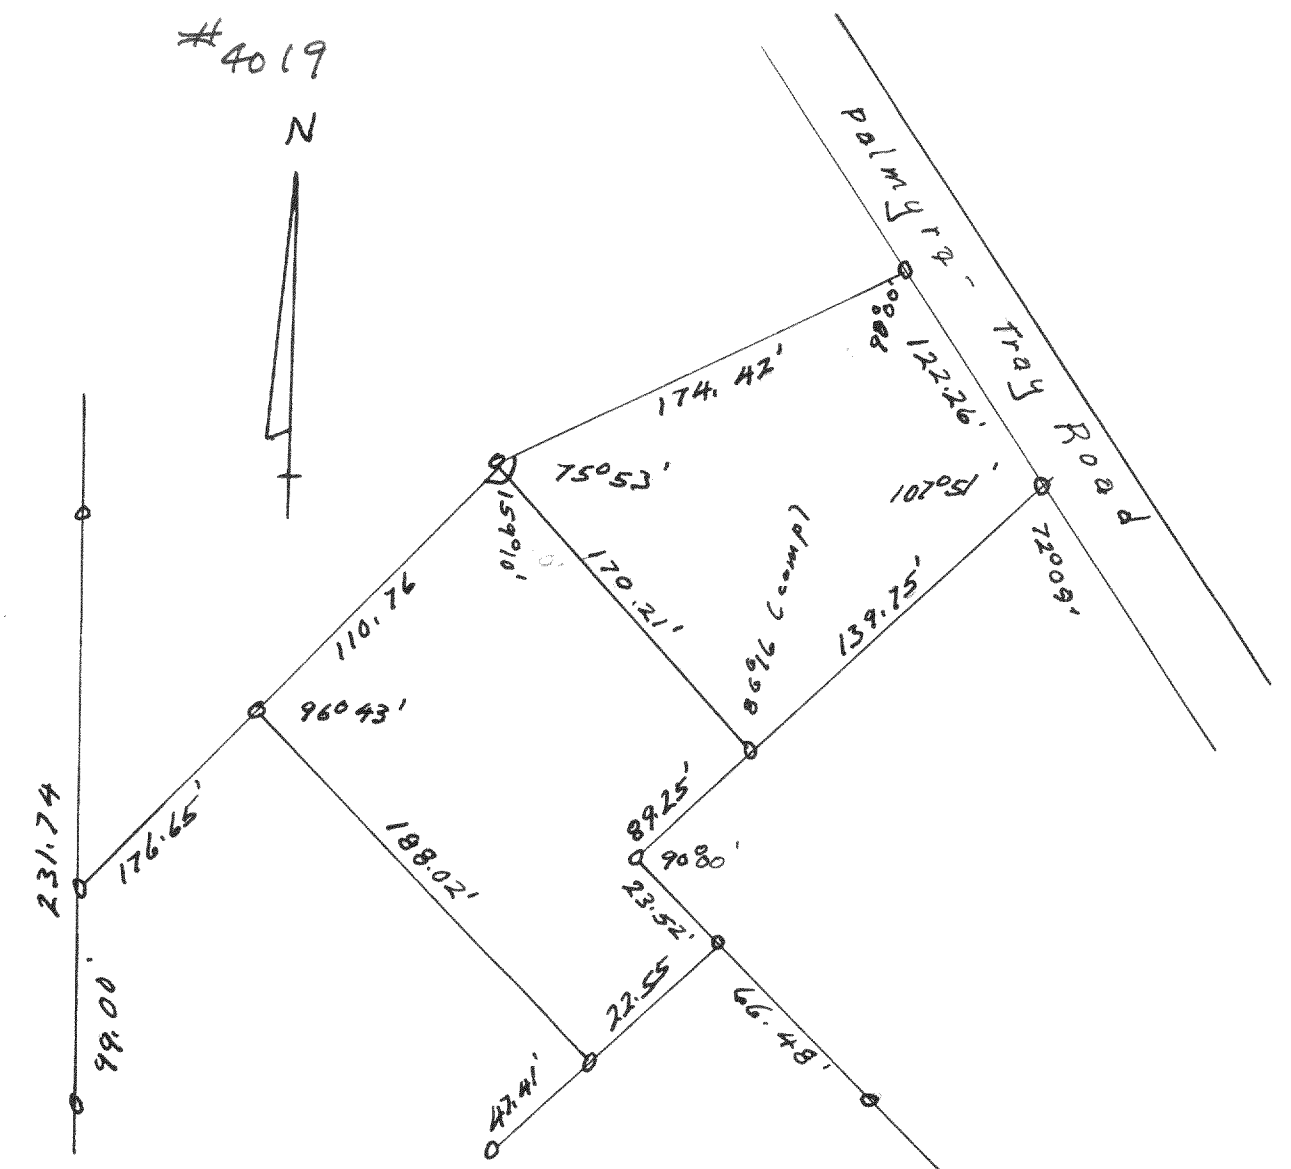

Survey in NW 1/4 Sec 6-4-17 (Little Prairie)
Date 4-19-61
Lloyd S. Jensen
(County Surveyor)

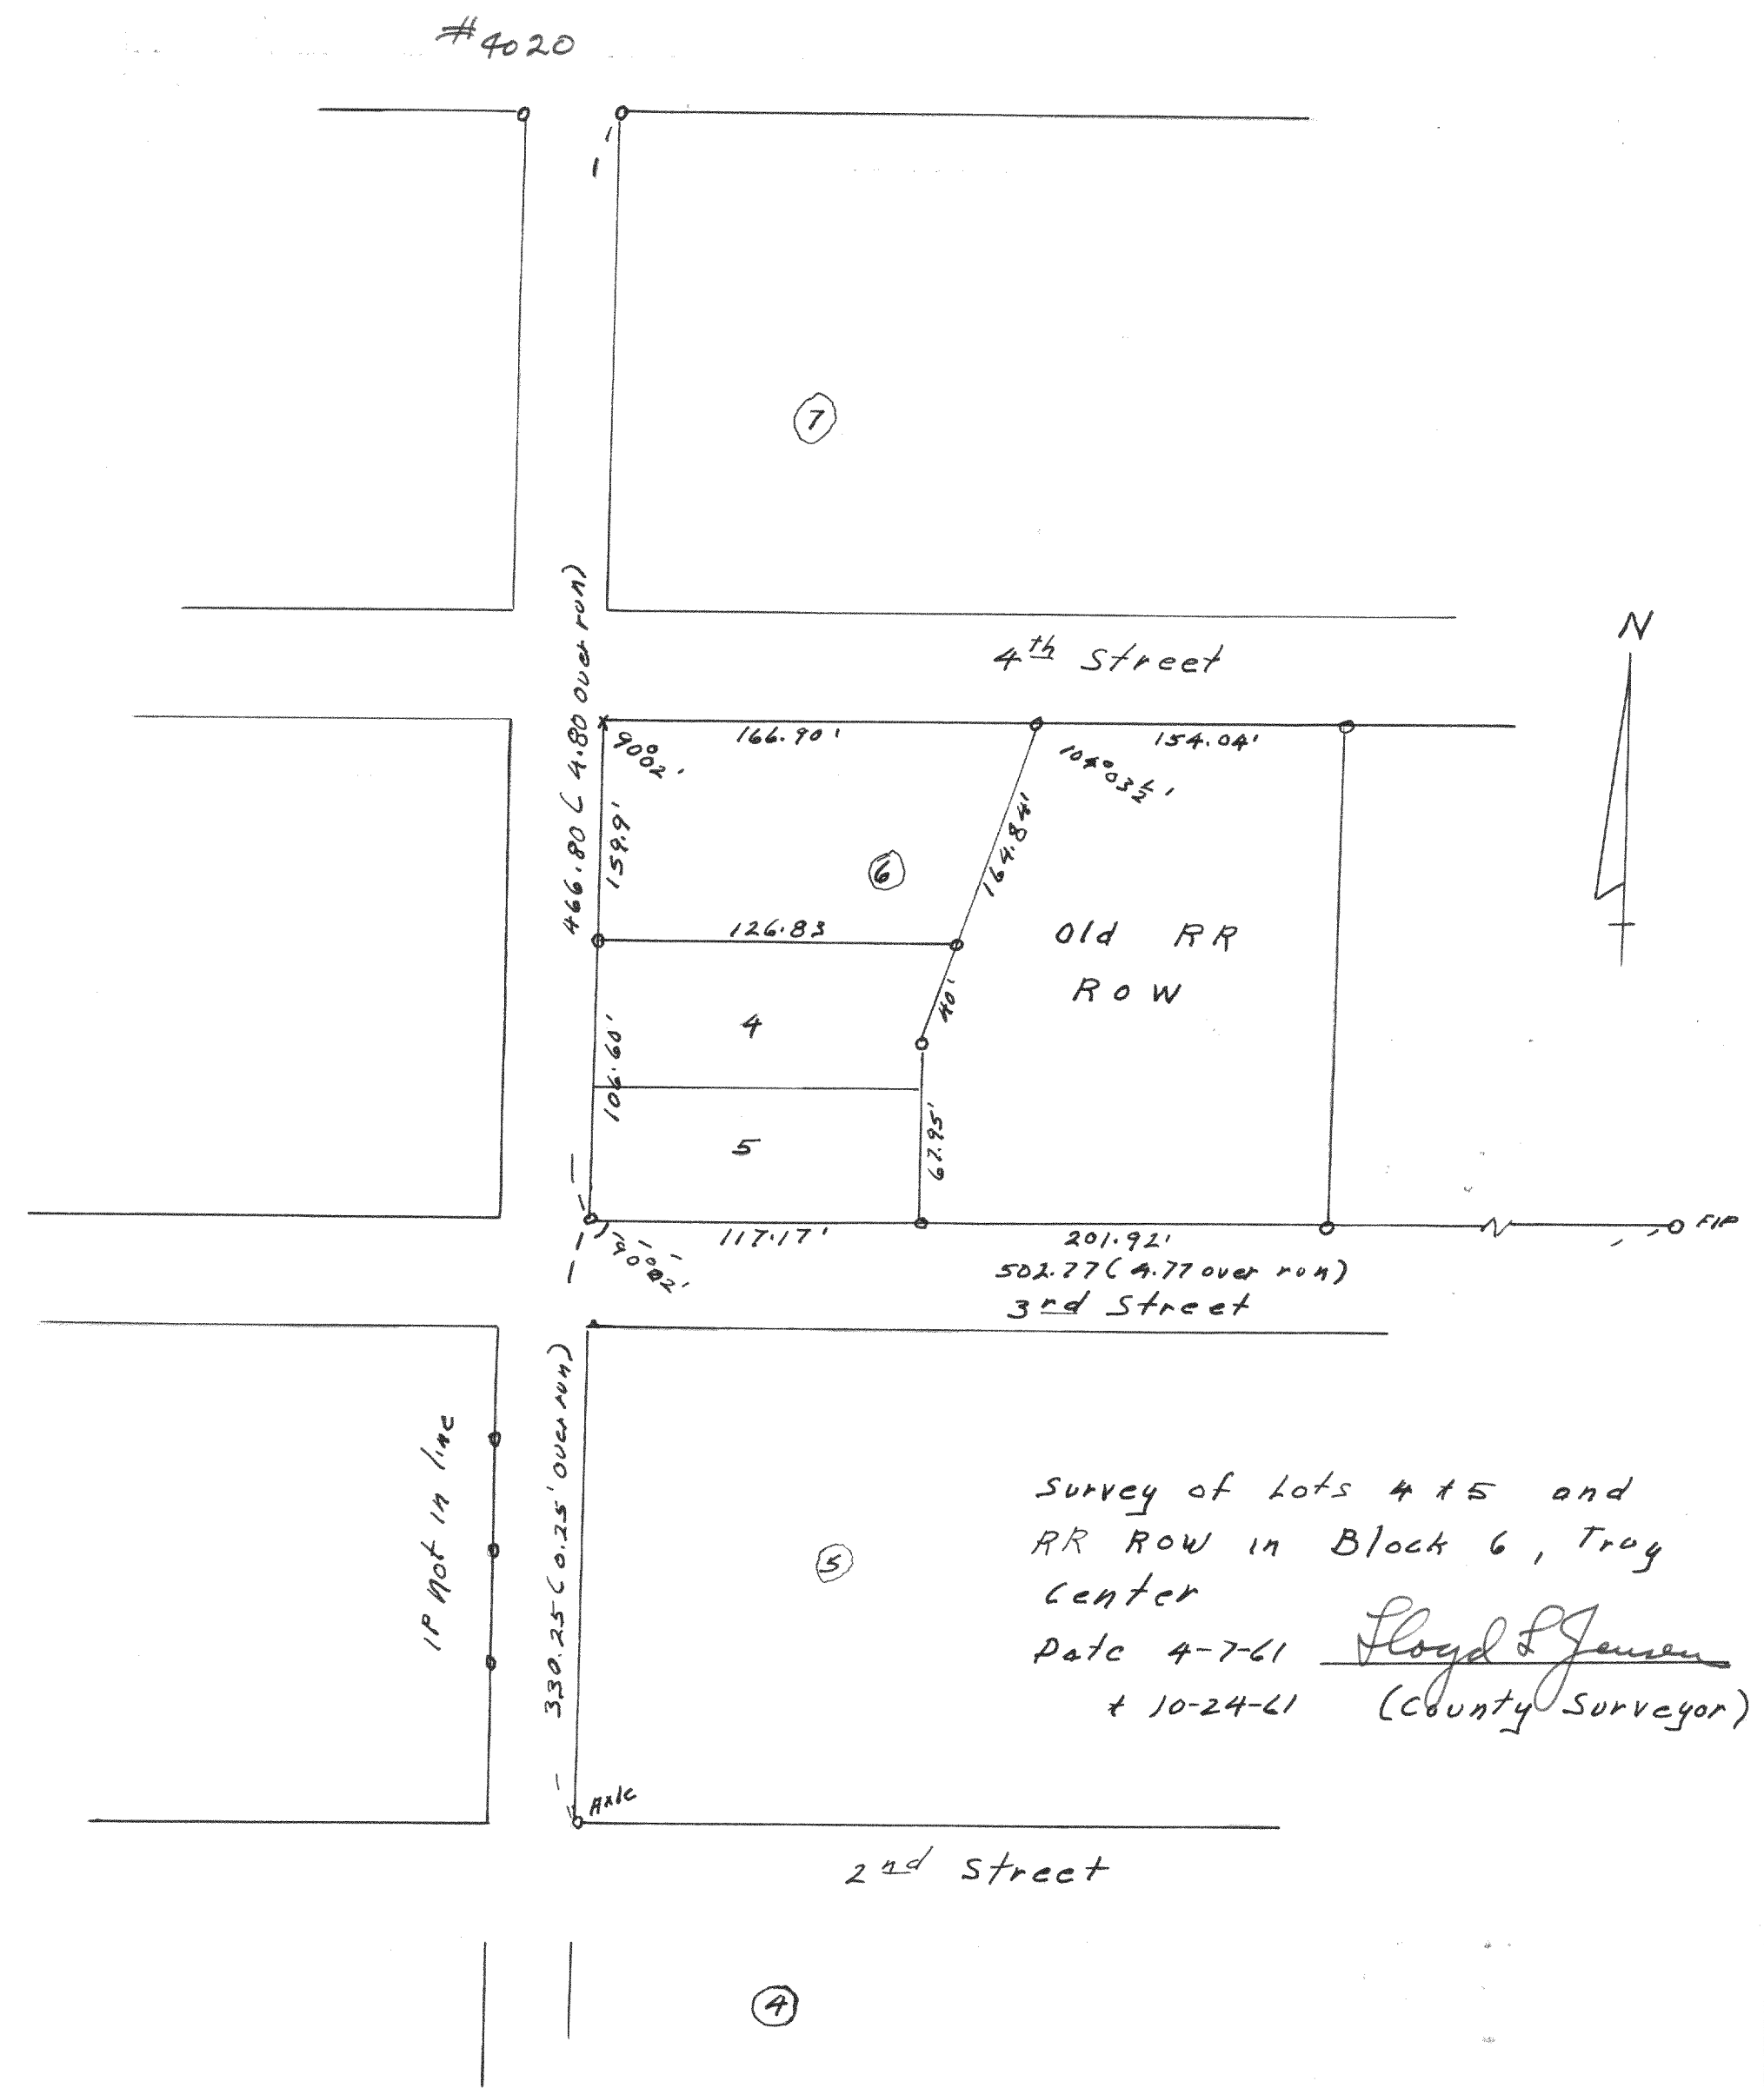

Survey of Lots 4 & 5 and
RR ROW in Block 6, Troy
Center
Date 4-7-61
+ 10-24-61
Lloyd S. Jensen
(County Surveyor)