


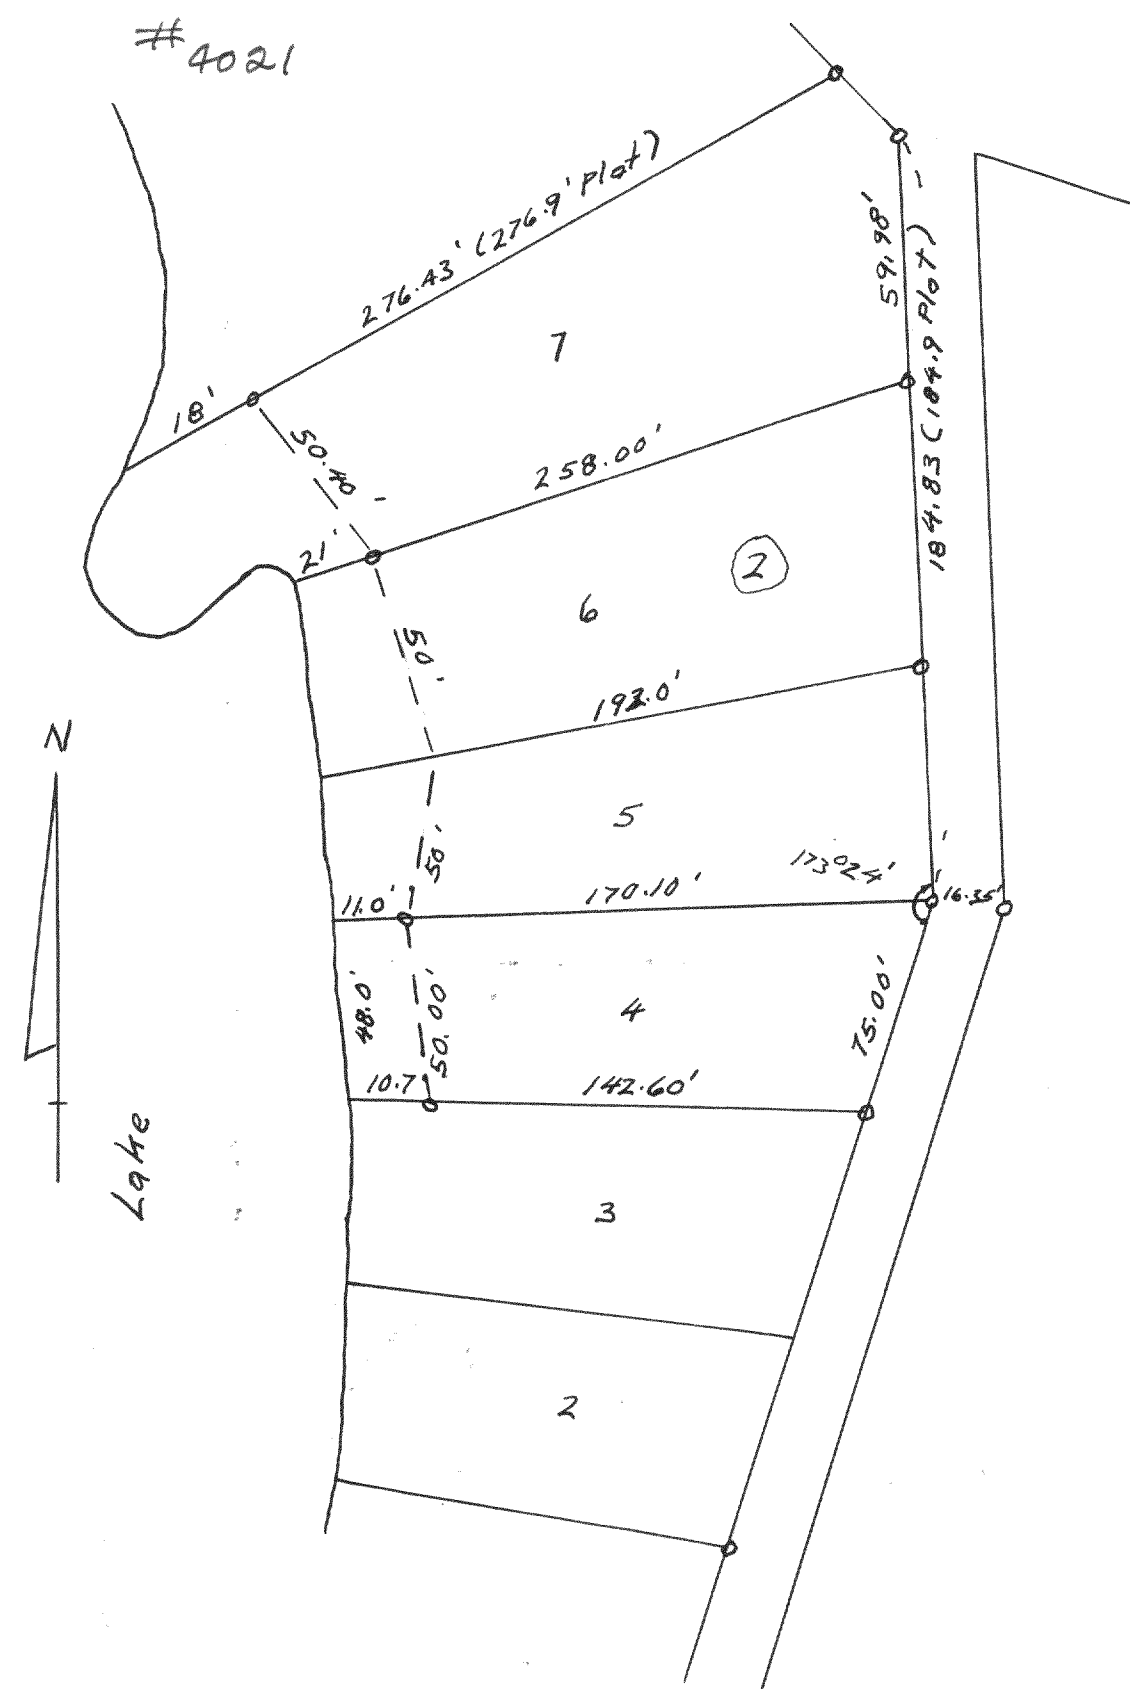

Survey of Lots 4 & 7 Block 2
 Swift Lake Subd, T4N, R17E
 Date 7-14-61 Lloyd L Jensen
 (County Surveyor)

#4022

