


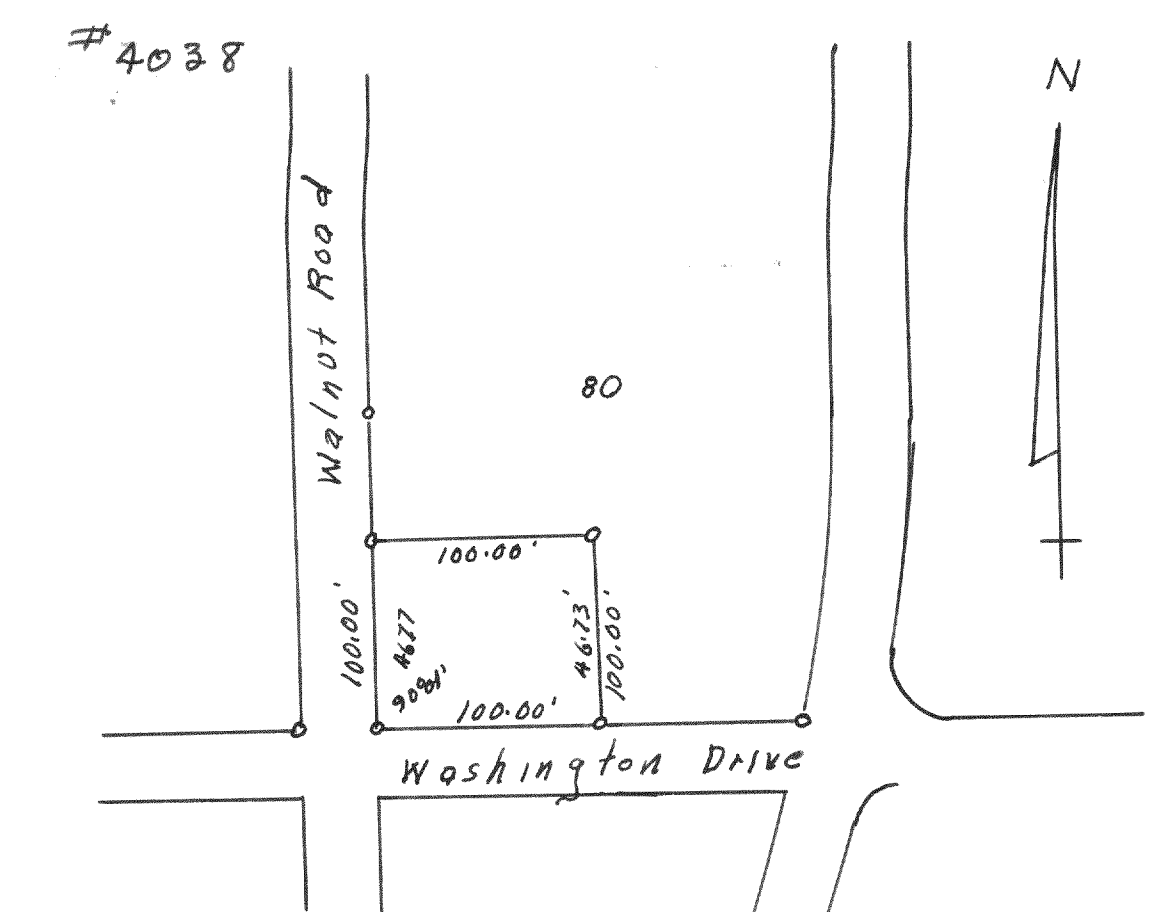


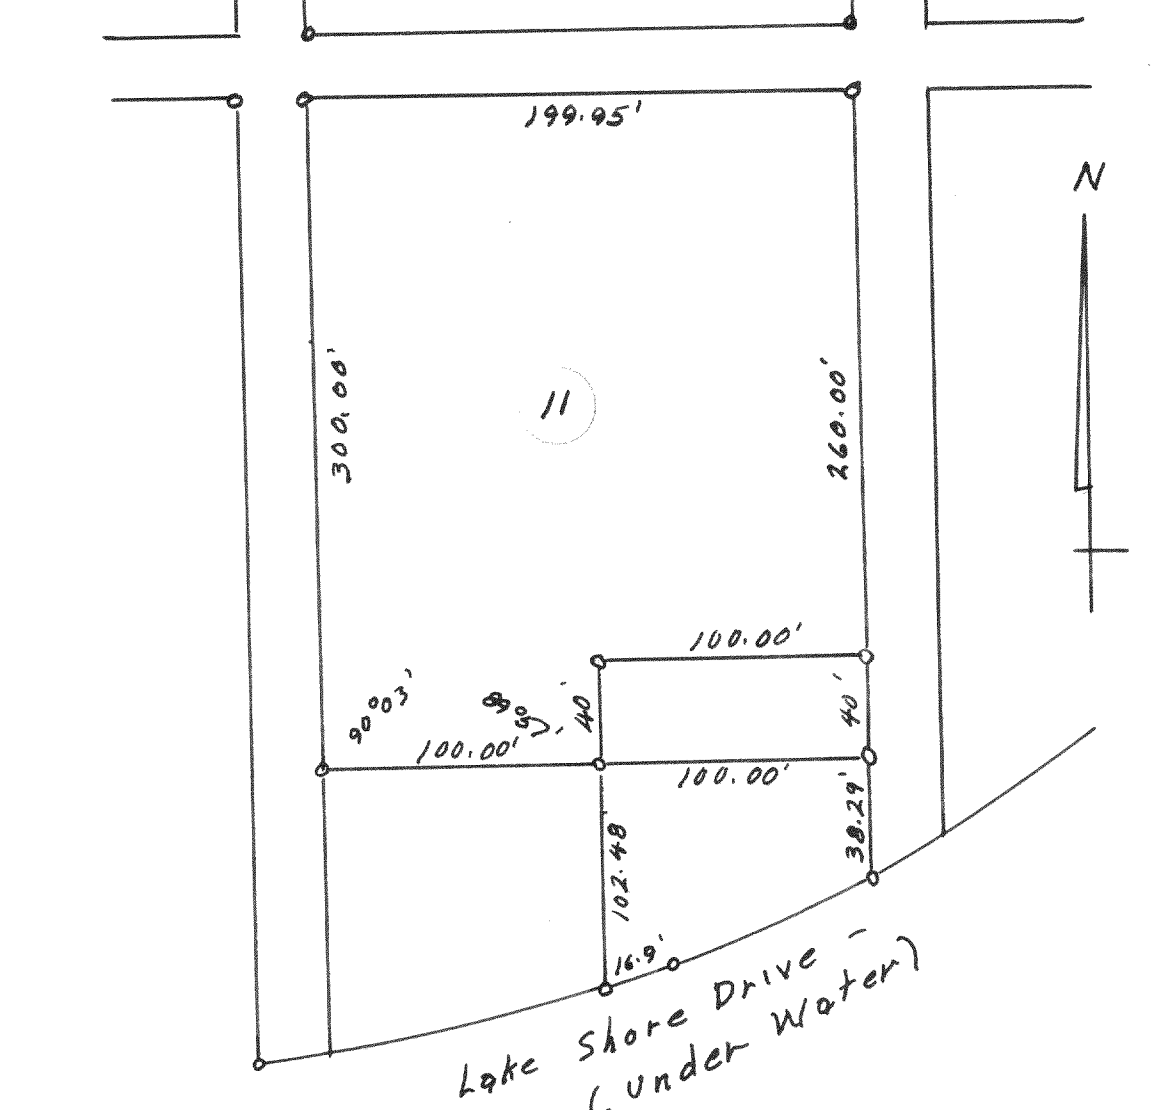

Survey of Lots 4673-77, Block 80, Lake Como Beach, T2N, R17E  
Date 9-14-61 Lloyd L Jensen  
(County Surveyor)

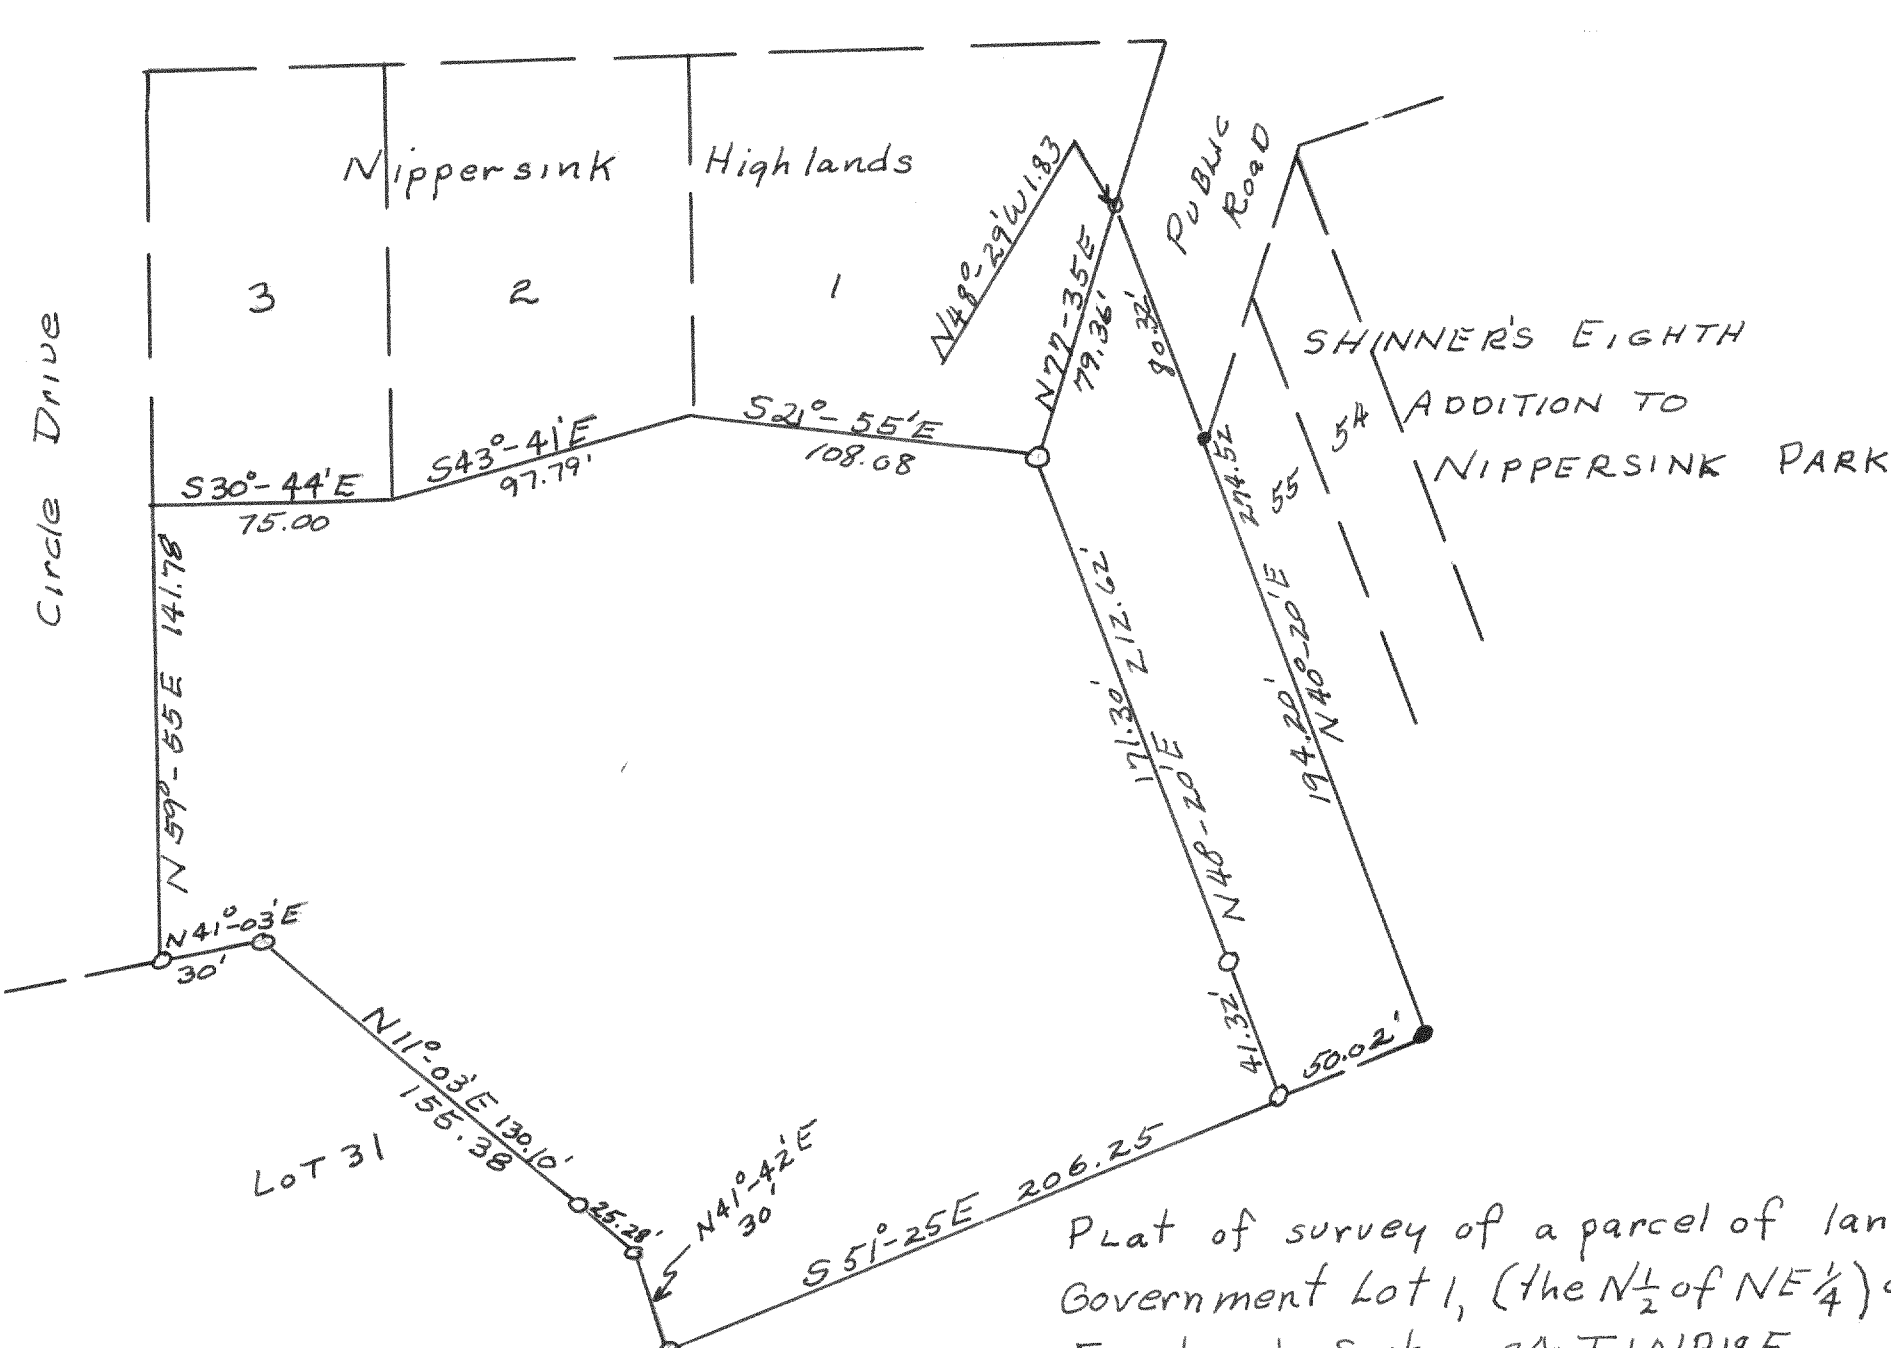

Survey in Block 11, Lake Como Beach, T2N, R17E  
Date 9-27-61 Lloyd L Jensen  
(County Surveyor)

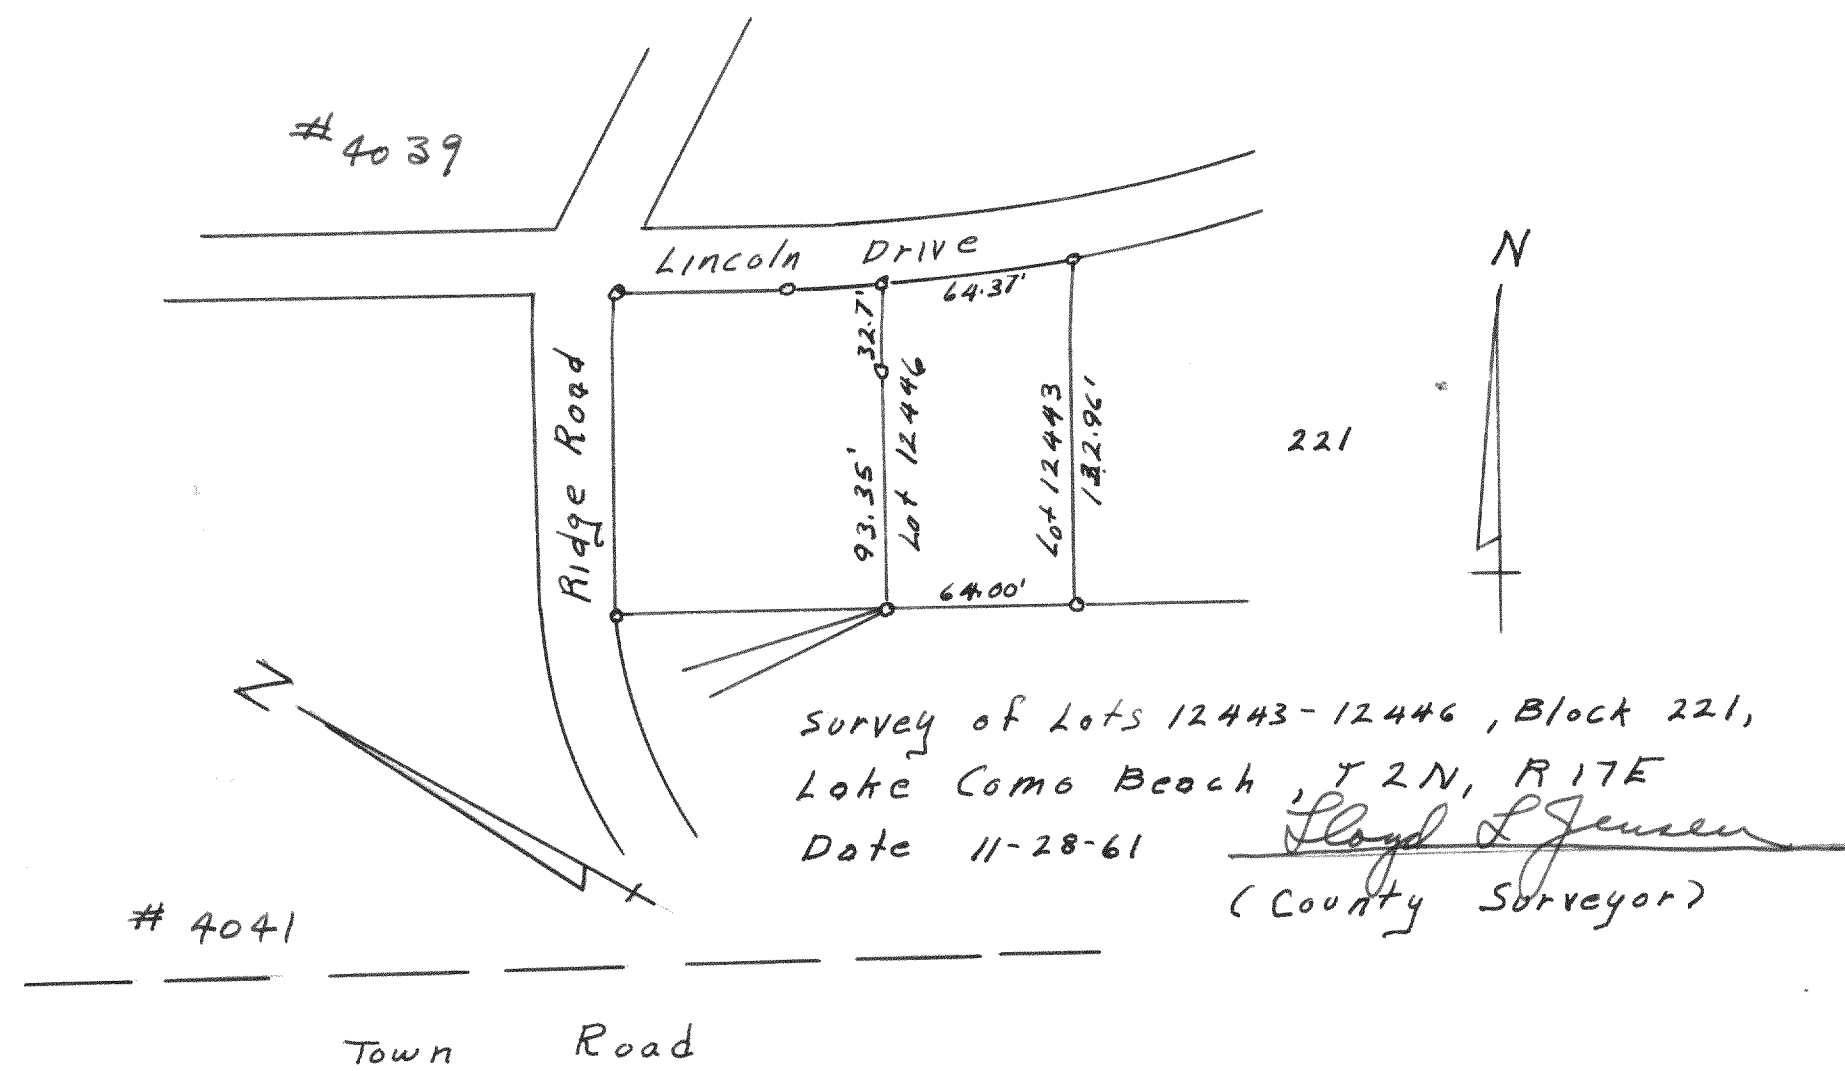

Plat of survey of a parcel of land in Government Lot 1, (the N 1/2 of NE 1/4) of Fractional Section 24, T1N, R18E.  
Feb. 1962 Lloyd L Jensen  
County Surveyor