


326 PLAT OF SURVEY OF
LOT 6, BLOCK 2, RIDGWAY-MARTIN
ADDITION TO THE CITY OF ELKHORN
IN THE SE $\frac{1}{4}$ OF SECTION 36,
T3 N, R 16 E, WALWORTH COUNTY
WISCONSIN


#4050

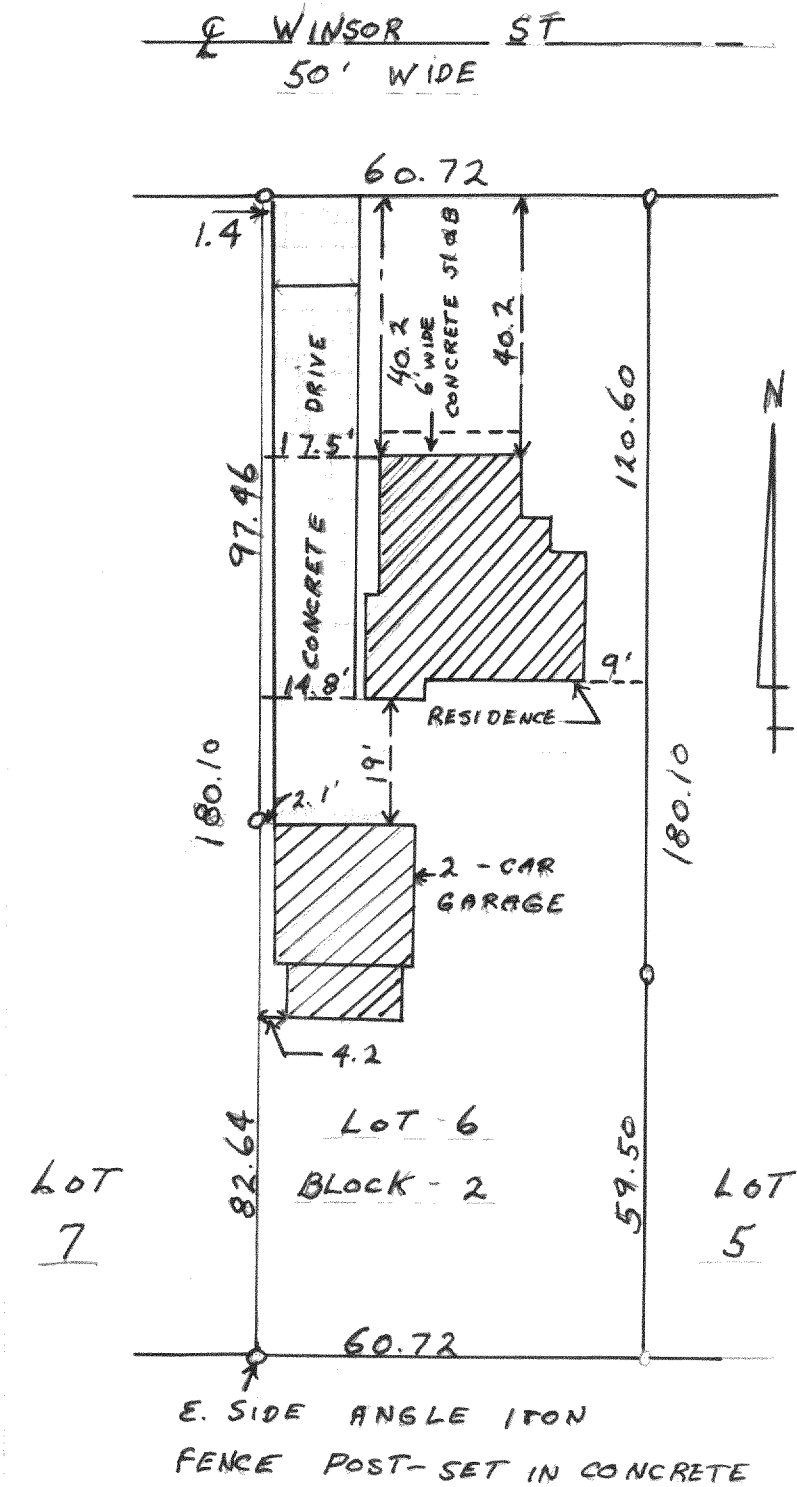

MAR, 1963 Lloyd L. Jensen
WAL. CO. SURVEYOR

#4051


PLAT OF SURVEY OF
EAST 75' LOT 32 LOCH VISTA CLUB
SUBDIVISION NO 1,
WILLIAMS BAY, WISCONSIN

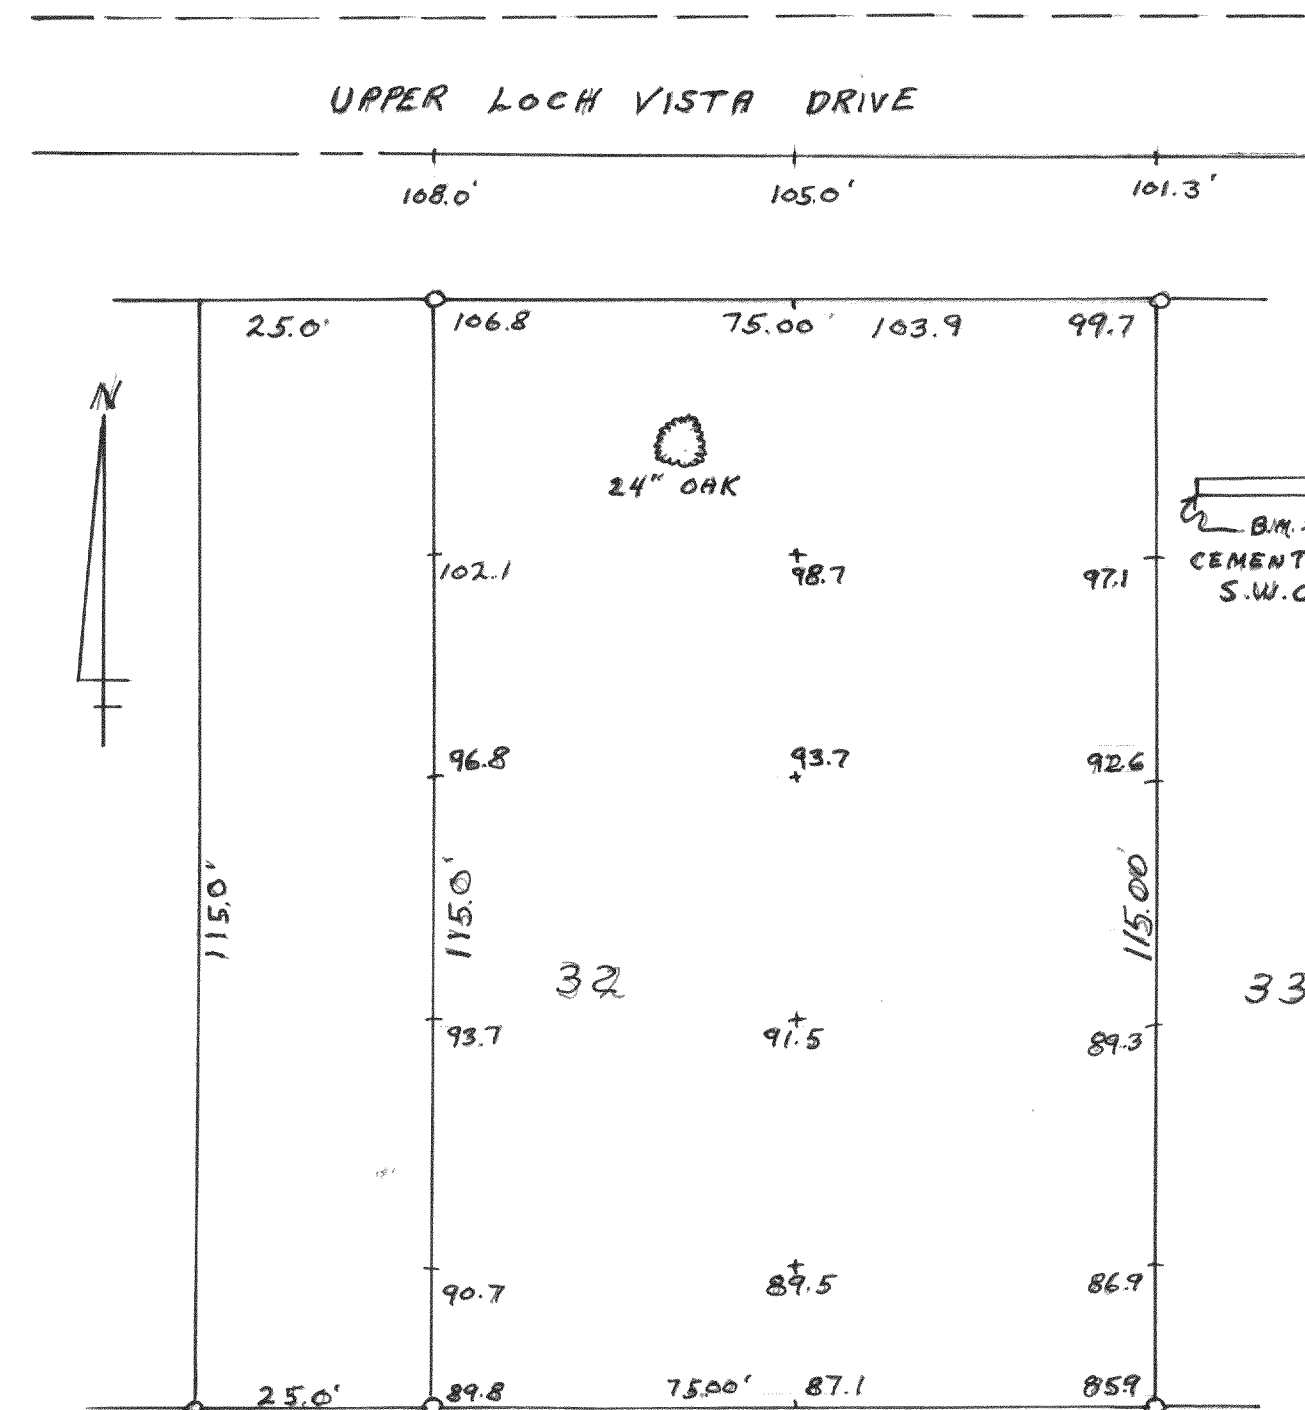

MAR. 63 Lloyd L. Jensen
WAL. CO. SURVEYOR

#4052

PLAT OF SURVEY OF
LOT 12 MCGRAW'S PARK SUBDIVISION
LOCATED IN THE NE $\frac{1}{4}$ OF SECTION 9,
T4 N, R 18 E, WALWORTH COUNTY, WISCONSIN

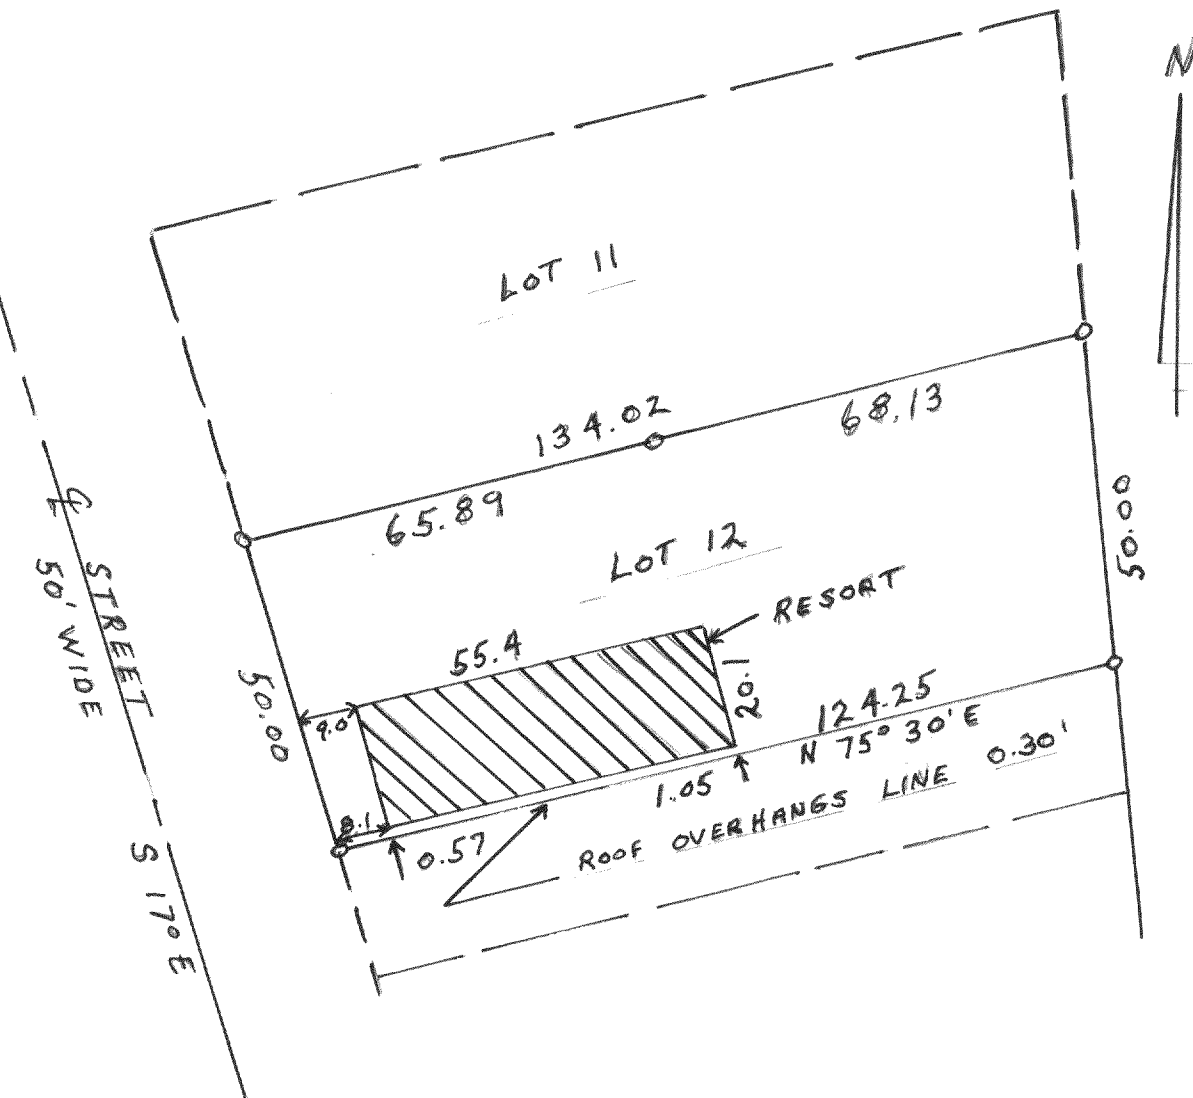

APR. 1963 Lloyd L. Jensen
WAL. CO. SURVEYOR