


4057

PLAT OF SURVEY OF
^{LOT 9}
 Lymndale Subdivision SE ¼
 NW ¼ & SW ¼ NW ¼ Sect 20, T4N
 R18E VILLAGE OF EAST TROY
 WALWORTH COUNTY, WISCONSIN

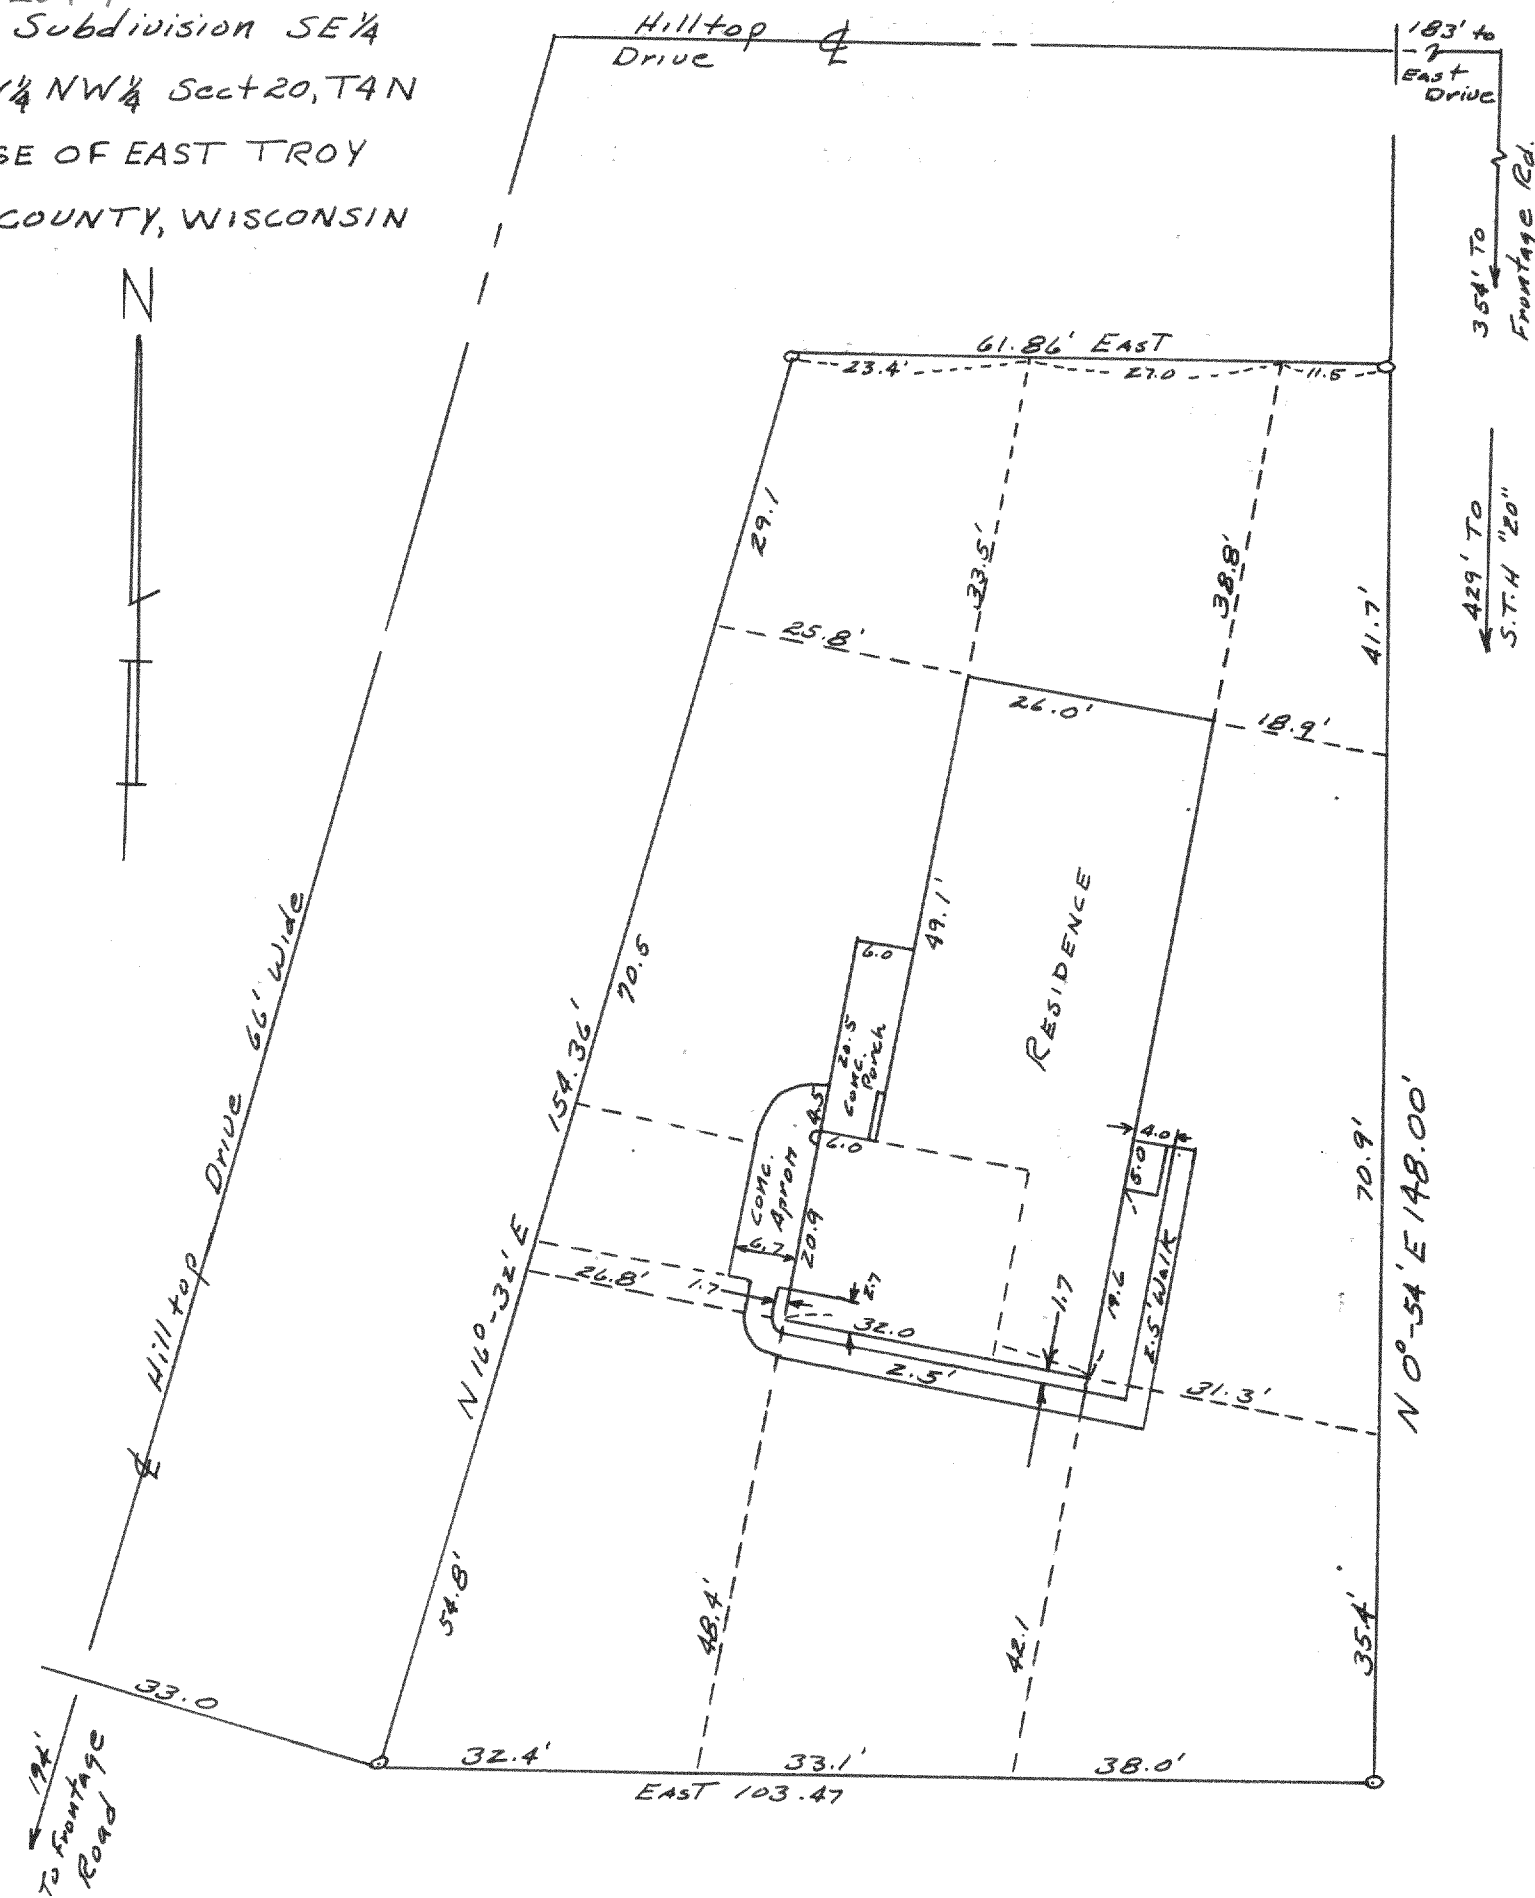


September 26, 1962

Lloyd L Jensen
County Surveyor

4058

PLATE OF SURVEY OF
Lands located in the SW $\frac{1}{4}$ of Section 5,
T4N - R15E Walworth County, Wisconsin

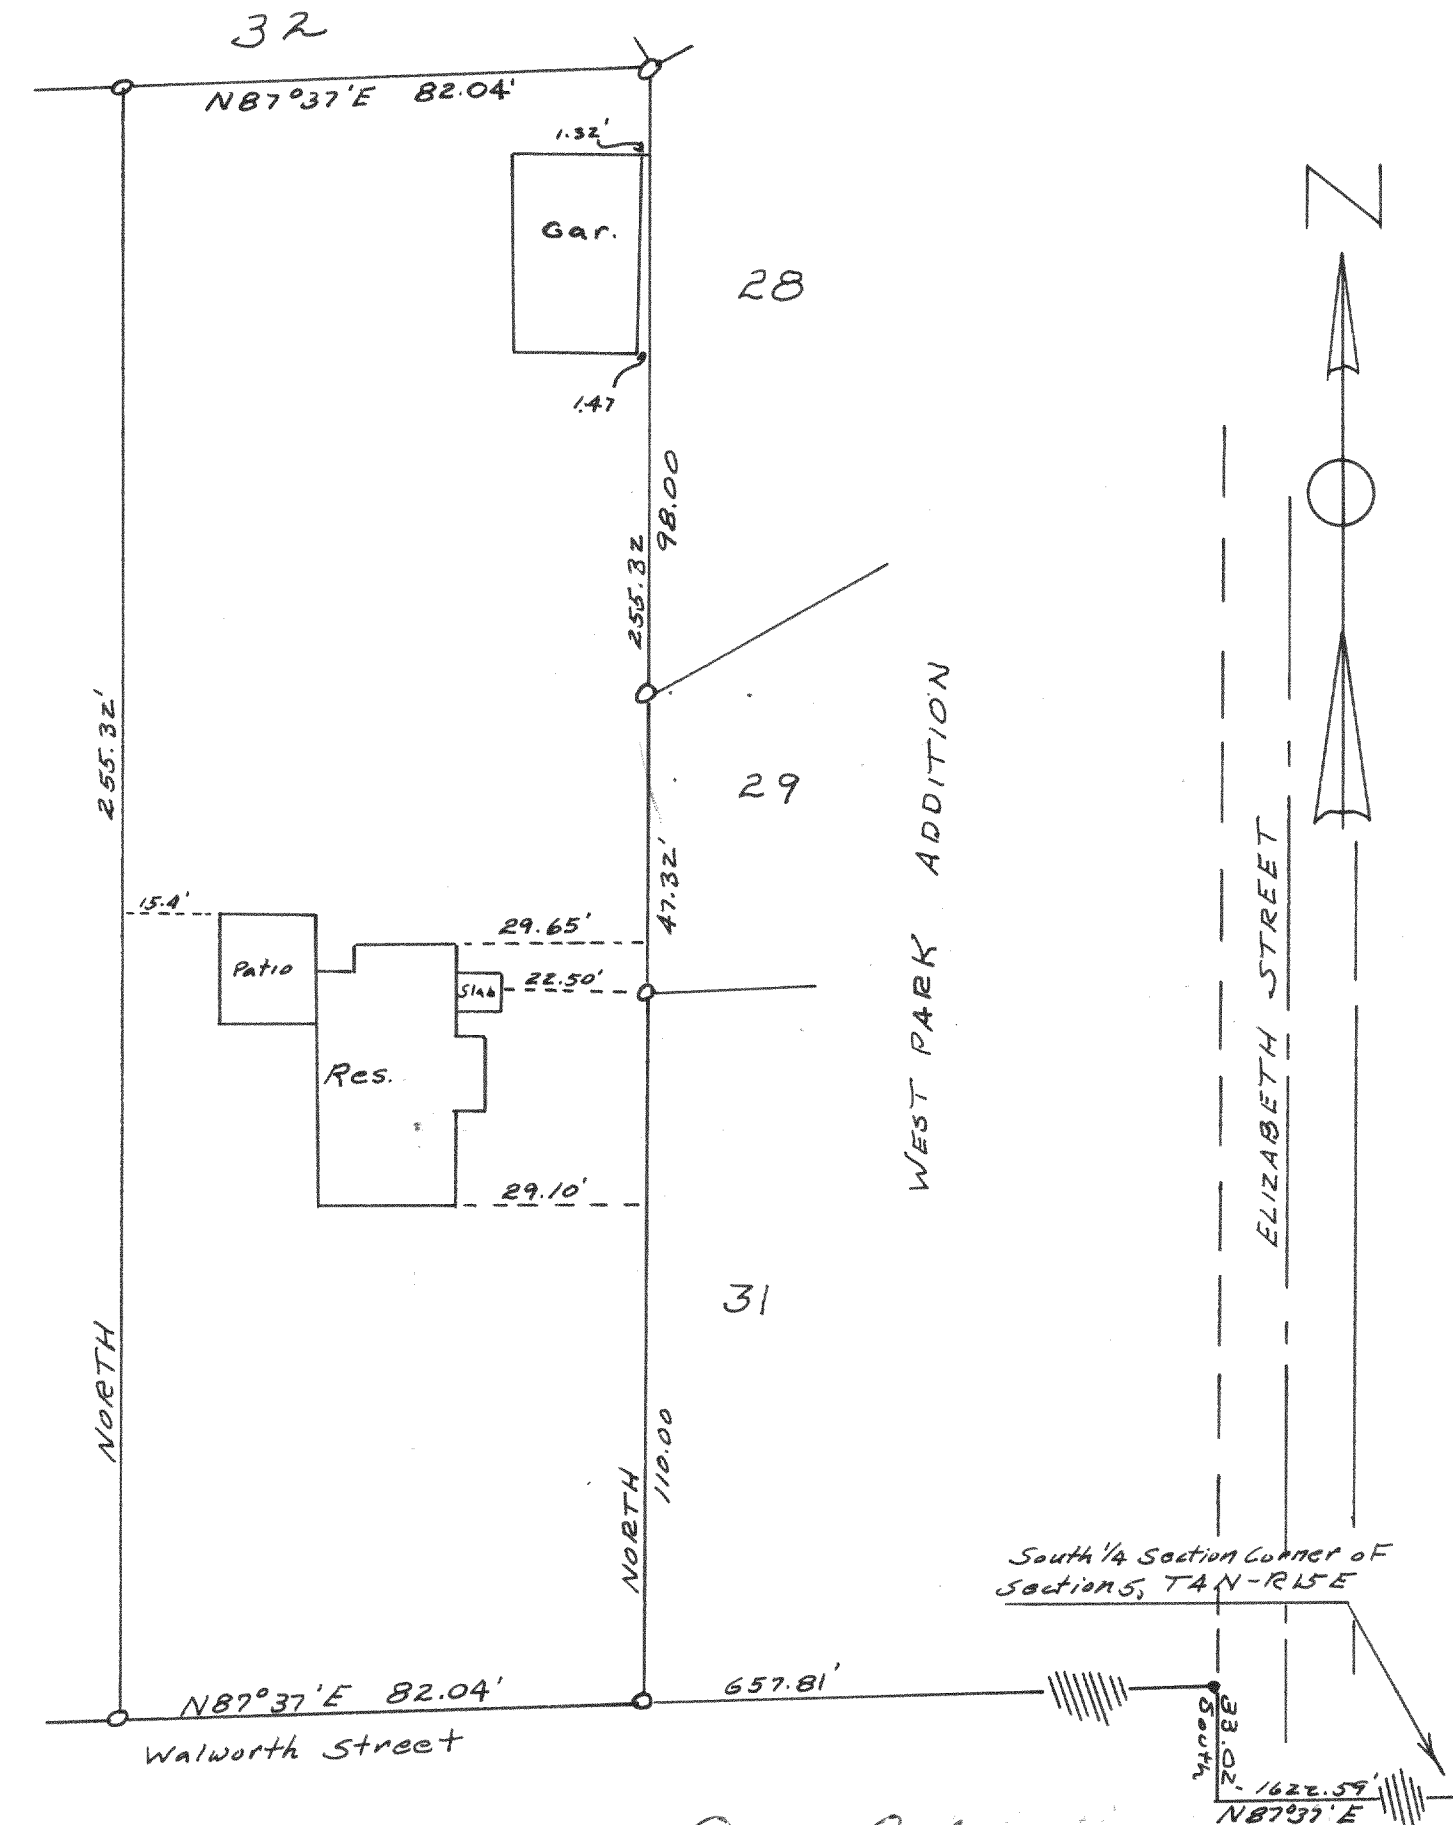

August 1962

Lloyd L Jensen
County Surveyor