


4061

PLAT OF SURVEY OF
LOT 1 OF Block 32 OF The Original Plat
Except The North 73 Feet And Lot 4,
Block 32, Rockwells 1st Addition To
The City of Ekhorn
WALWORTH COUNTY, WISCONSIN

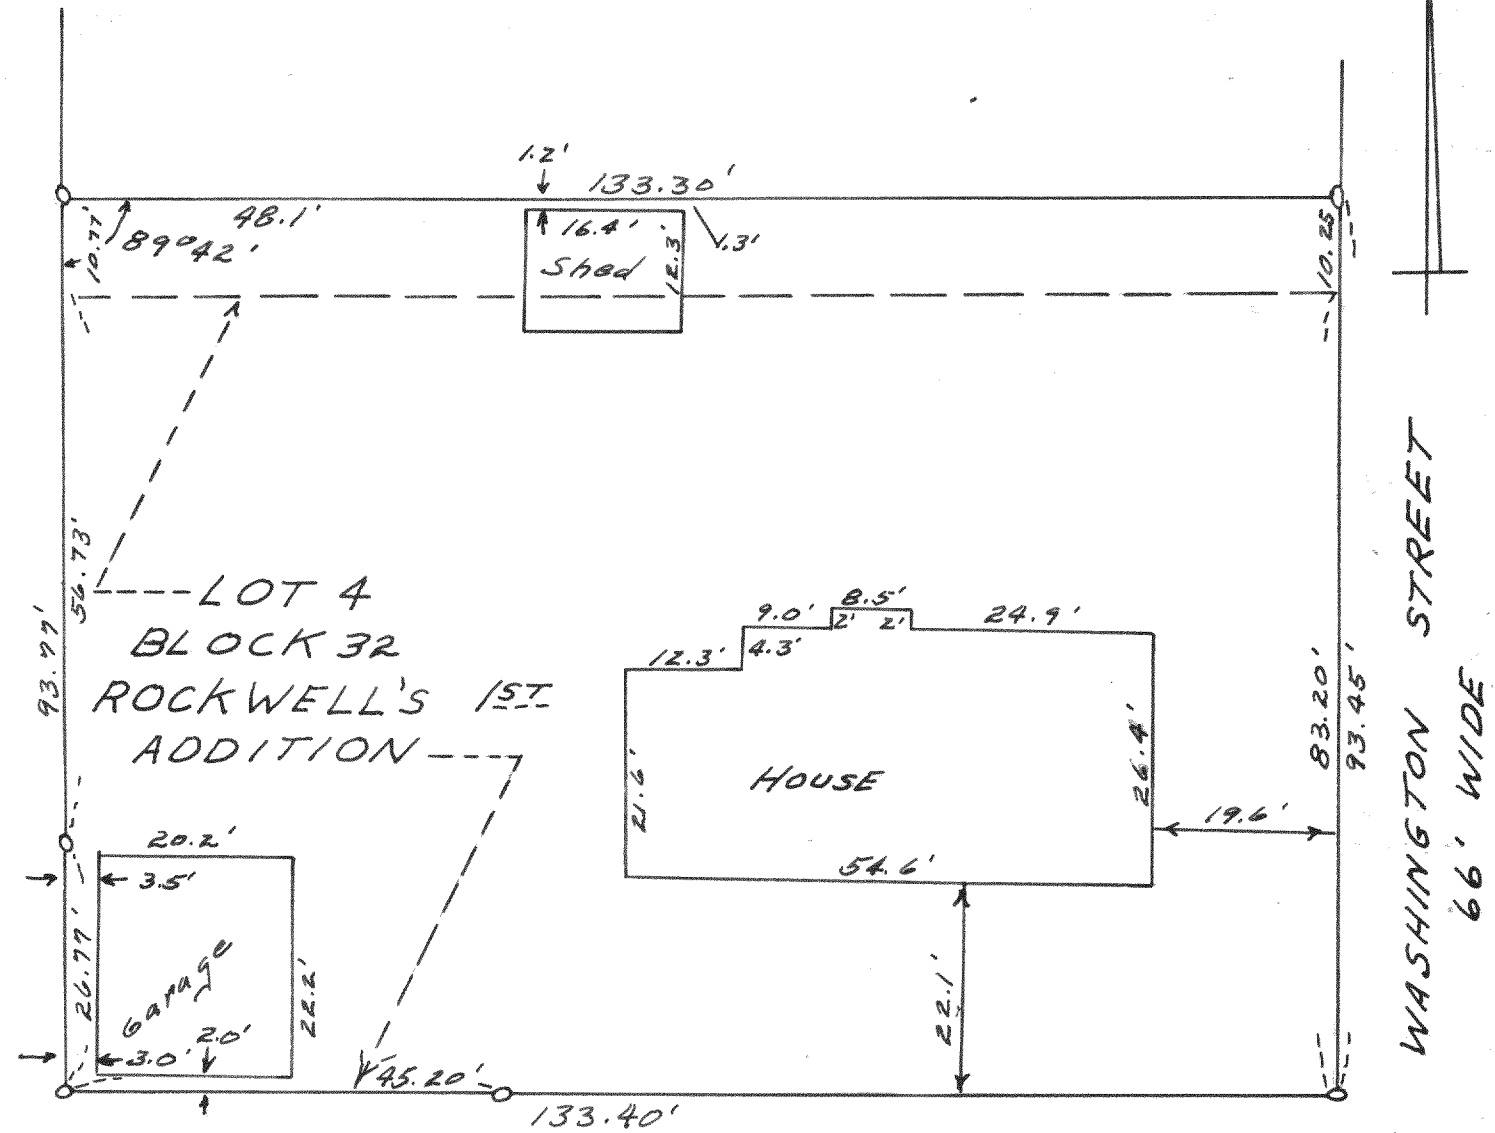


August 1962

Lloyd L Jensen
County Surveyor

4062

PLAT OF SURVEY OF
Lot 20, Block 1, MIRAMAR Subdivision
Being a Part of the E 1/2 of Section 10
And the W 1/2 of Section 11, T4N, R18E
WALWORTH COUNTY, WISCONSIN

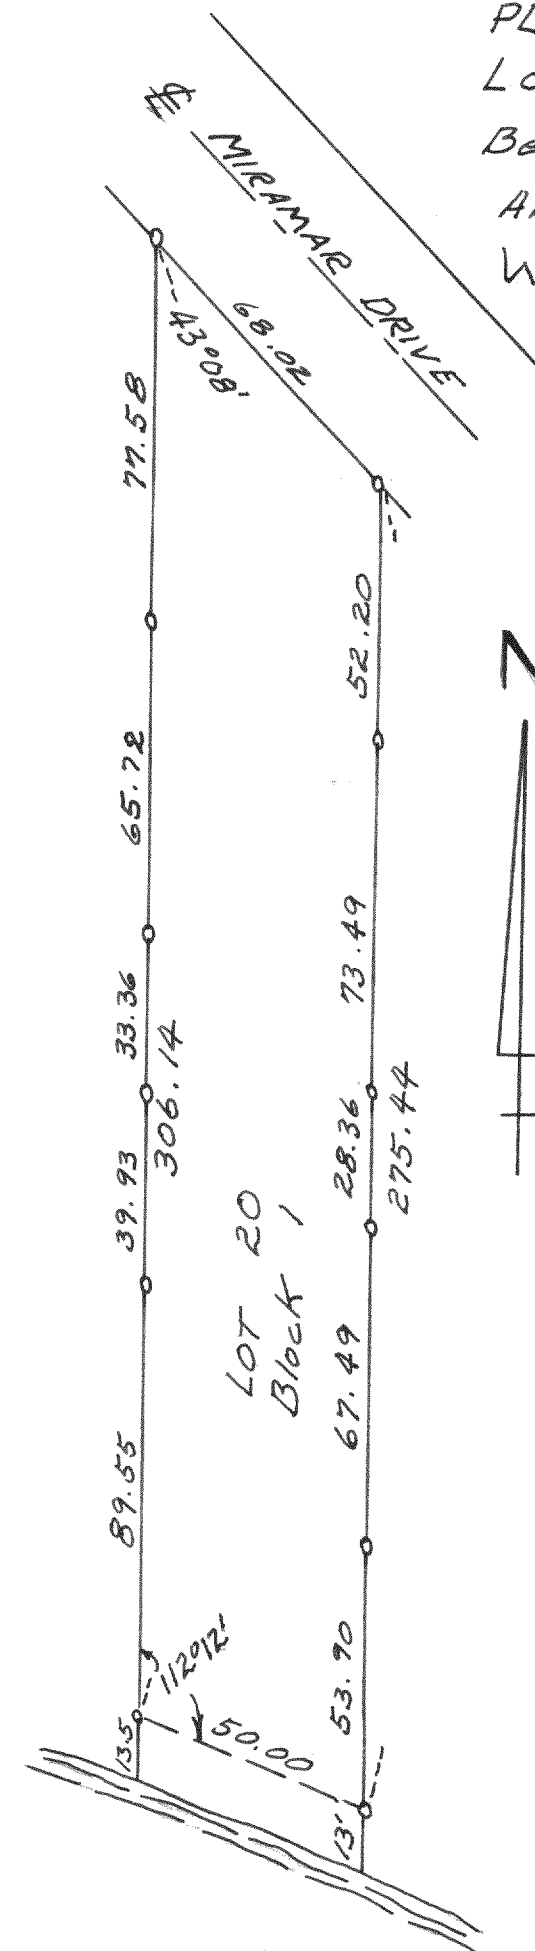

Potter Lake

September 1962

Lloyd L Jensen
County Surveyor