


4077


PLAT OF SURVEY OF
Lot 27 of the subdivision of block 6
of Indian Hills Subdivision,
Fontana-on-Geneva Lake, Walworth
County, Wisconsin

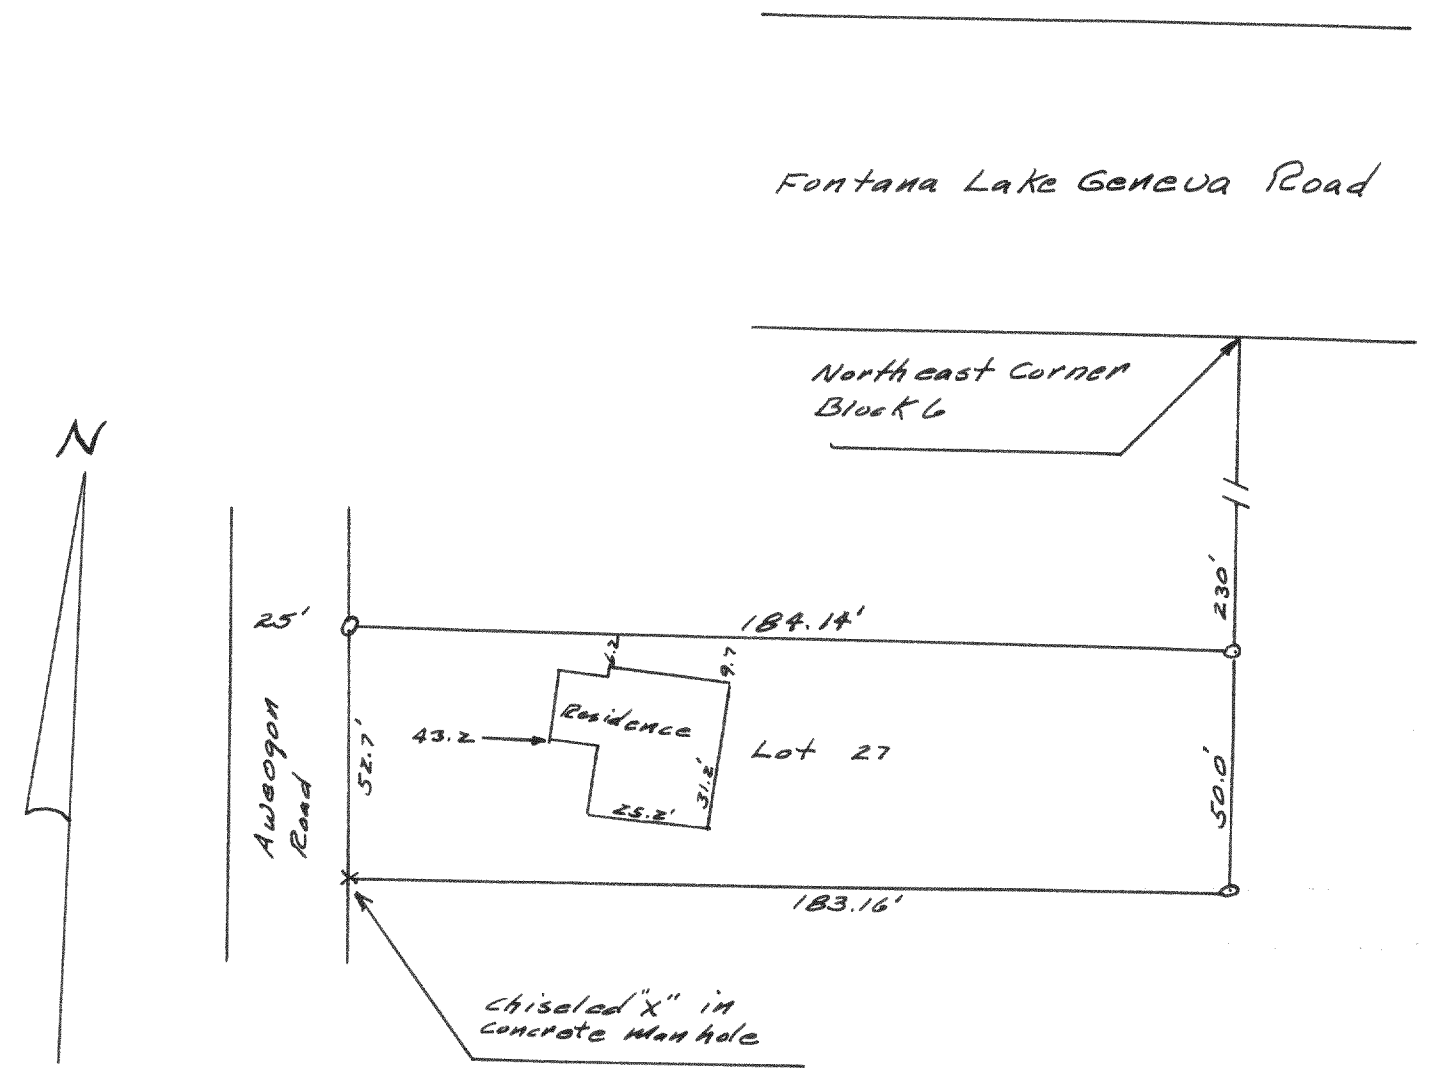

August 1962
Lloyd L Jensen
County Surveyor

4078

PLAT OF SURVEY OF
Lots 4221 to 4216 of Section 3 of Pell Lake
Subdivision, Walworth County, Wisconsin.

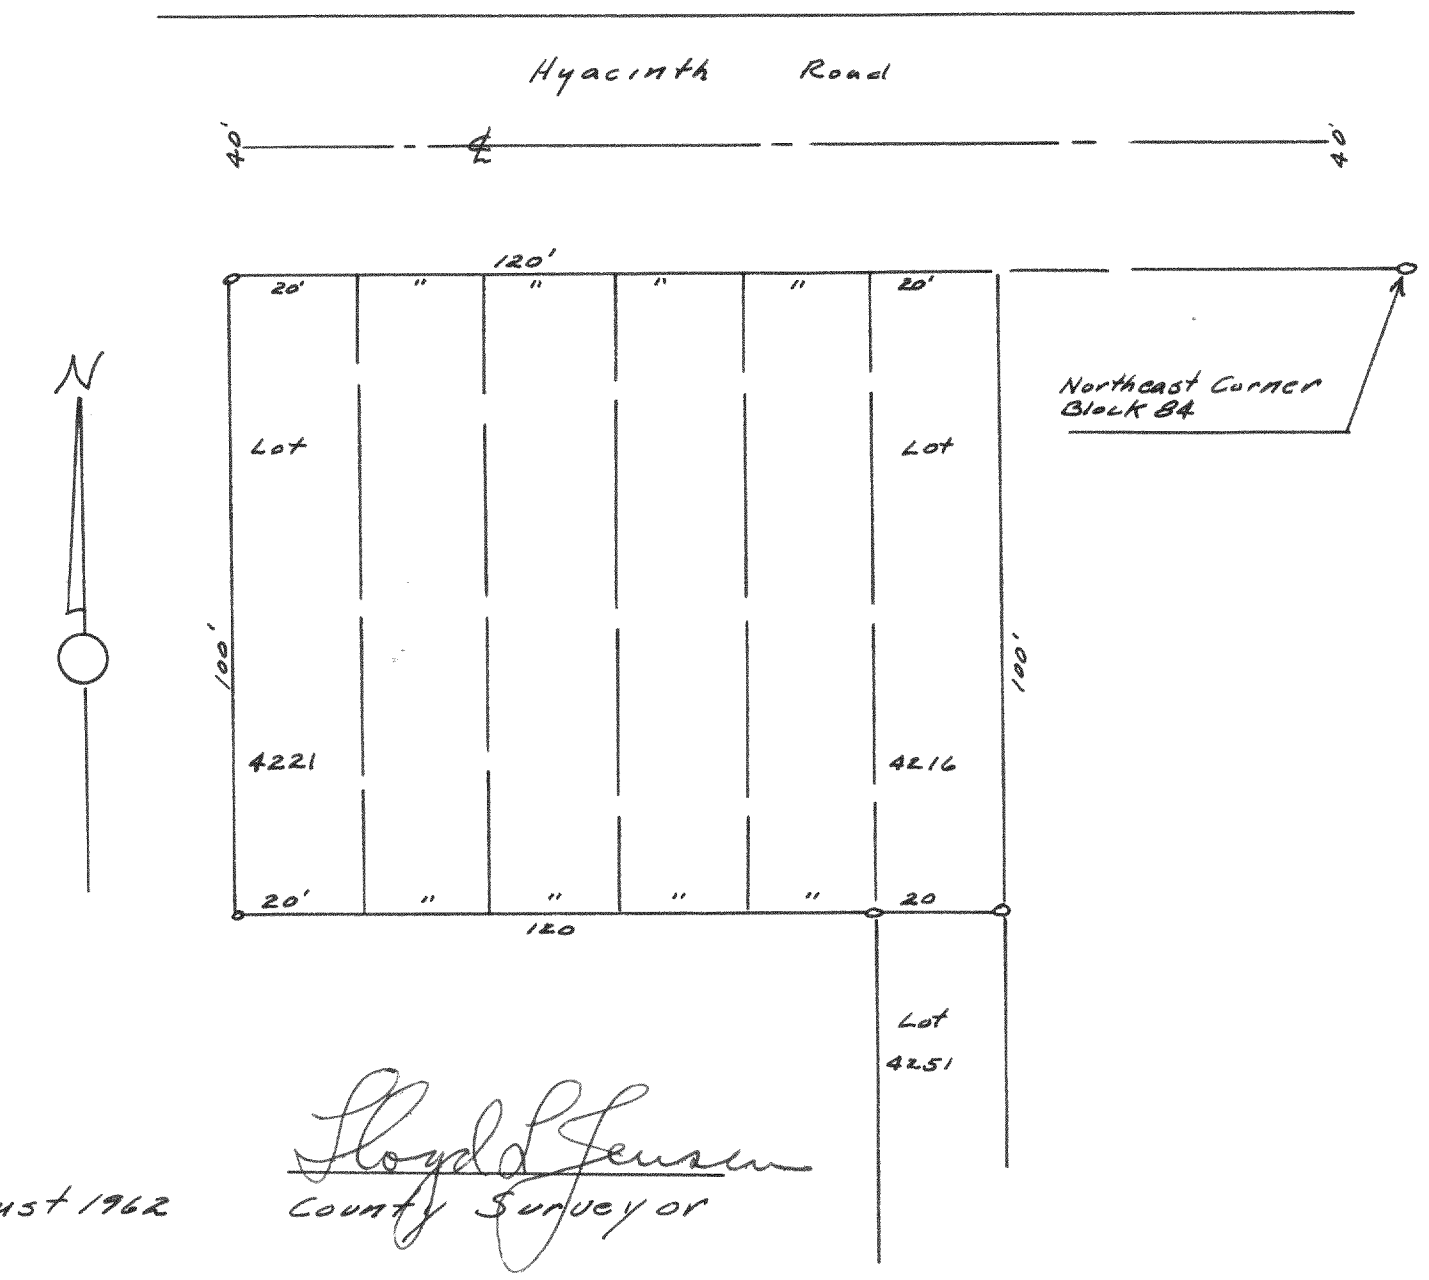

August 1962
Lloyd L Jensen
County Surveyor