


~~#~~ 4088

PLAT of SURVEY of
LOTS 89, 90, 91, 92, & 93 - BUENA VISTA,
VILLAGE of FONTANA, WALWORTH COUNTY,
WISCONSIN

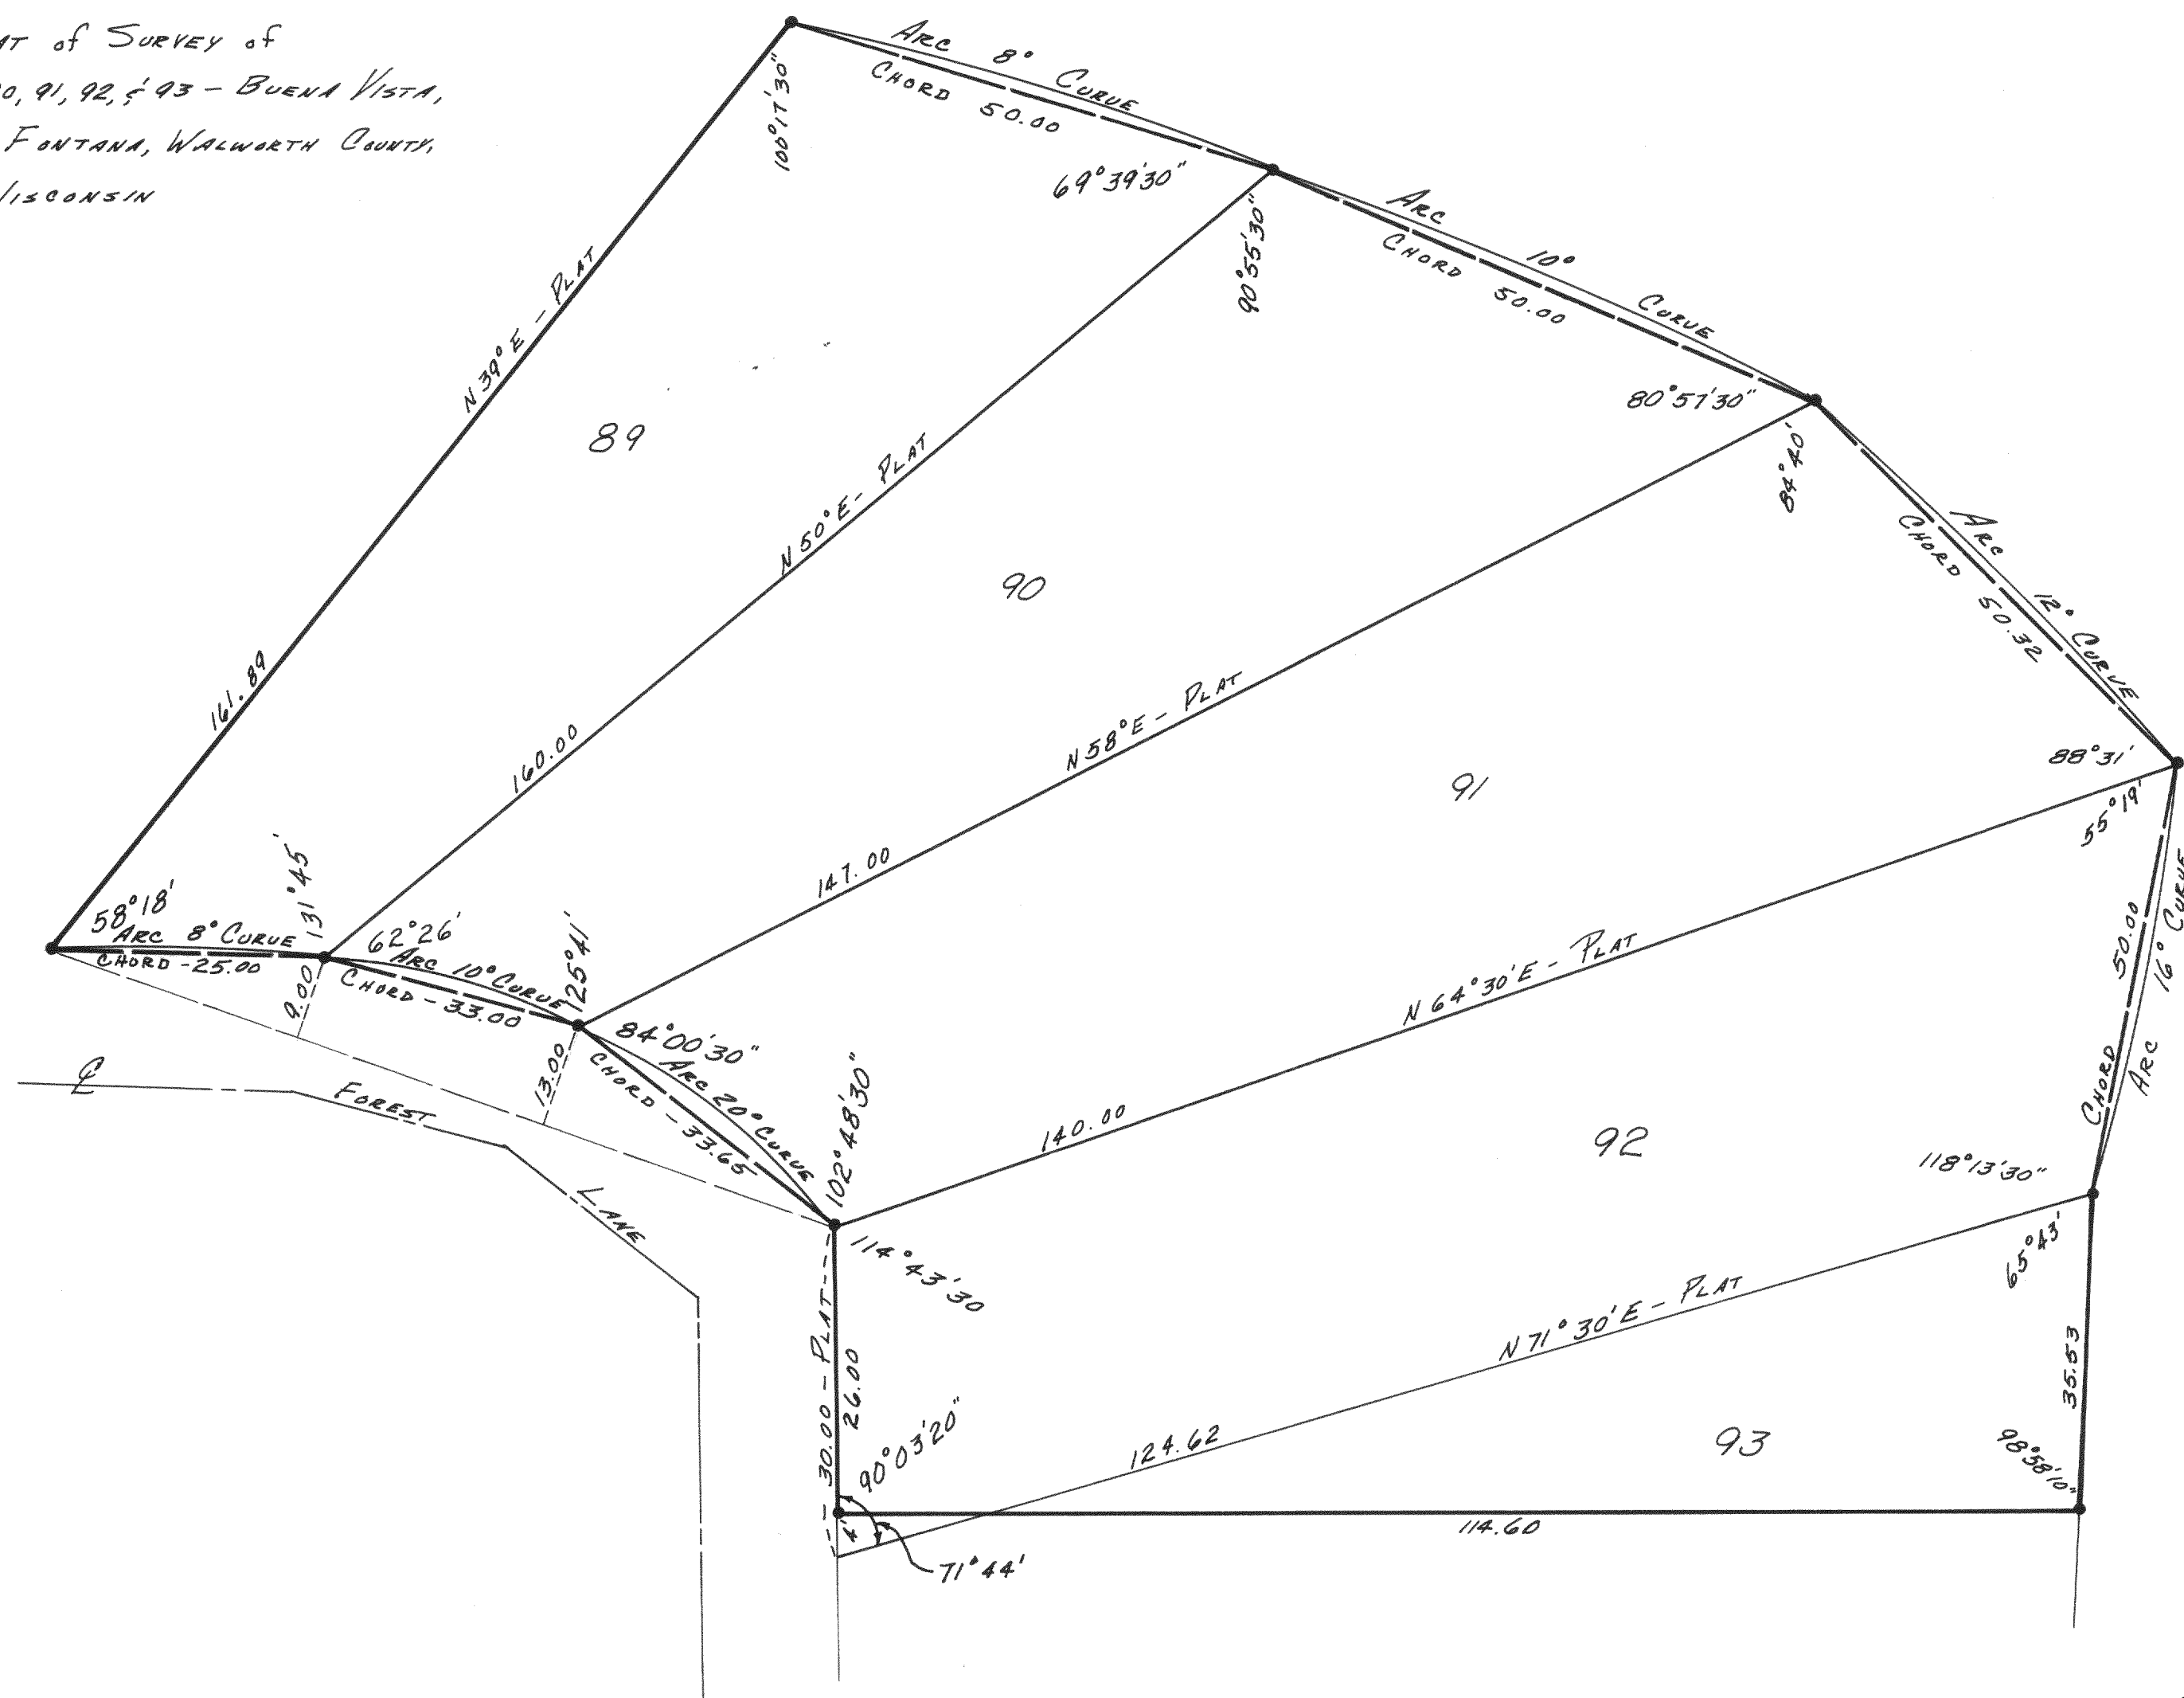

JUNE 1962 Roy L. Gerson
WGL CO. SURVEYOR