



2754

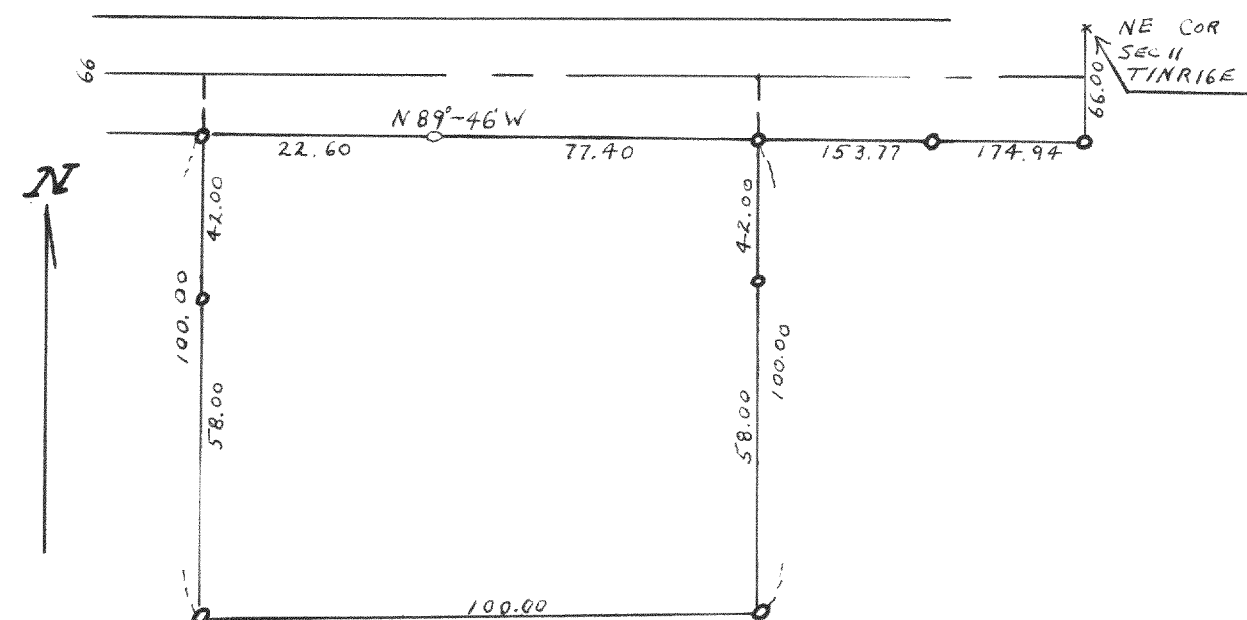


Plat of survey of land located in
NE 1/4 Sec. 11 T19R16E
Aug., 1953 LLV
CS

2755

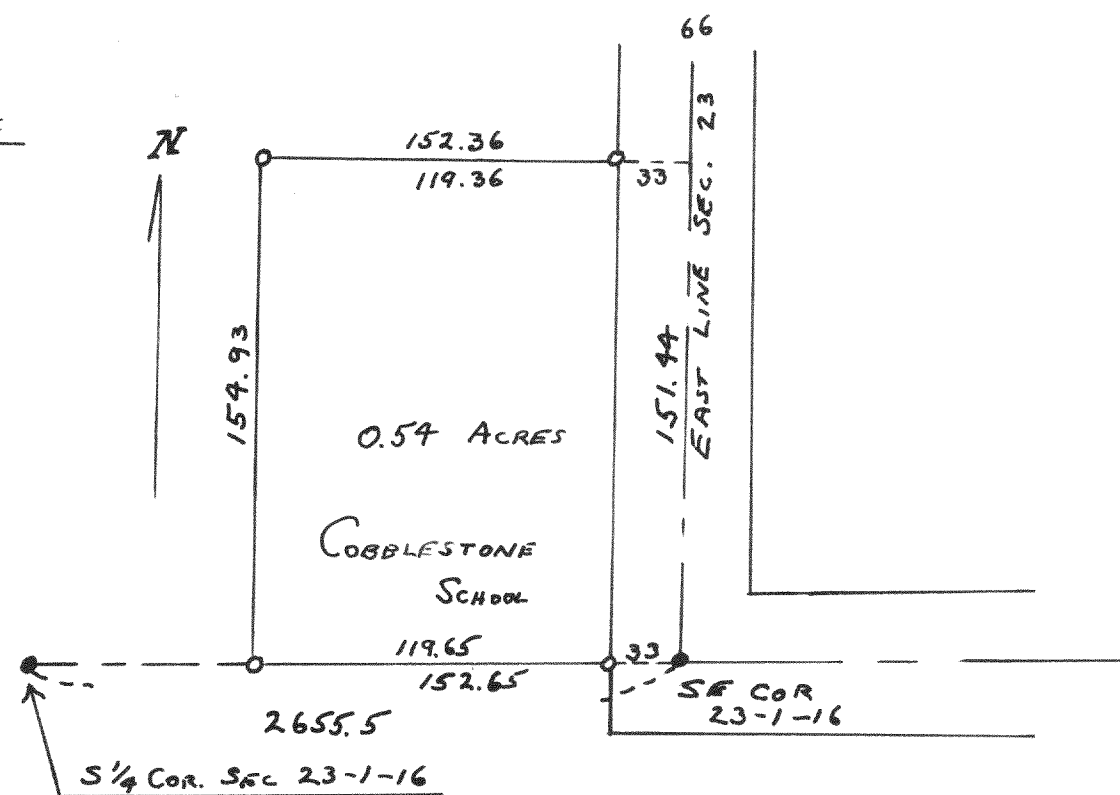


Plat of survey of Parcel in SE 1/4
of Sec. 23, T19R16E
July 1953 LLV
CS

2756

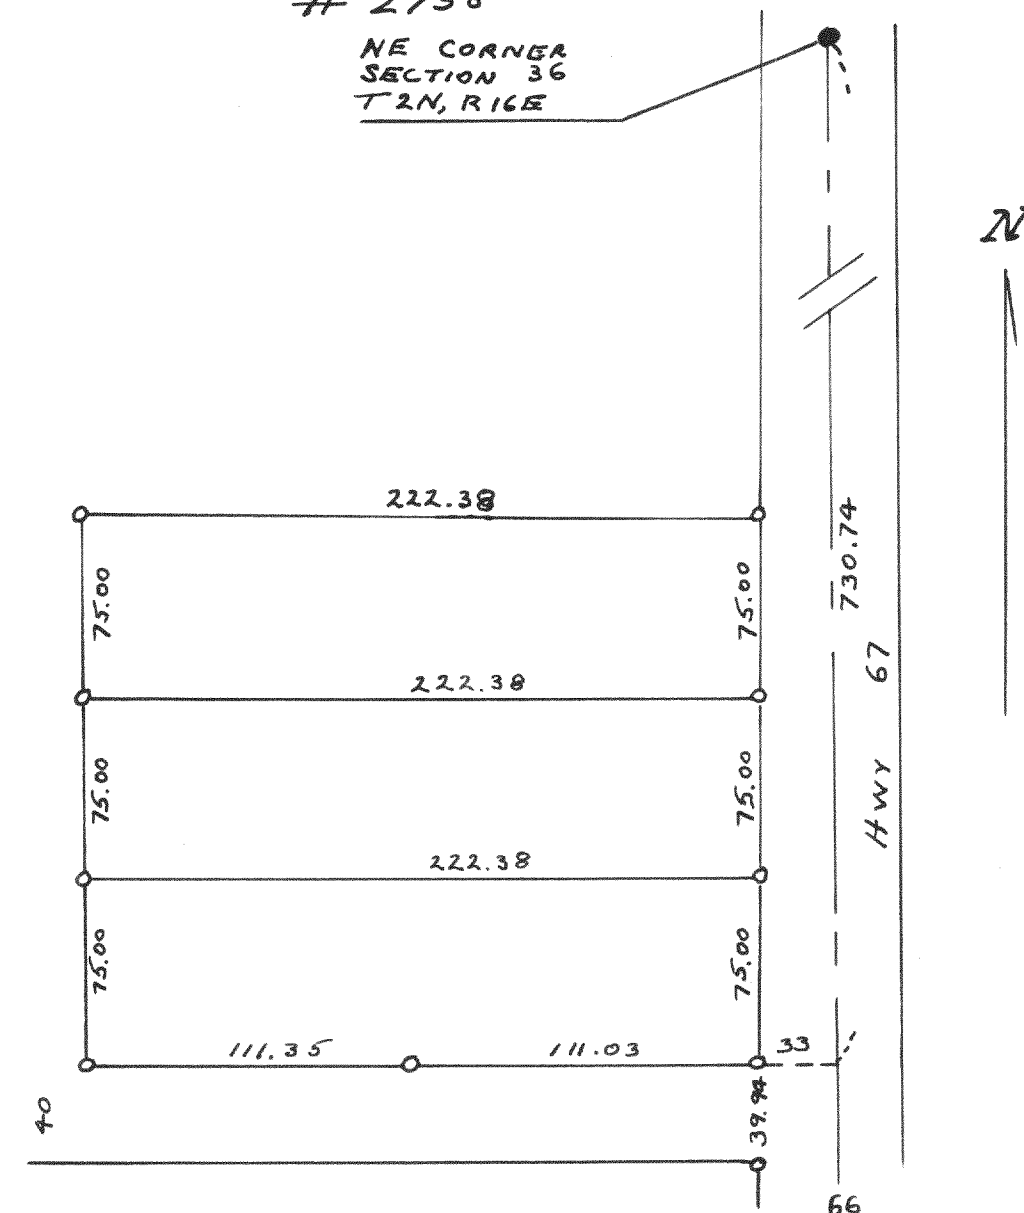


Plat of survey of land located in
NE 1/4 of Sec. 36, T2N, R16E
Dec., 1953 LLV
CS

2757

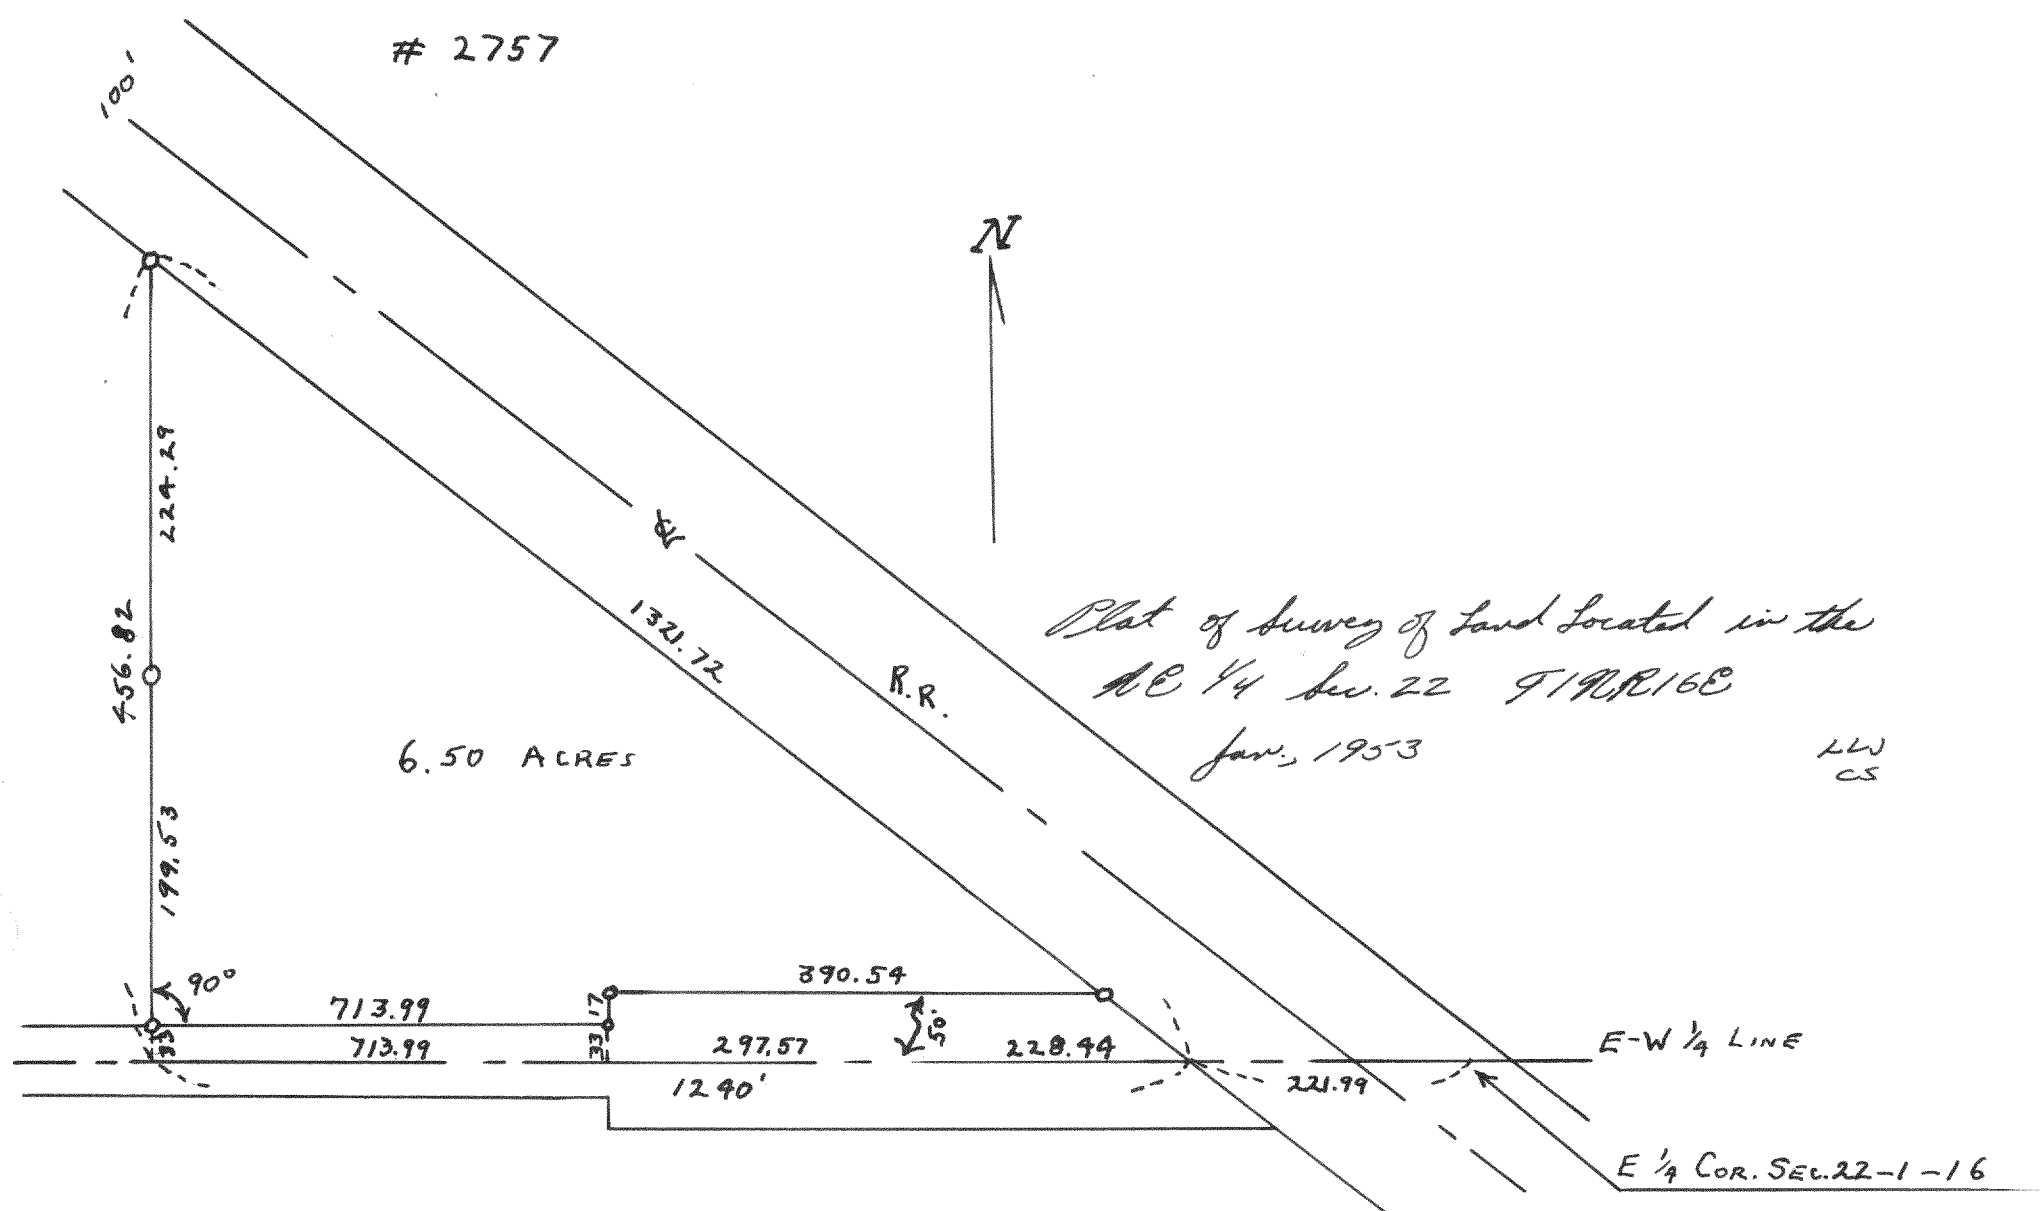

Plat of survey of land located in the
NE 1/4 Sec. 22 T19R16E
Jan., 1953 LLV
CS

2758

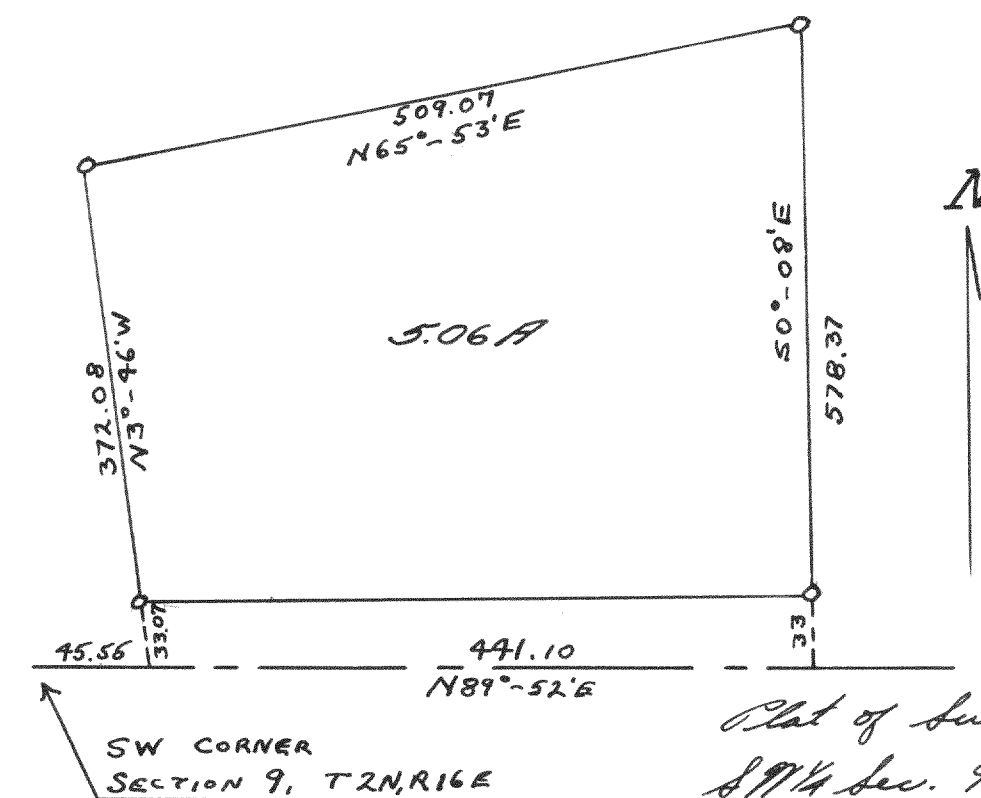

Plat of survey of Part of
SW 1/4 Sec. 9 T2N, R16E
May, 1953 LLV
CS