


4093


PLAT OF SURVEY OF
LOT 2 SUNSET HILLS SHORES
T1N, R17E
WALWORTH COUNTY, WISCONSIN

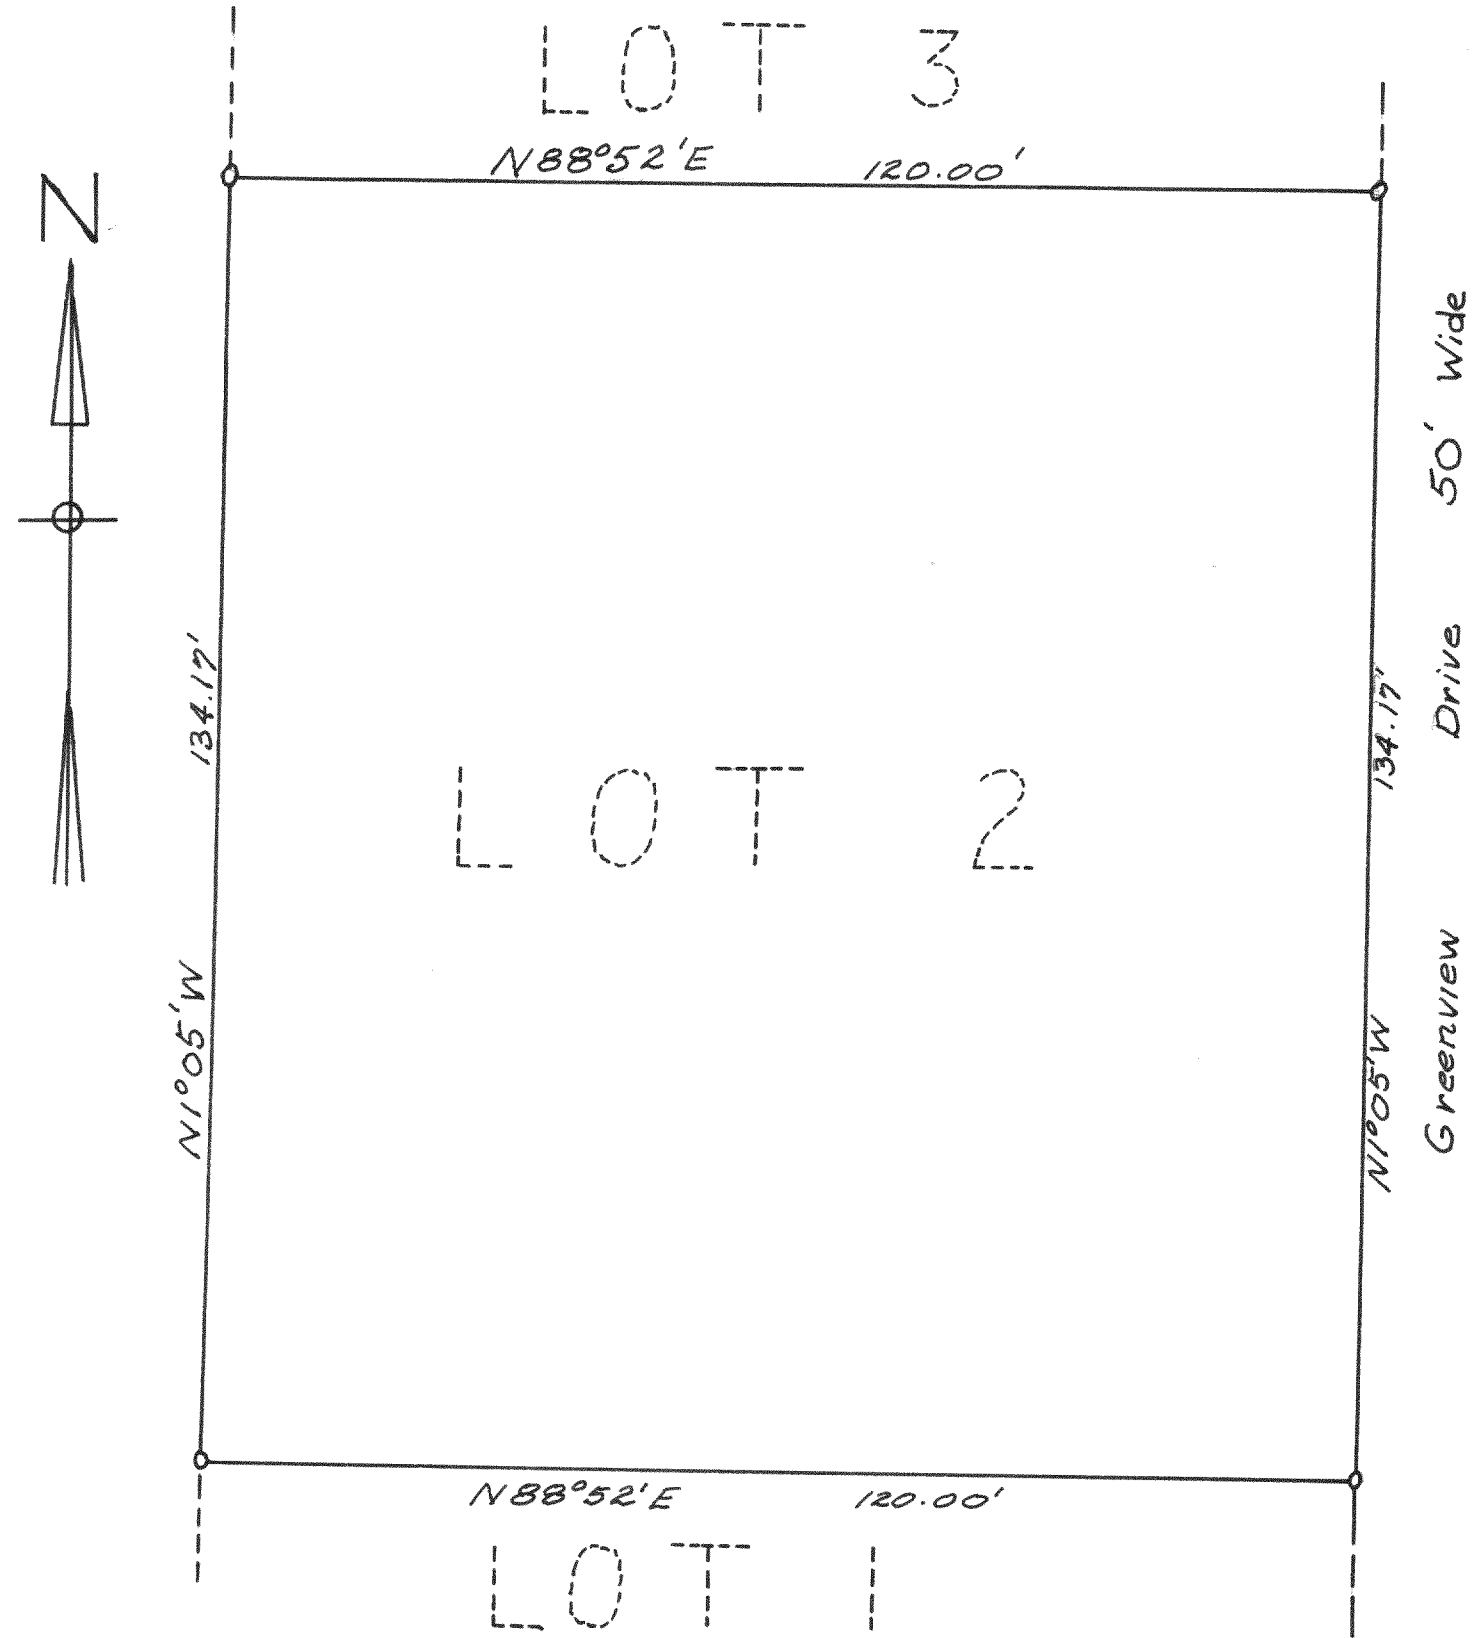

July 1962
Lloyd L Jensen
Wal. Co. Surveyor

4094

PLAT OF SURVEY OF
Lot 10, Edgewater Terrace
Located in Section, T1N, R17E
WALWORTH COUNTY, WISCONSIN

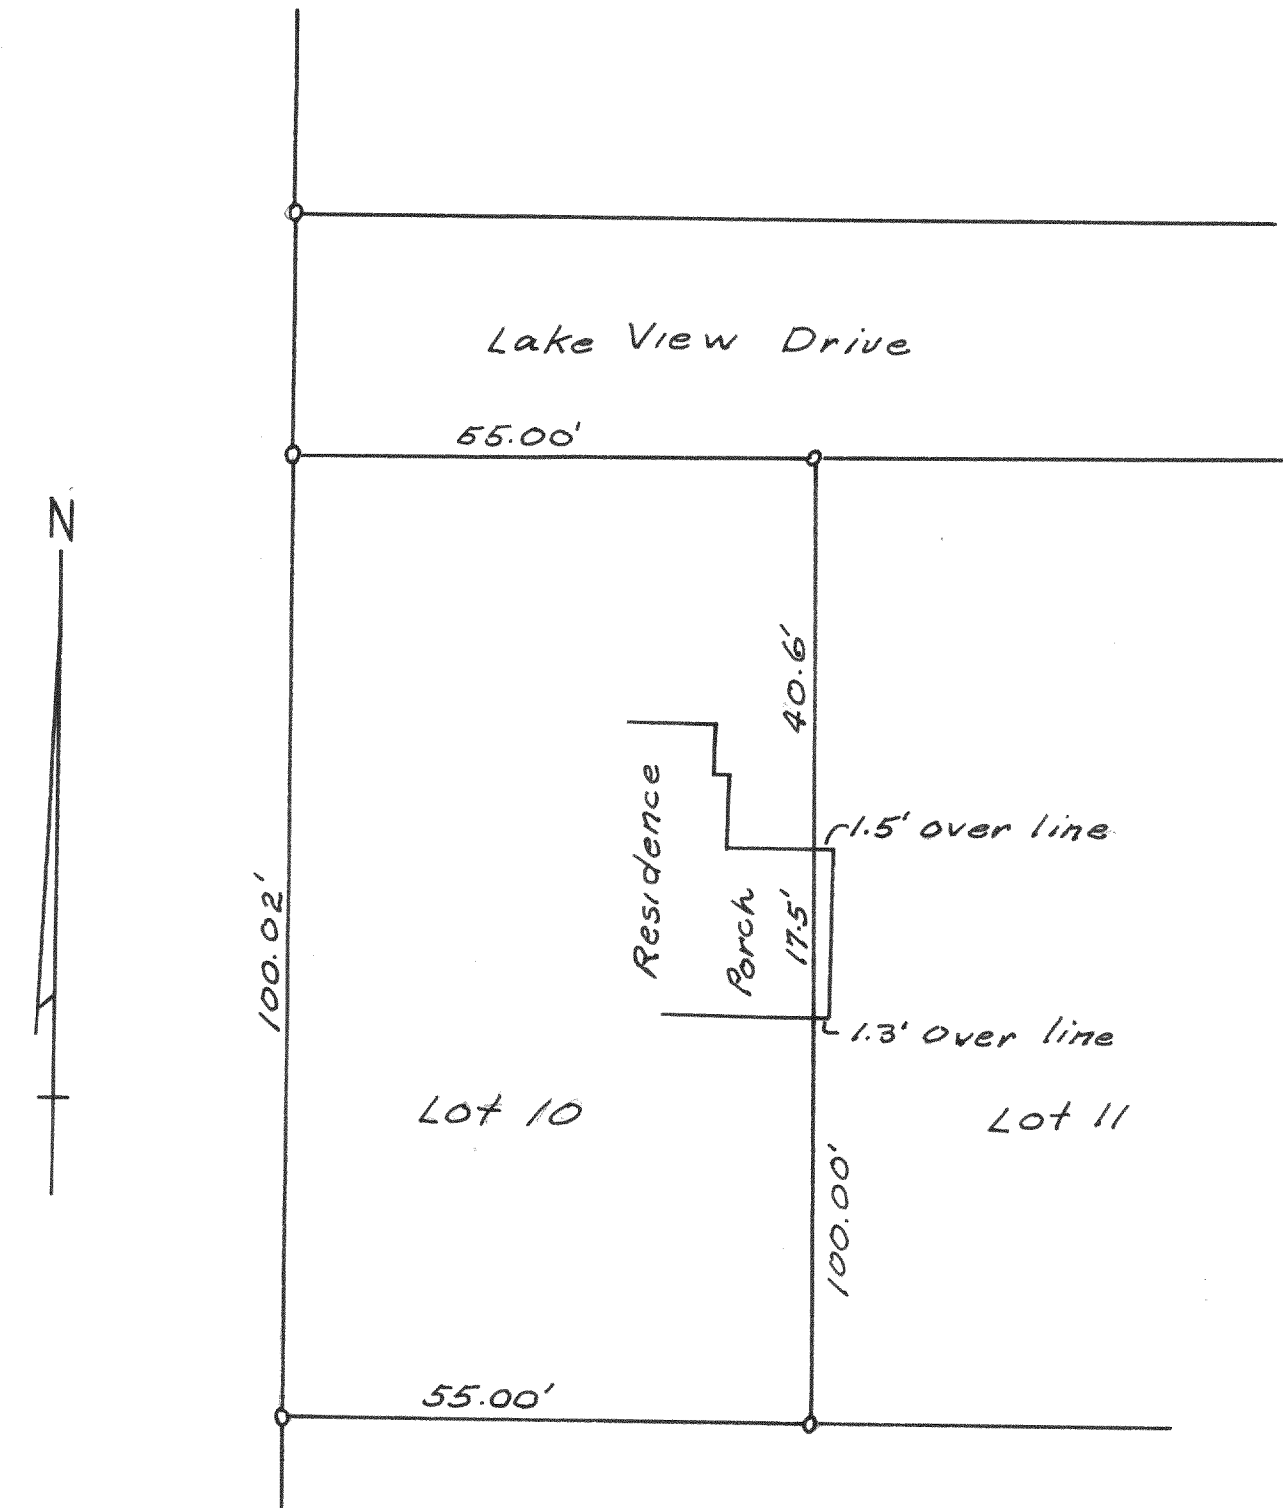

May 1959
Lloyd L Jensen
Wal. County Surveyor