


4097

PLAT OF SURVEY OF
N $\frac{1}{2}$ LOT 234 and LOT 235, Third Addition to
CEDAR POINT PARK, Village of Williams Bay,
WAH WORTH COUNTY, Wisconsin.

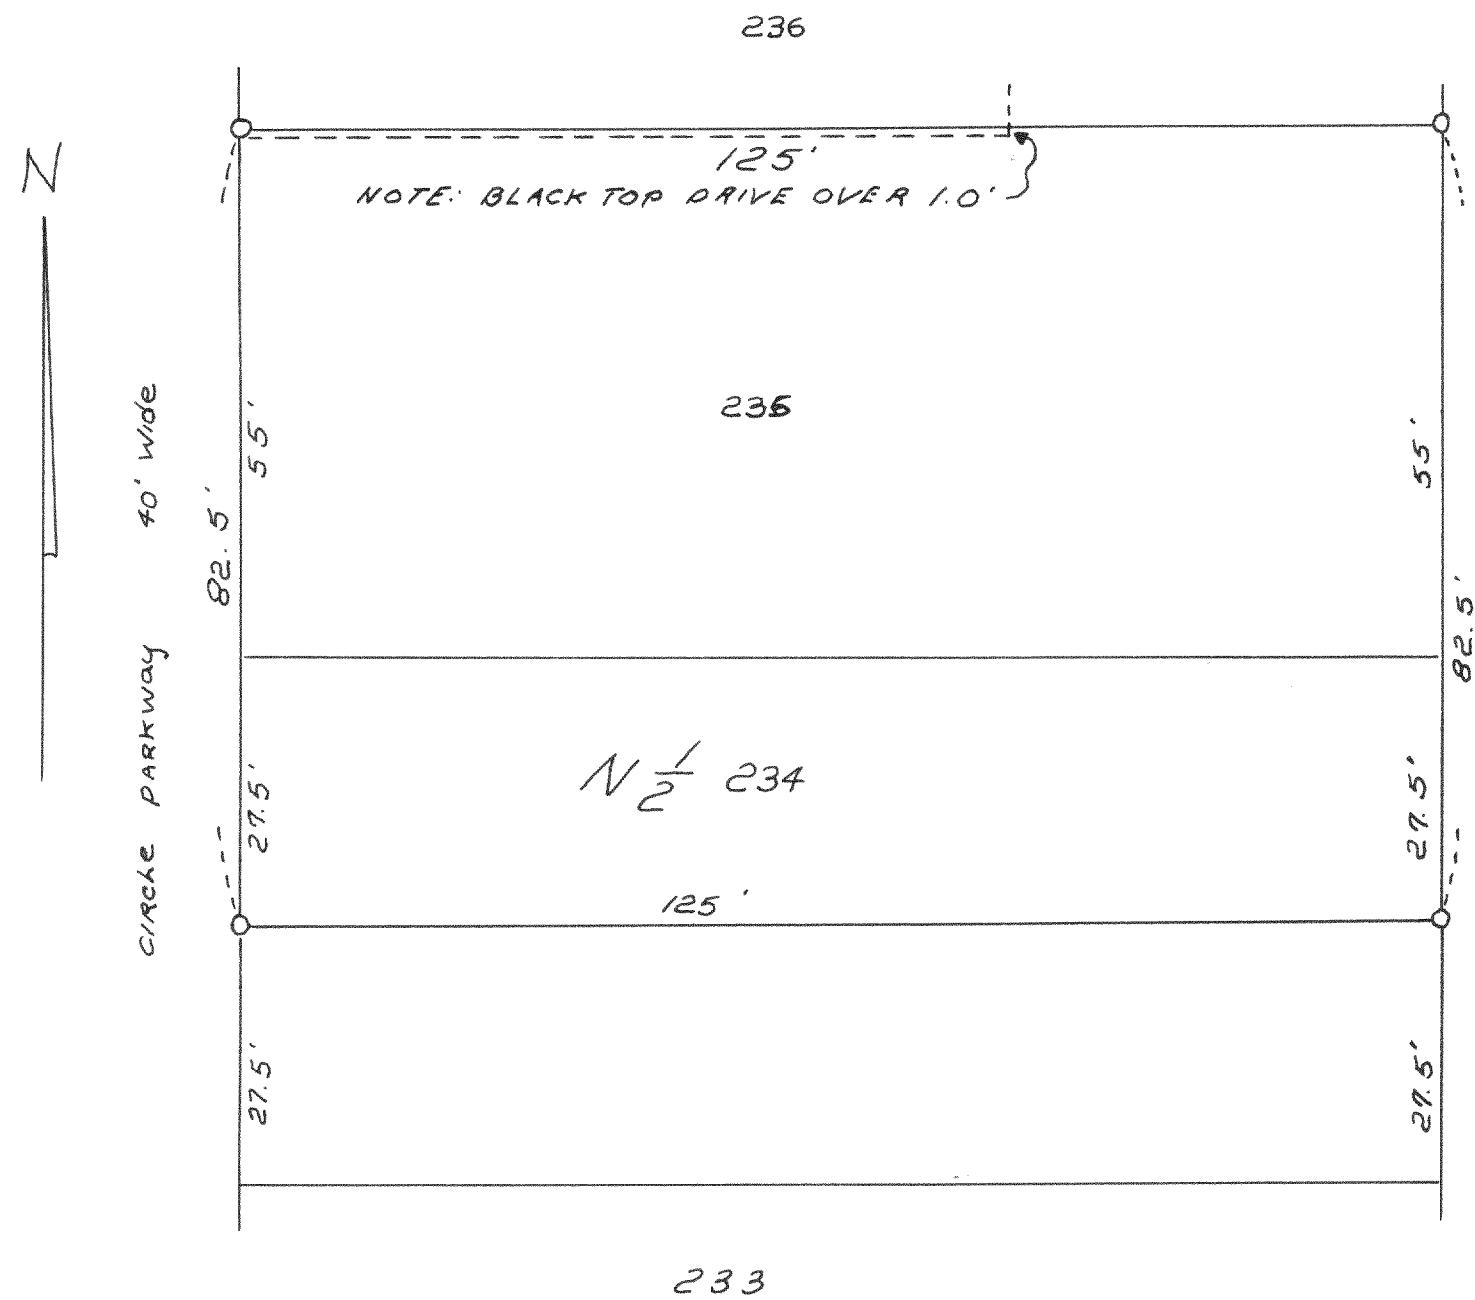


may 1962

Lloyd L. Jensen
Wah. Co. Surveyor

4098

PLAT OF SURVEY OF
LOT 12 - BLOCK 1, MIRAMAR
SUBDIVISION located in SECTION
10 & 11 T4N, R18E. WAH WORTH
COUNTY, Wisconsin

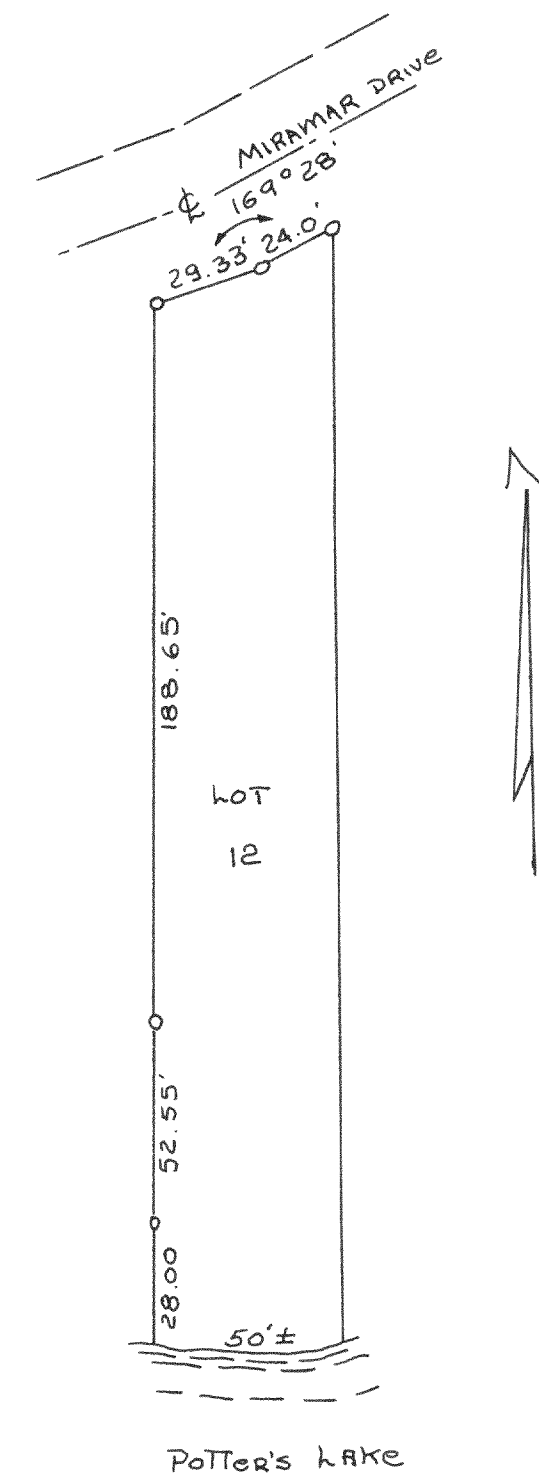

Nov. 1962

Lloyd L. Jensen
Wah. Co. Surveyor