


354

NW Cor. of NW 1/4
SEC. 13-3-21

4099

PLAT of SURVEY of
PART of the NW 1/4 of SECTION 13,
T3N, R21E, IN THE TOWN of YORKVILLE,
RACINE COUNTY, WISCONSIN

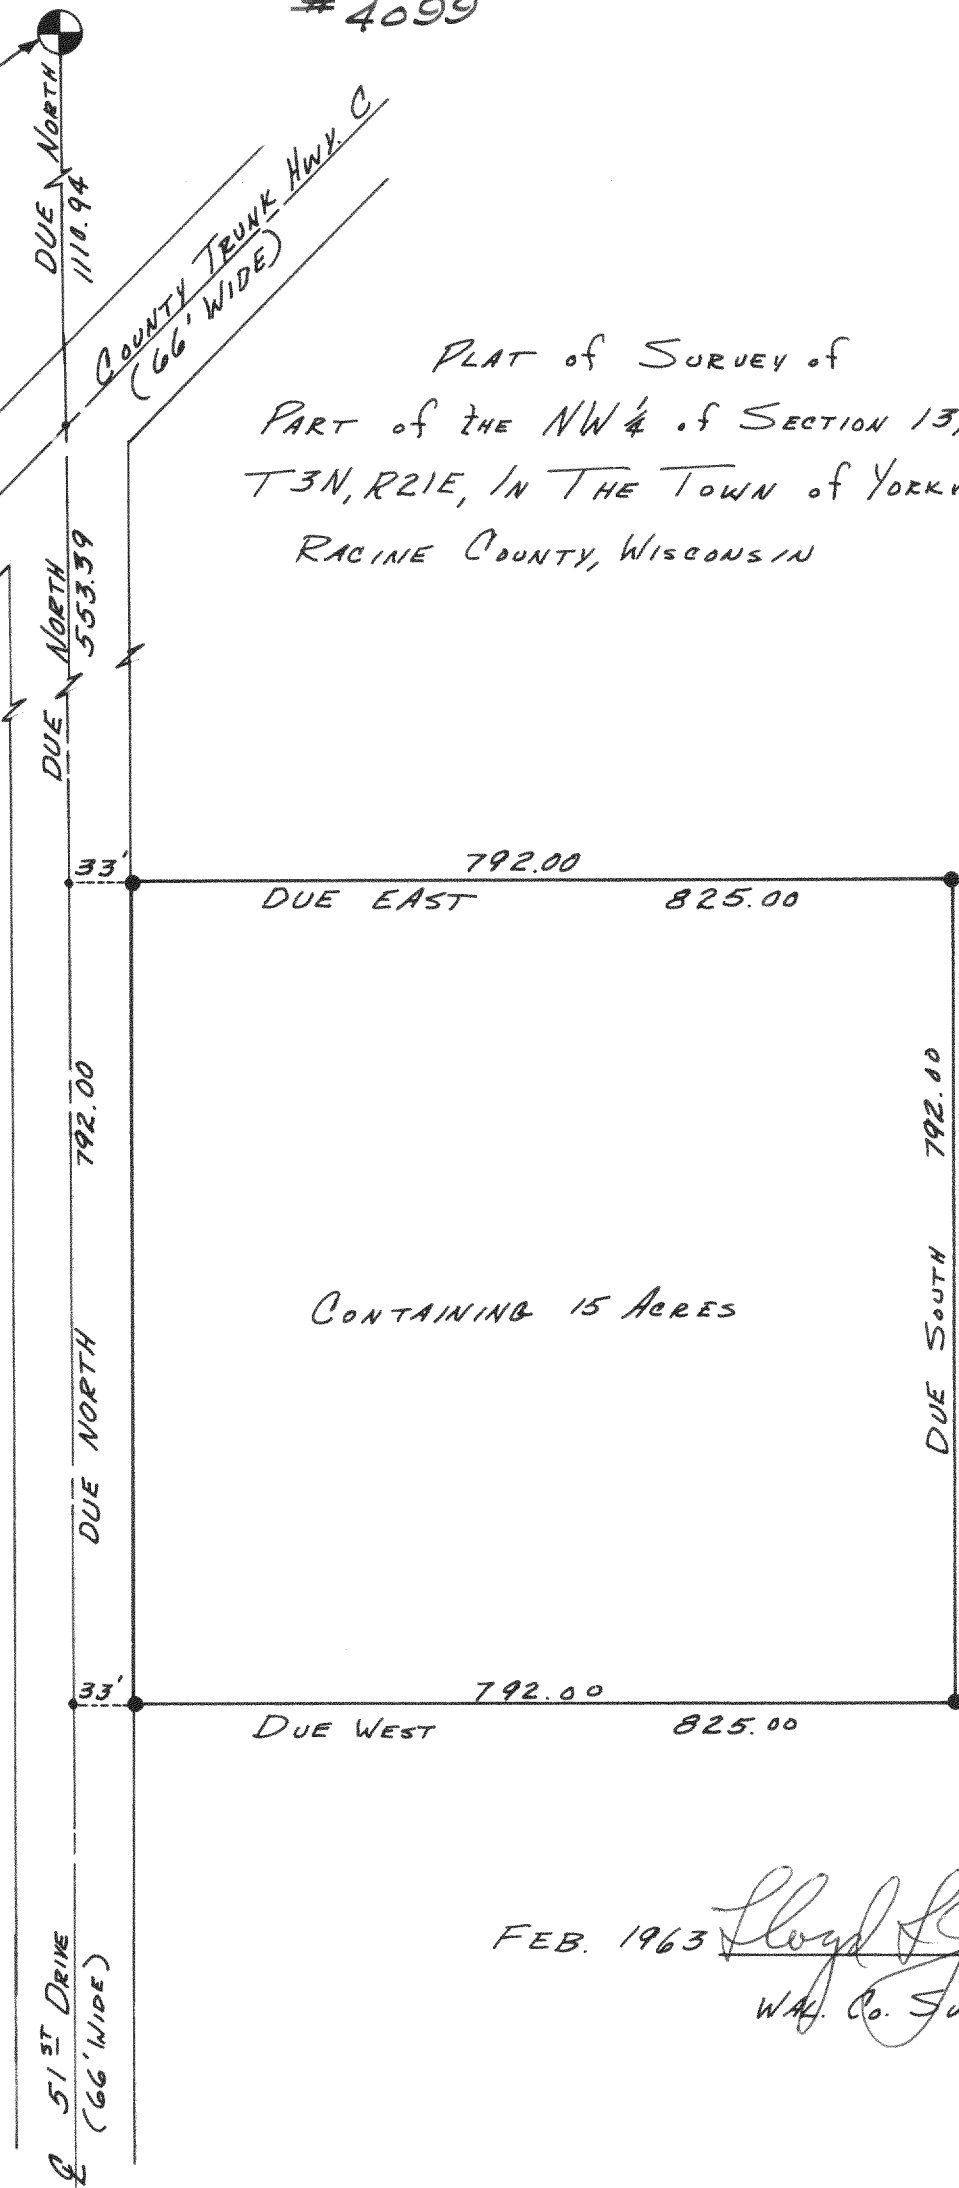


CONTAINING 15 ACRES

FEB. 1963 *Lloyd Jensen*
WA. Co. SURVEYOR

4100

PLAT of SURVEY of
PART of Lots 2 & 3 of Block 25,
ORIGINAL PLAT, CITY of ELKHORN,
WALWORTH COUNTY, WISCONSIN

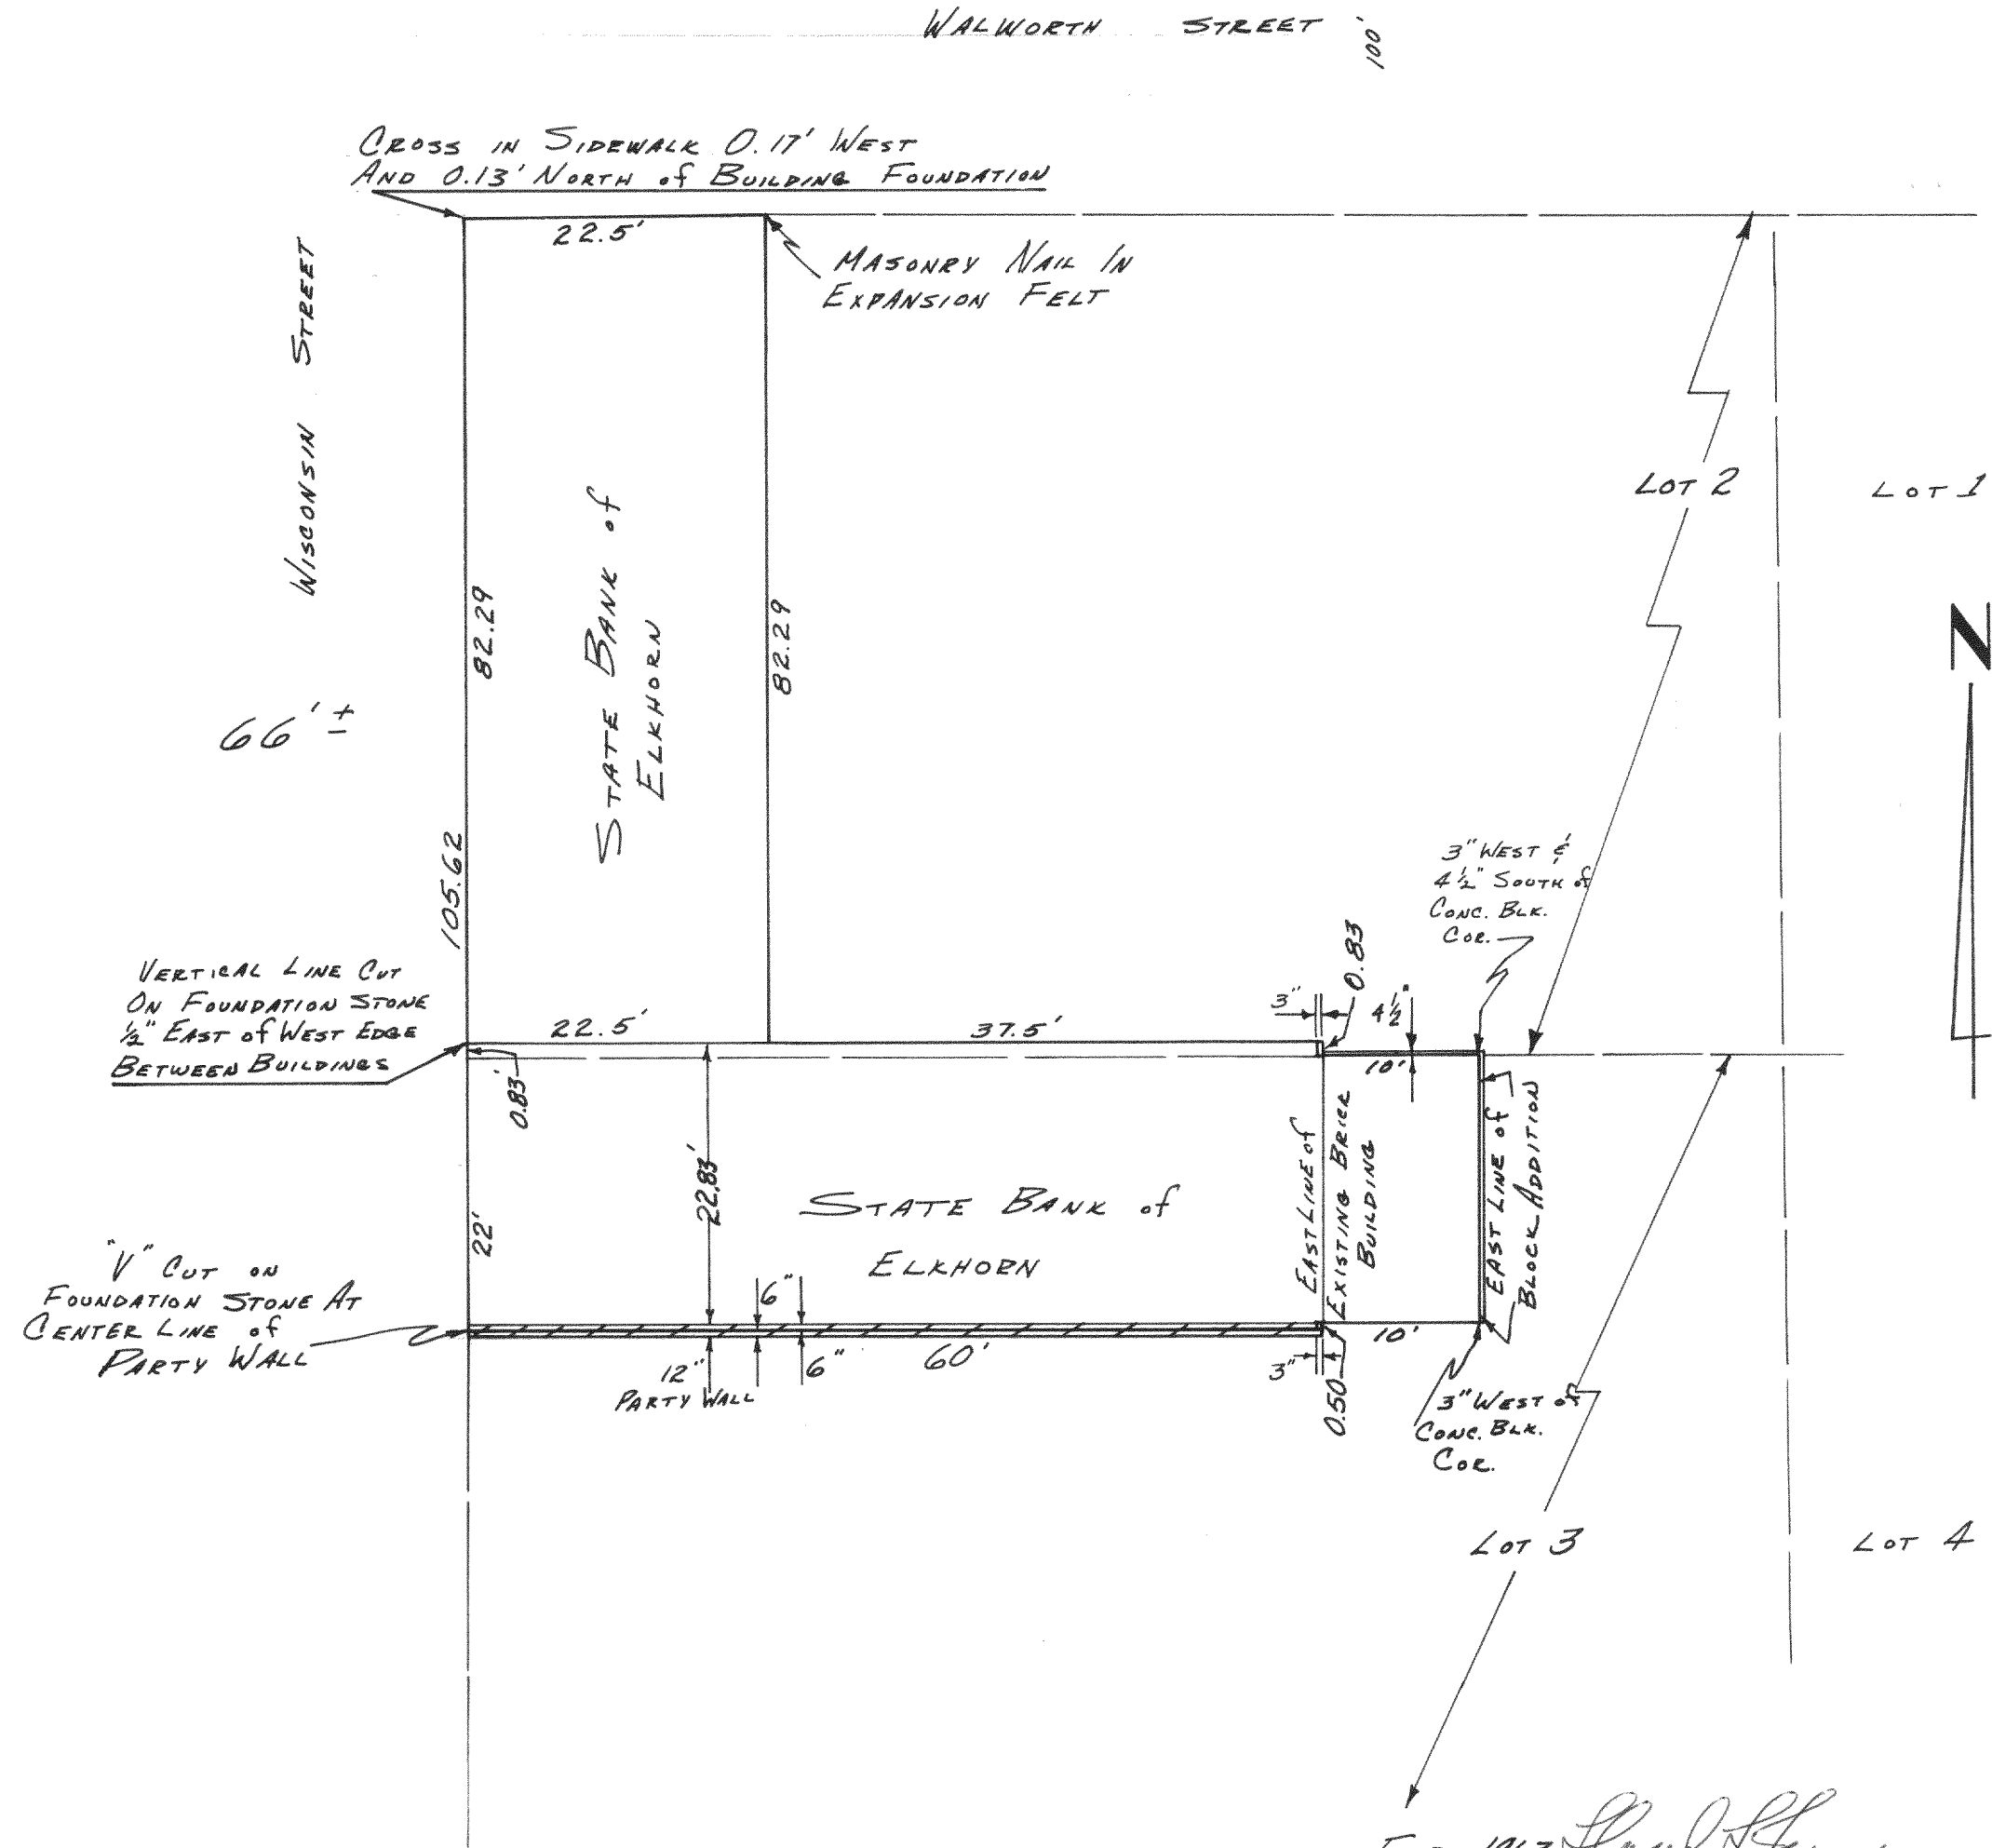

FEB 1963 *Lloyd Jensen*
WALWORTH COUNTY
SURVEYOR