


4101

PLAT OF SURVEY OF LYONS SCHOON AS FENCED

A parcel of land located in The Northwest 1/4 of Sec. 10, T2N, R18E, Walworth County, Wisconsin and described as follows; To wit: Commencing at The North 1/4 corner of said Sec. 10; Thence West 595.38 feet along The centerline of State Trunk Highway 36; Thence S 5°-48'W 33.85 feet to The corner post of a cyclone fence and The place of beginning; Thence continue S 5°-48'W 204.0 feet along said cyclone fence to a corner post; Thence N 79°-21'W 157.64 feet along The remains of a barbed-wire fence to The corner post; Thence N 75°-25'W 127.9 feet to The corner post of a cyclone fence; Thence N 11°-35'E 142.8 feet along said cyclone fence to a corner post; Thence N 89°-39'E 270.7 feet along said cyclone fence to The place of beginning, intending to describe The land now enclosed by The fence for LYONS SCHOON

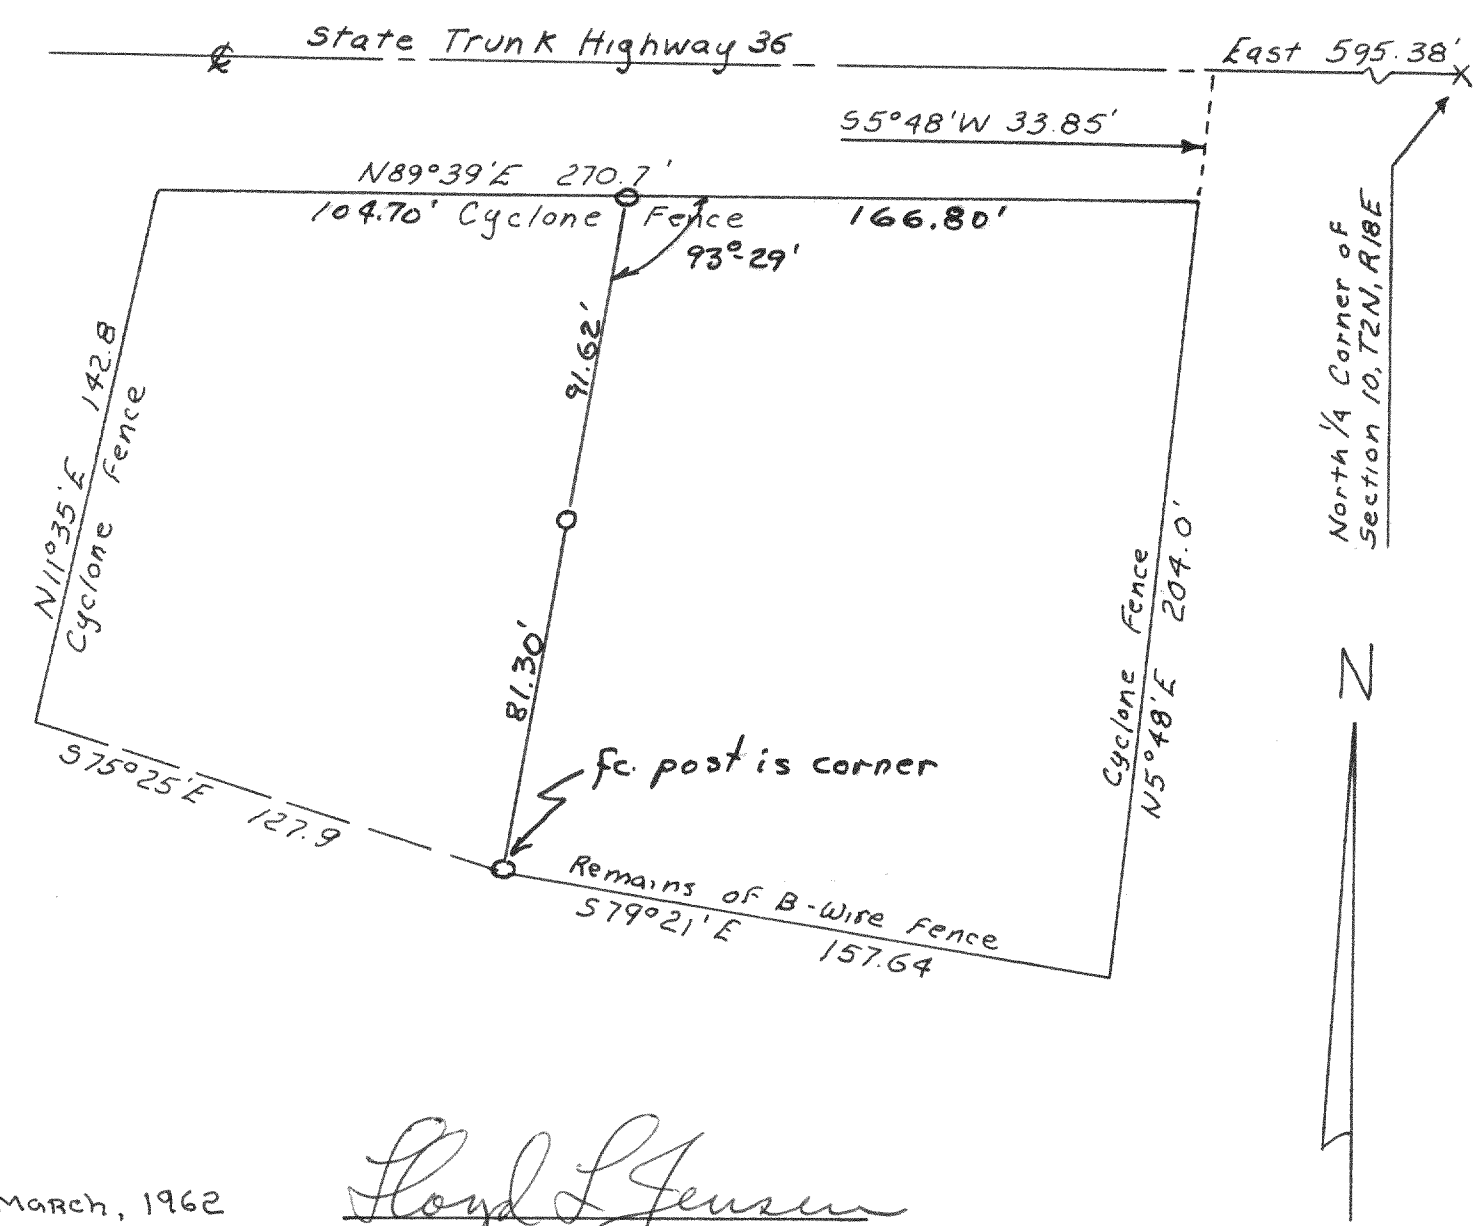

March, 1962

Lloyd L Jensen
Wal. Co. Surveyor


4102

PLAT OF SURVEY OF

LOT 10 - Block 1, Miramar Subdivision

located in Section 10 & 11 T.4N., R.18E.

Walworth County, Wisconsin

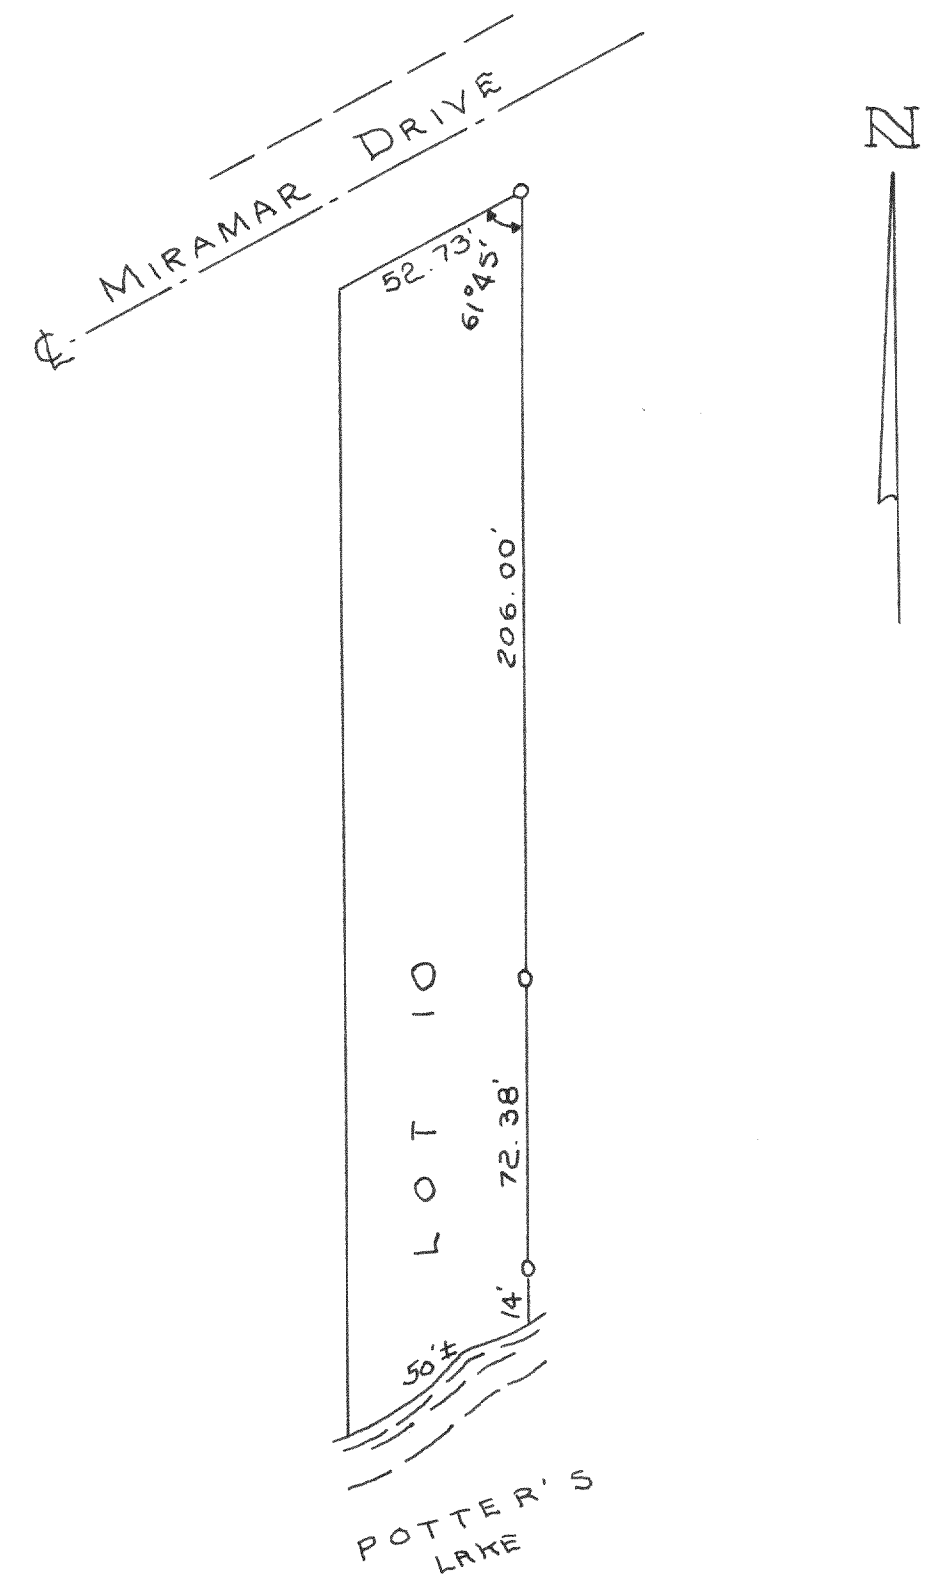

Nov. 1962

Lloyd L Jensen
Wal. Co. Surveyor