


4112

Plat of Survey of
Lot 2 Rolo's Addition To Village of
Wahworth, Walworth County, Wisconsin.

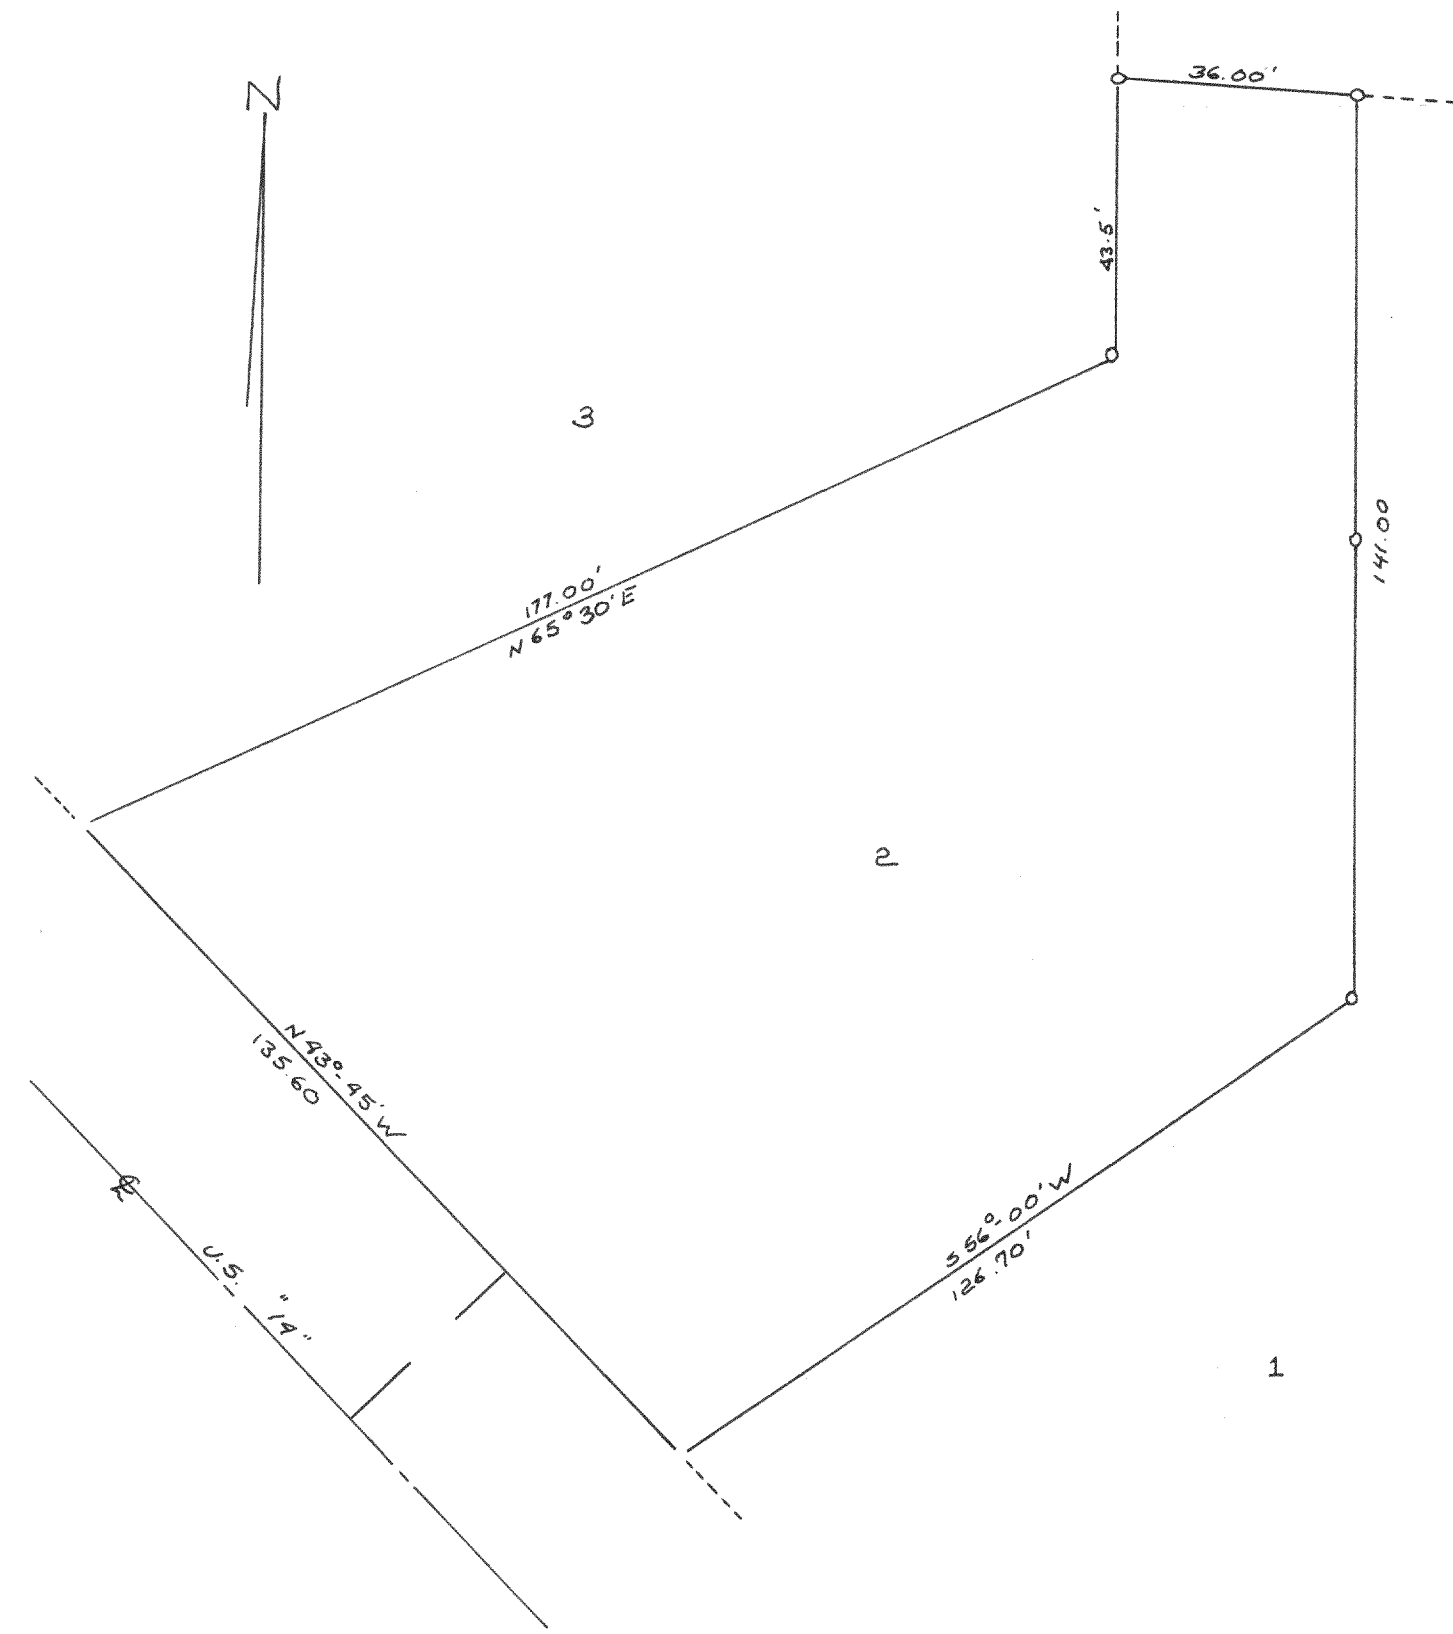


Nov. 1962

Lloyd L Jensen
Wal. Co. Surveyor

4113

Plat of Survey of
Lots 7884-7889 and The N $\frac{1}{2}$ of Lot 7890
Block 134, Lake Como Beach, T2N R17E, Walworth
County, Wisconsin

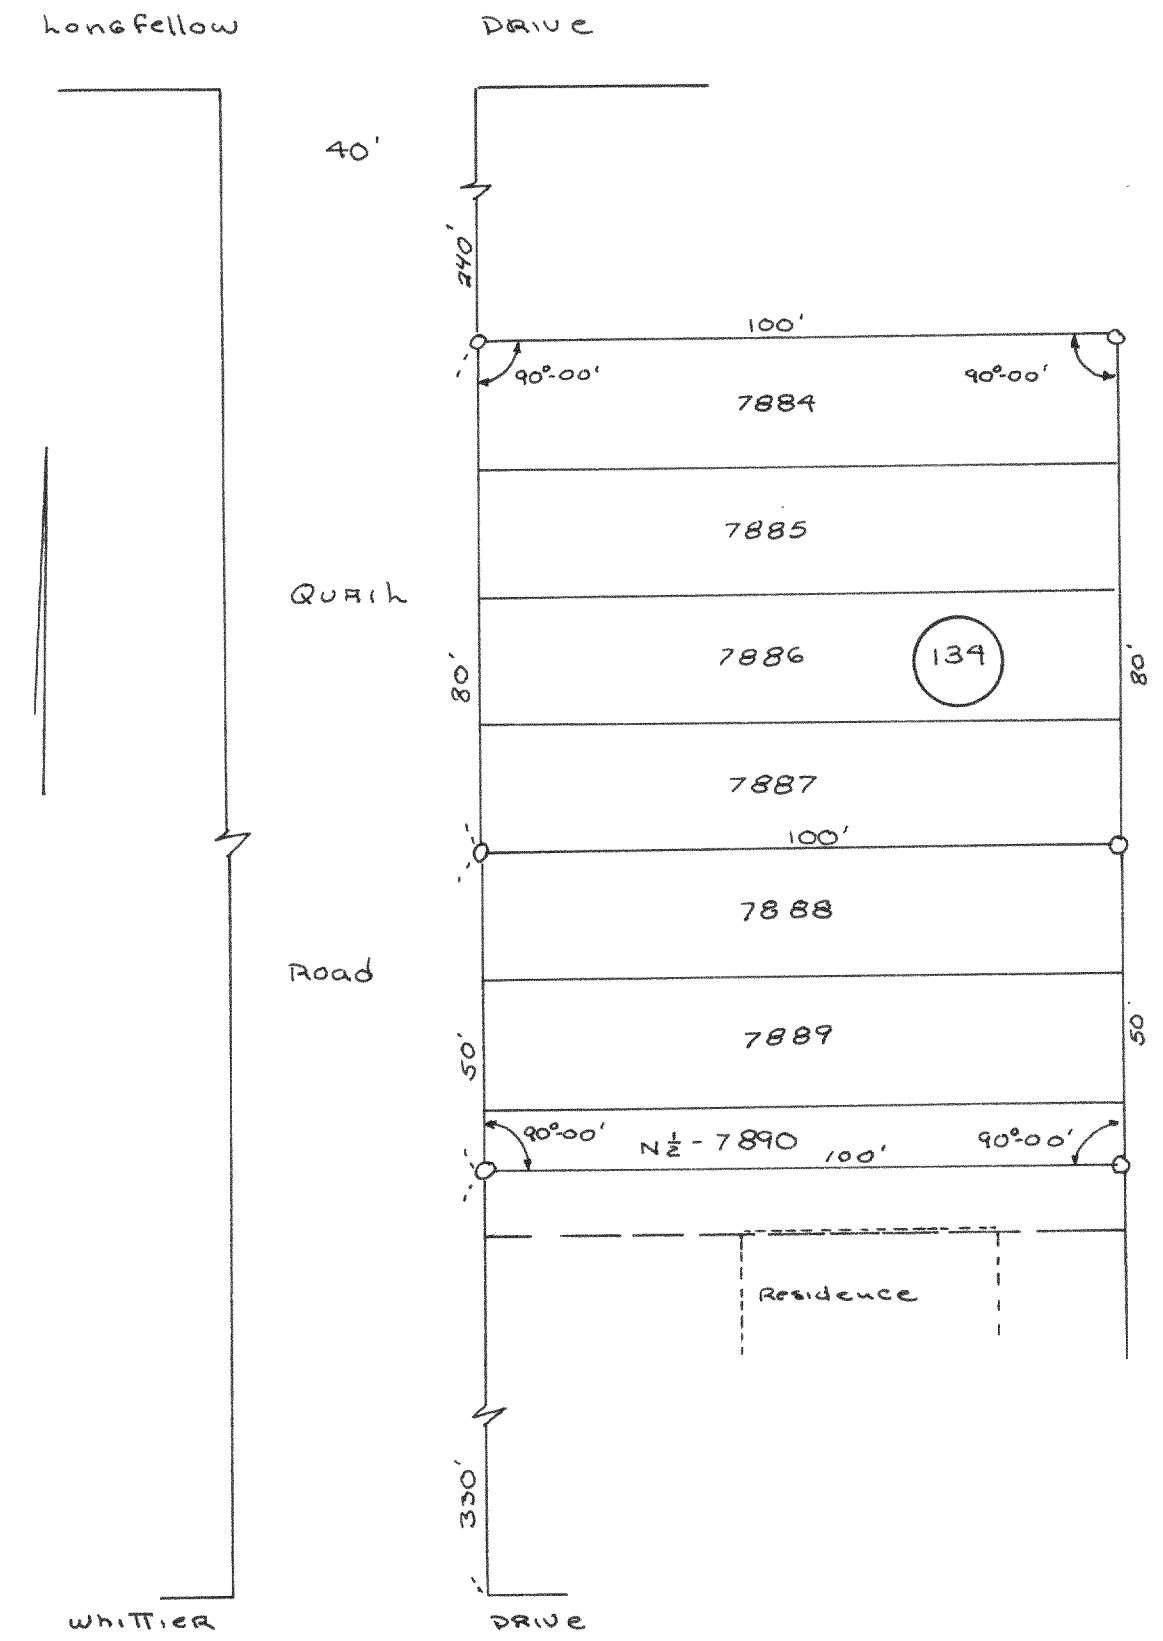

April 1962

Lloyd L Jensen
Wal. Co. Surveyor