



PLAT of SURVEY of # 4114
LOT 3 of THE BIRCHES, A
SUBDIVISION LOCATED IN SEC. 10,
T1N, R1E of WALWORTH
COUNTY, WISCONSIN

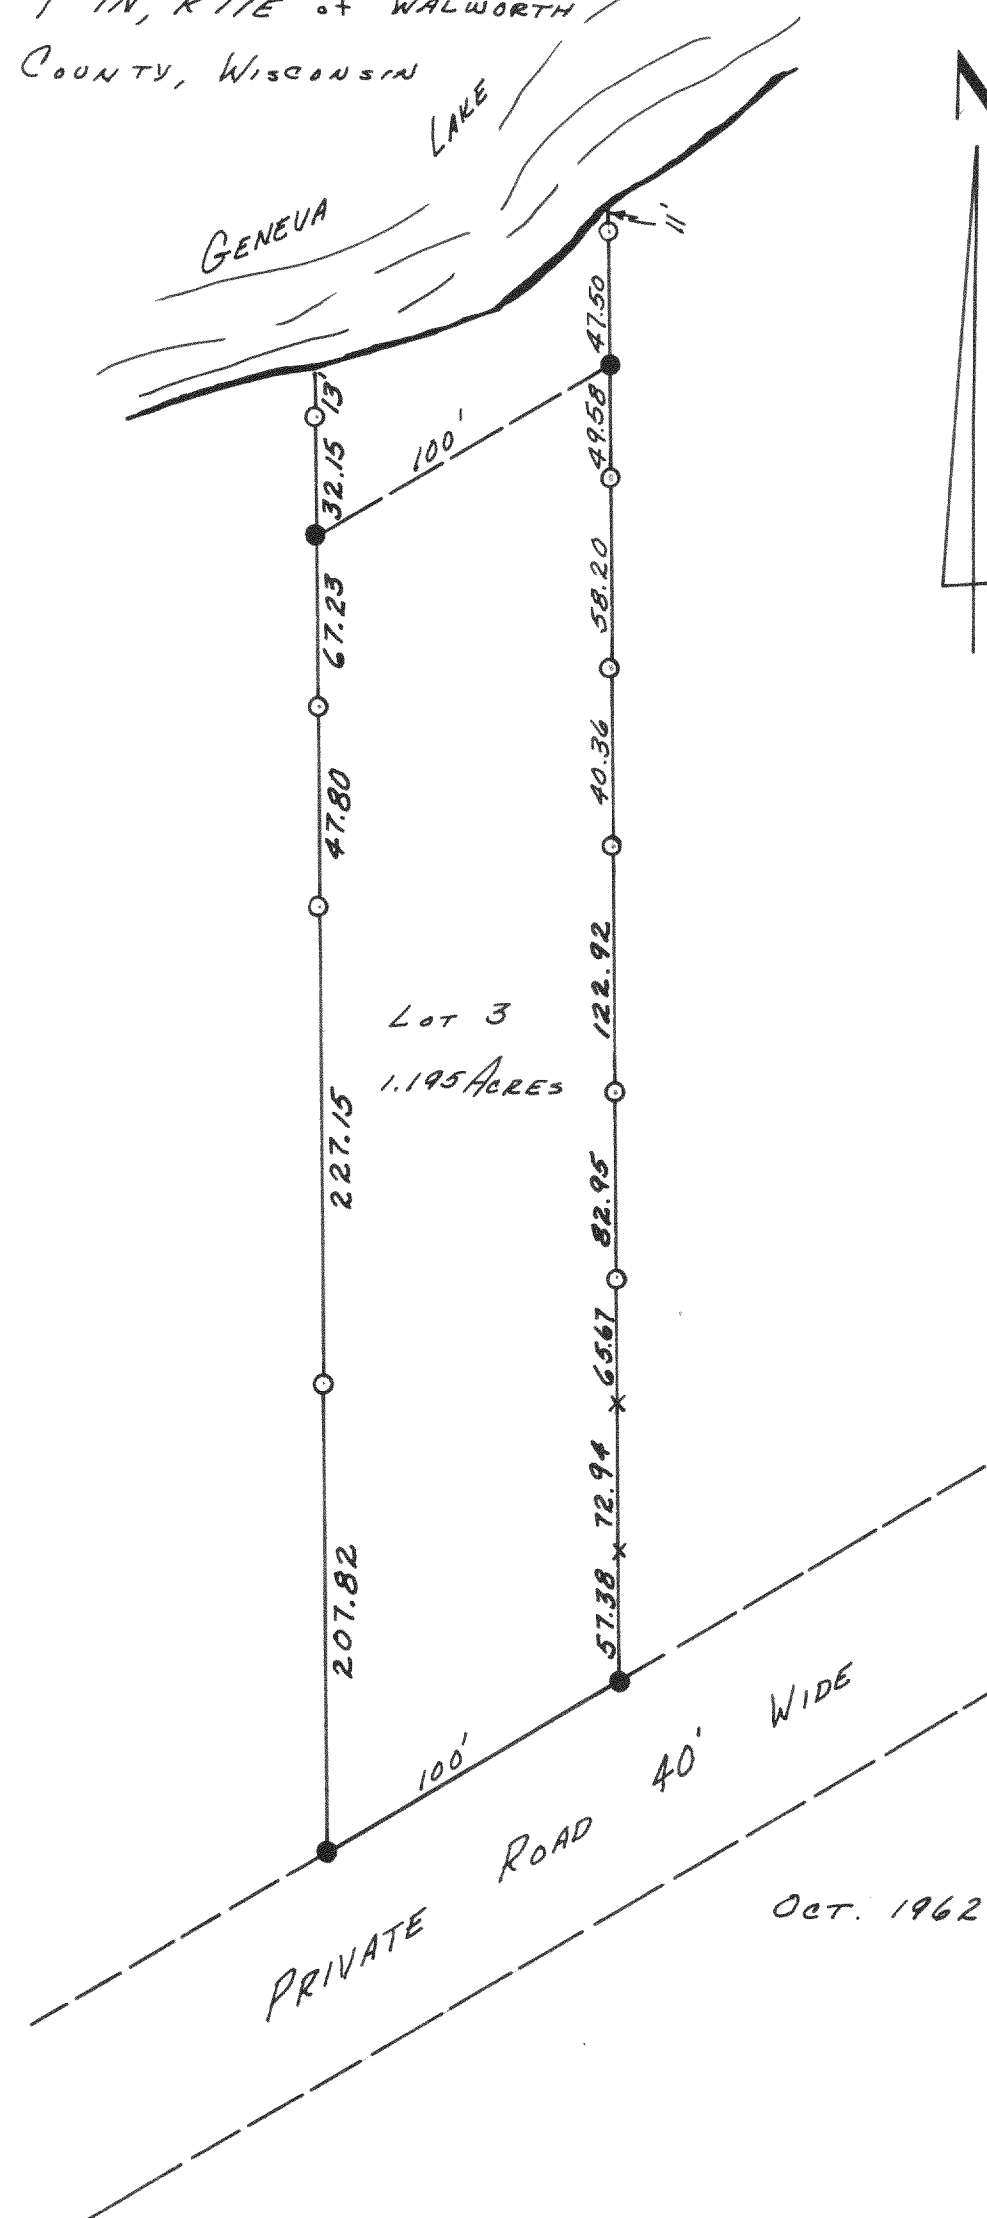

Oct. 1962

Lloyd Jensen
WAL. CO. SURVEYOR

#4115 PLAT of SURVEY of
A PARCEL of LAND LOCATED PARTLY
IN SEC. 4-T4N-R18E & PARTLY IN SEC. 5-T4N-
R18E, WALWORTH COUNTY, WISCONSIN

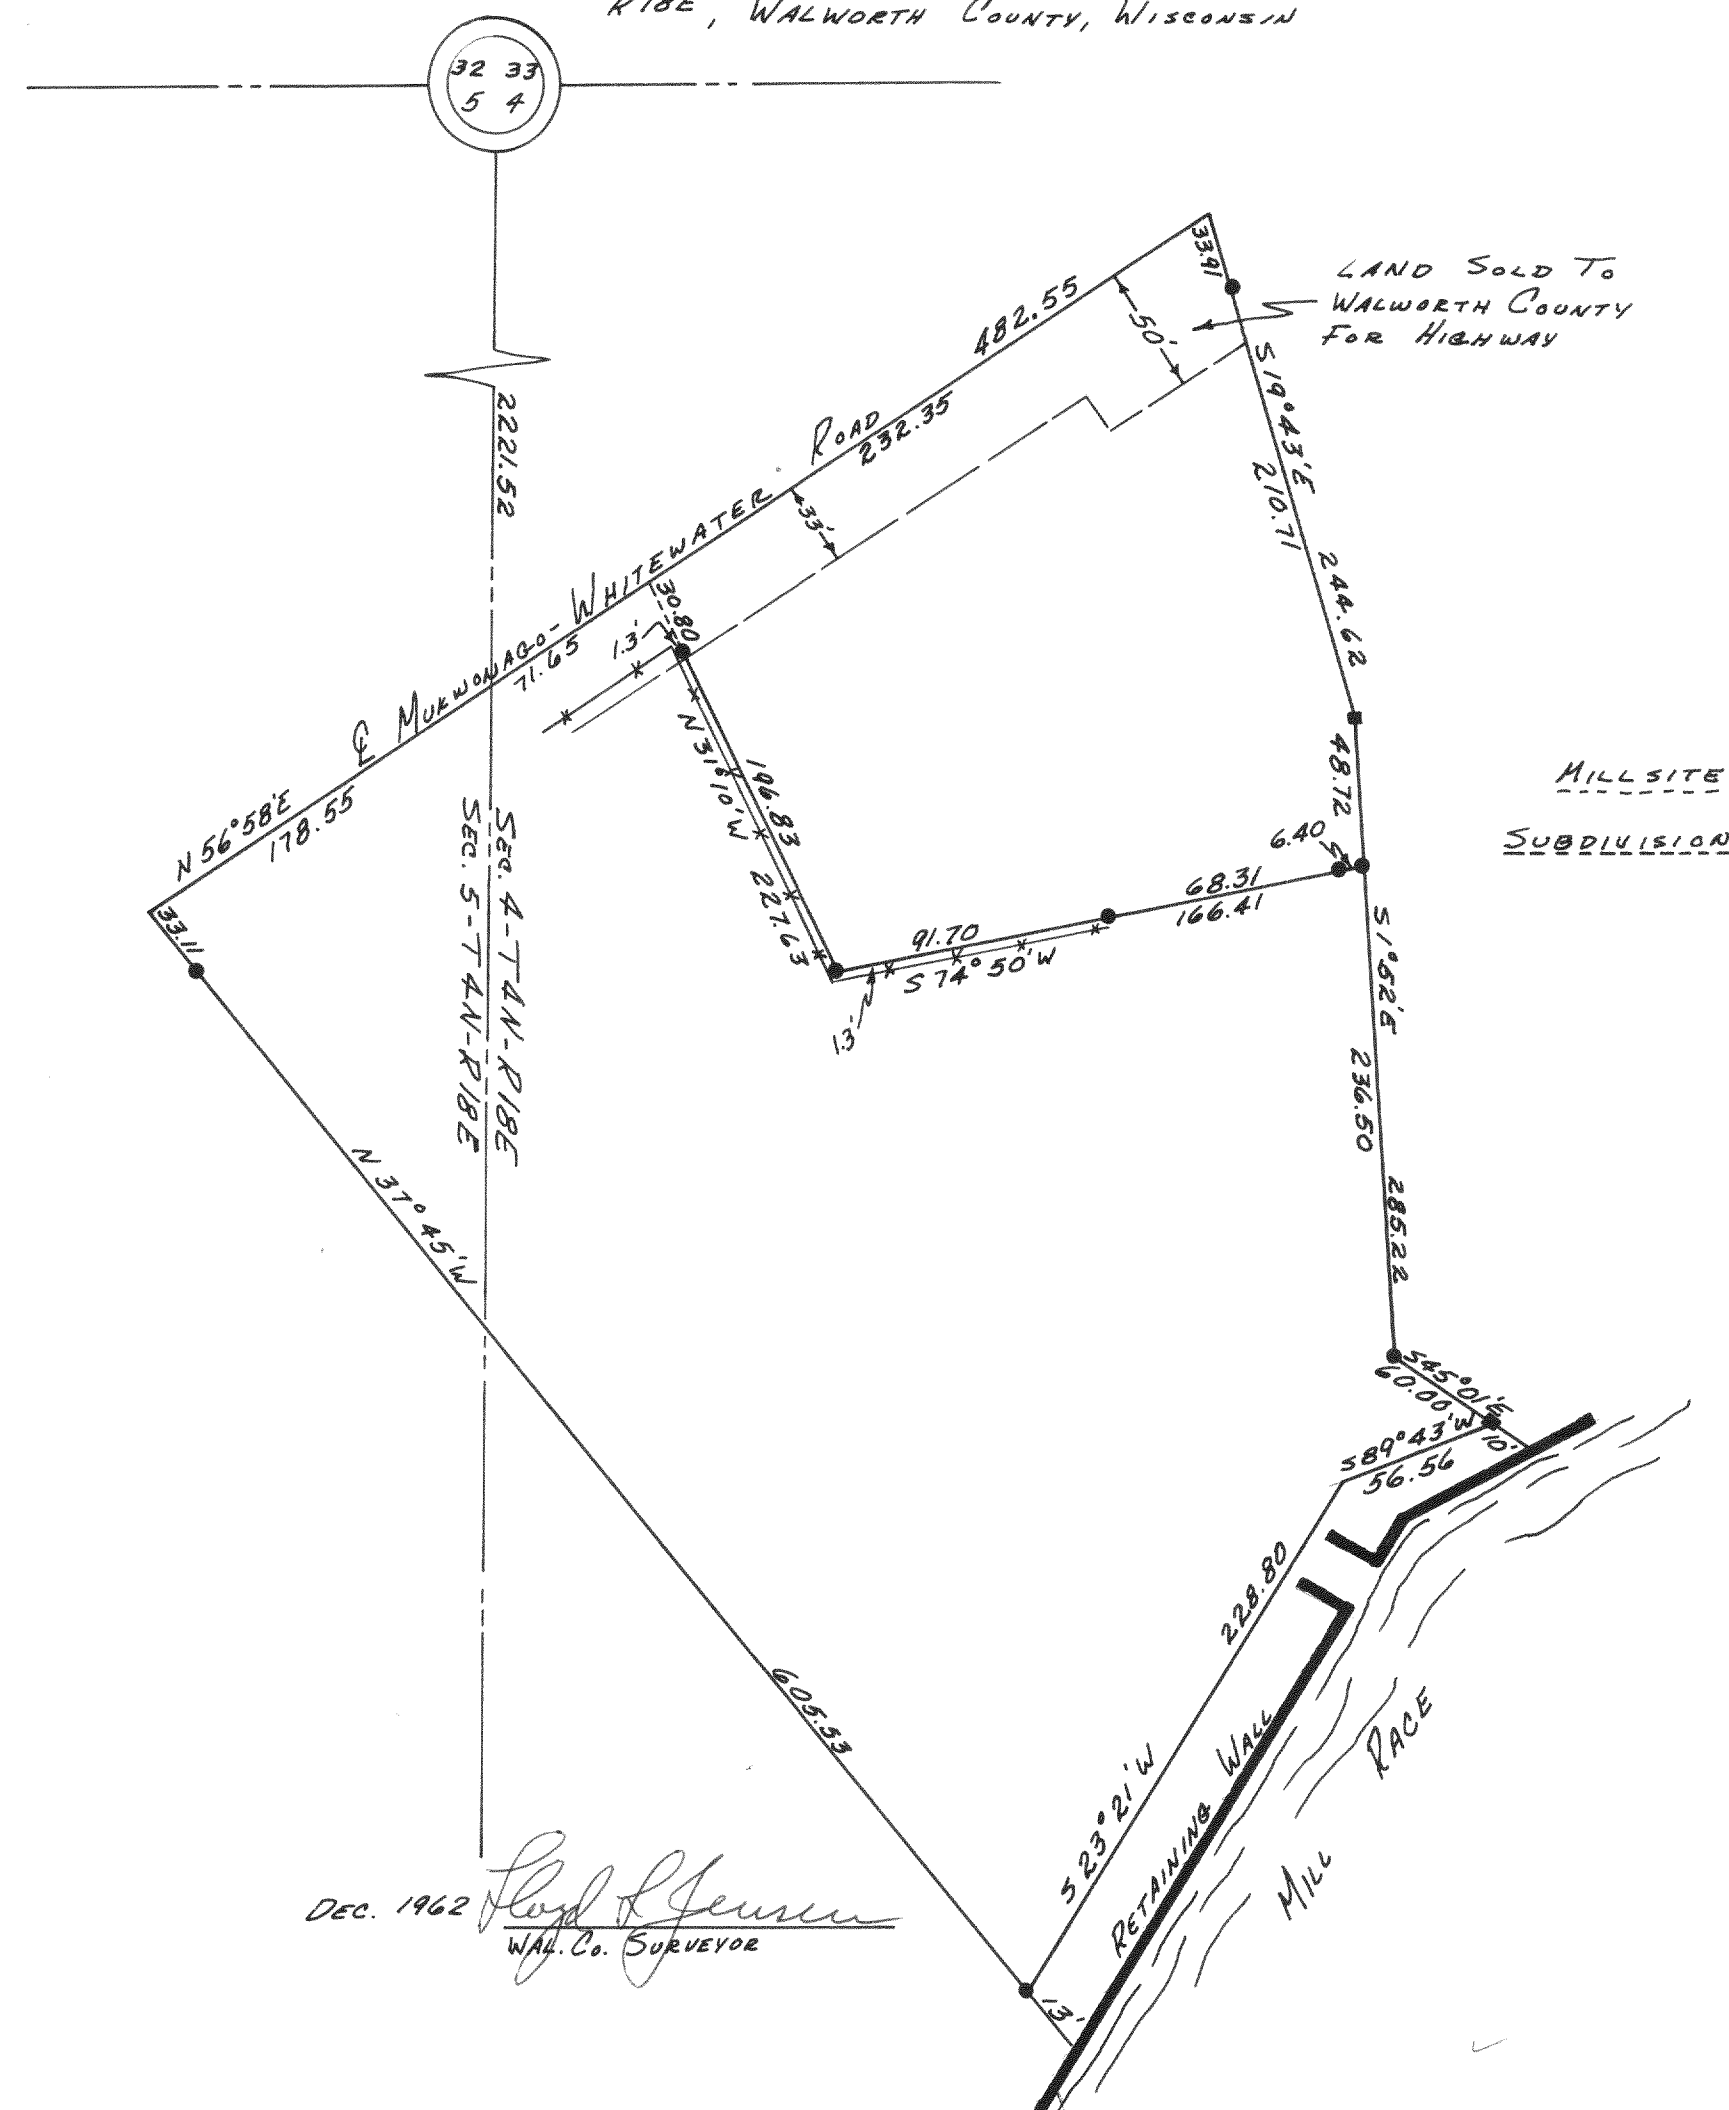

DEC. 1962

Lloyd Jensen
WALL CO. SURVEYOR