


4118

PLAT of SURVEY
of
LANDS LOCATED IN SECTION 3, 4
T1N, R1E, WALWORTH COUNTY,
WISCONSIN

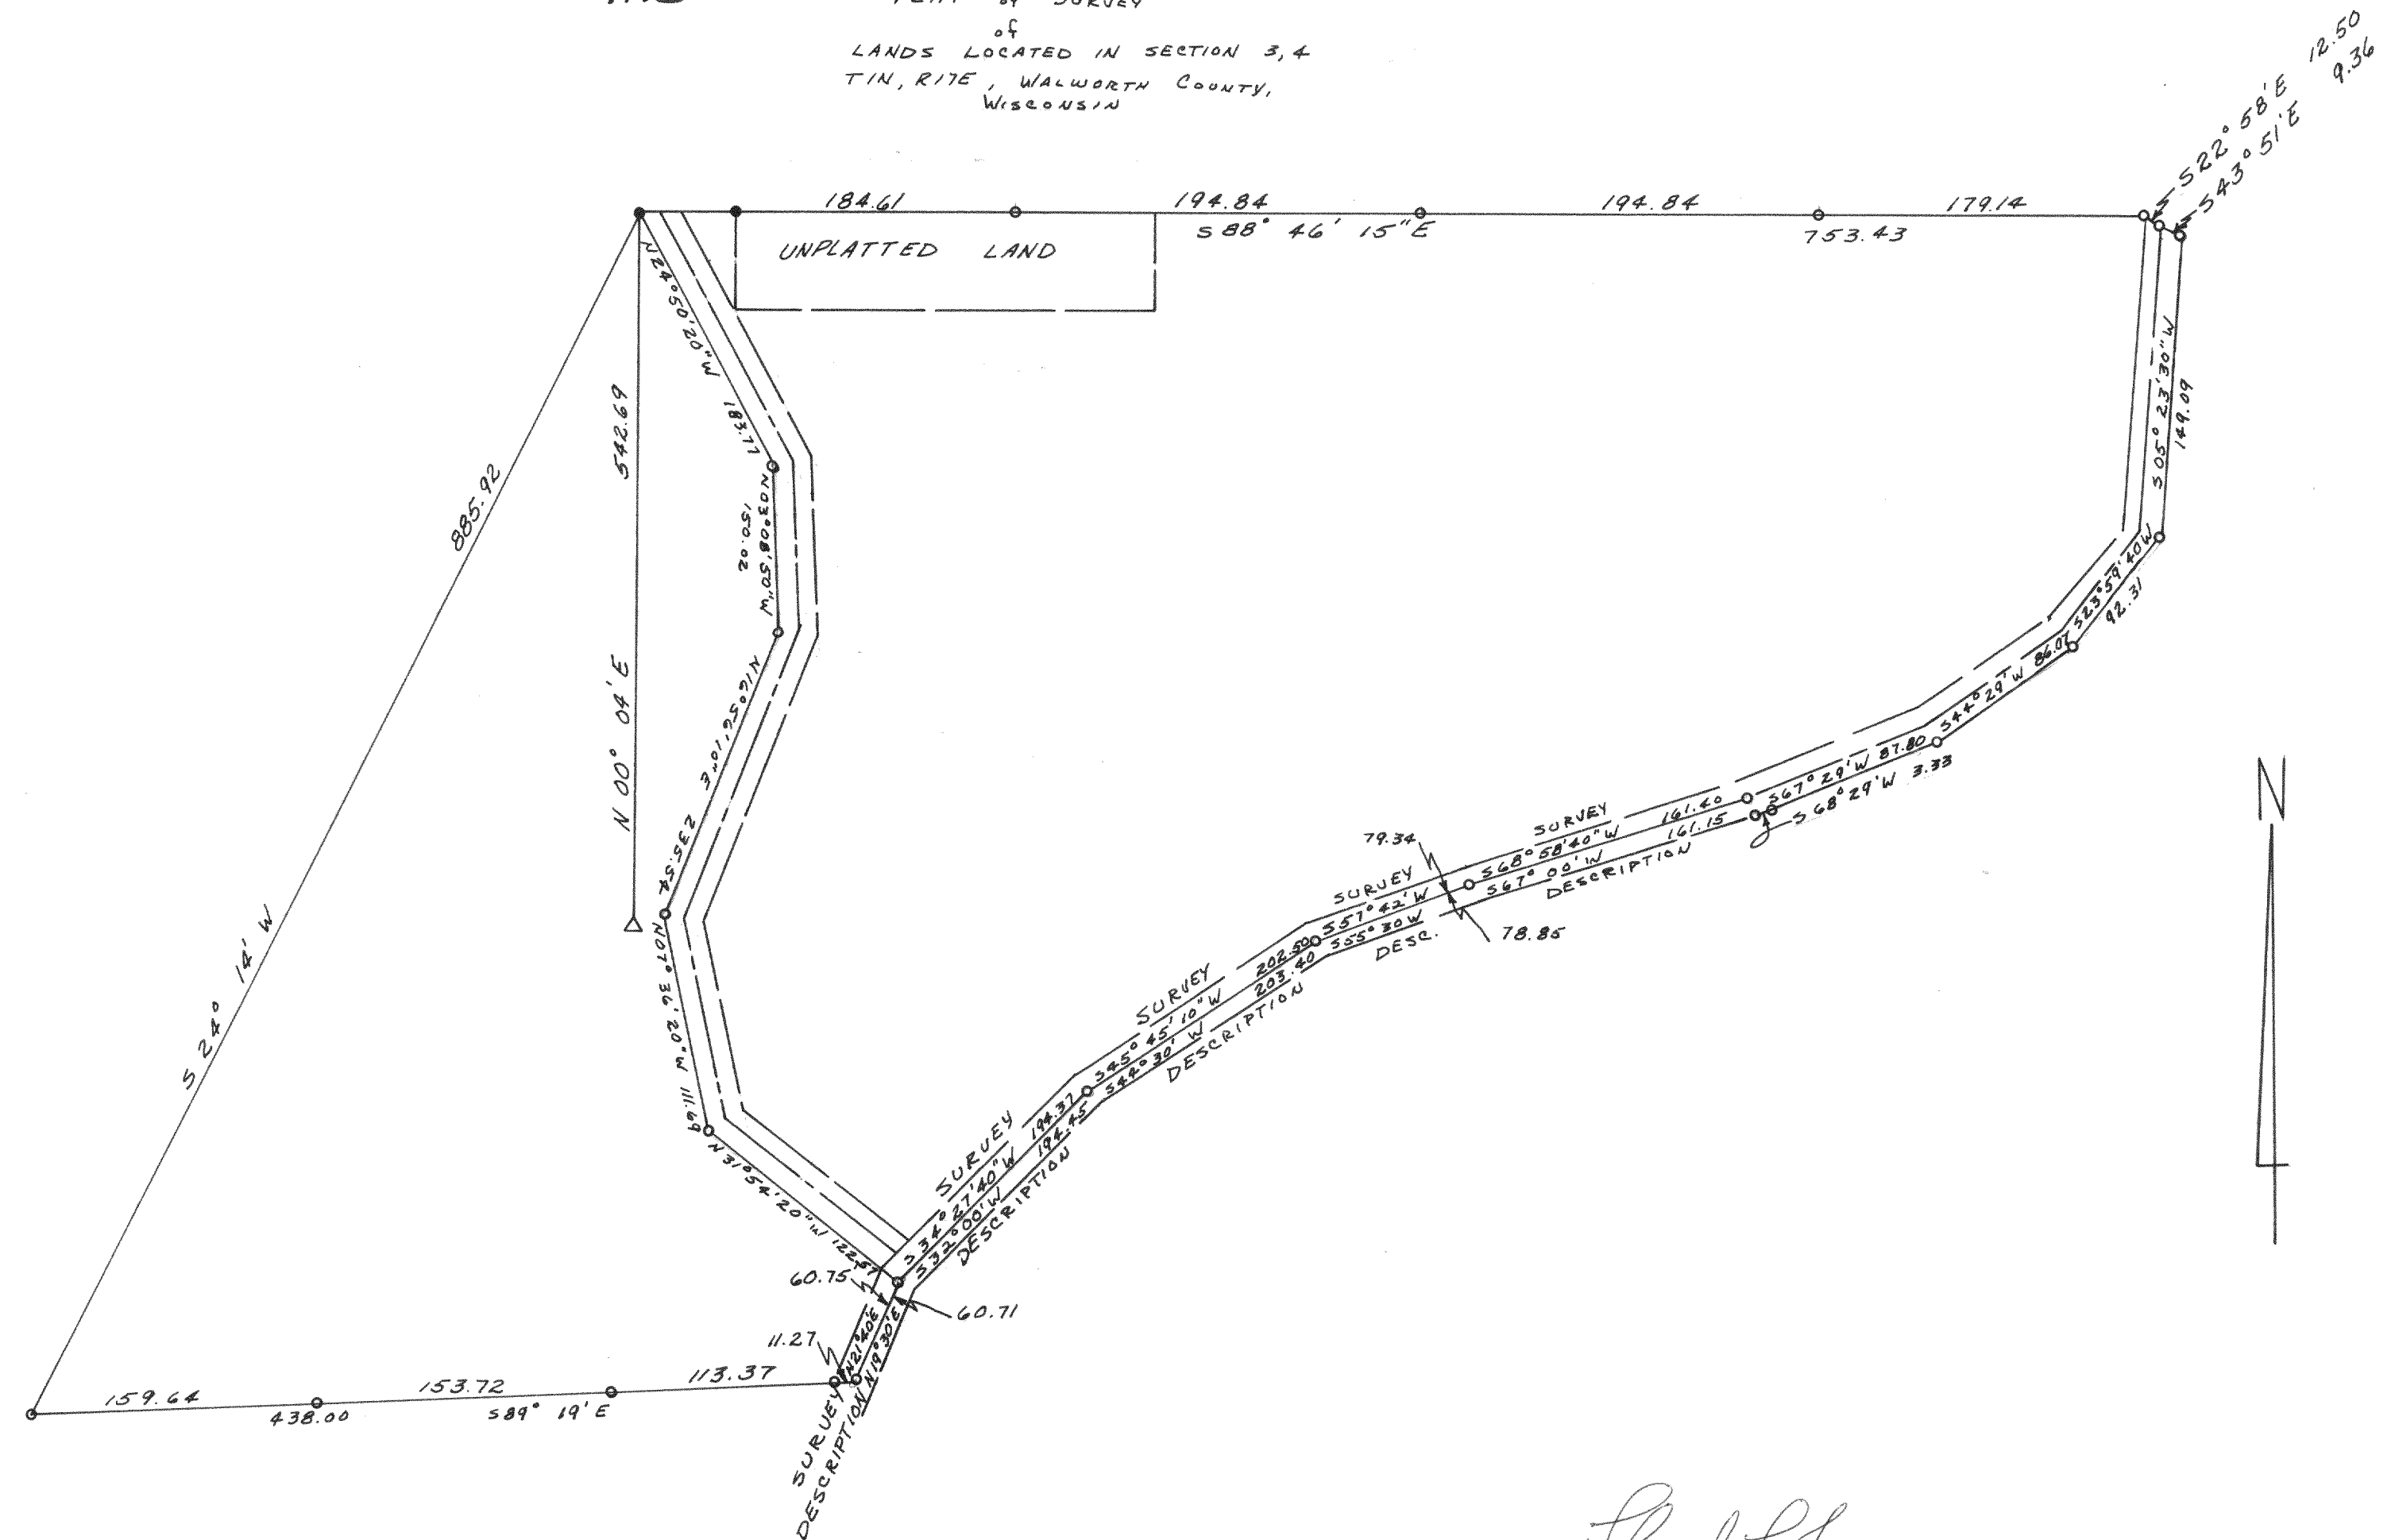

Осень. 1962

Lloyd L. Jensen
WAL. CO. SURVEYOR