


#4129

PLAT OF SURVEY OF
Lot "F" of Lot 1 of Bonnie Brae
Subdivision Located in Sections 3
and 4, T1N R1E OF Walworth
County, Wisconsin.

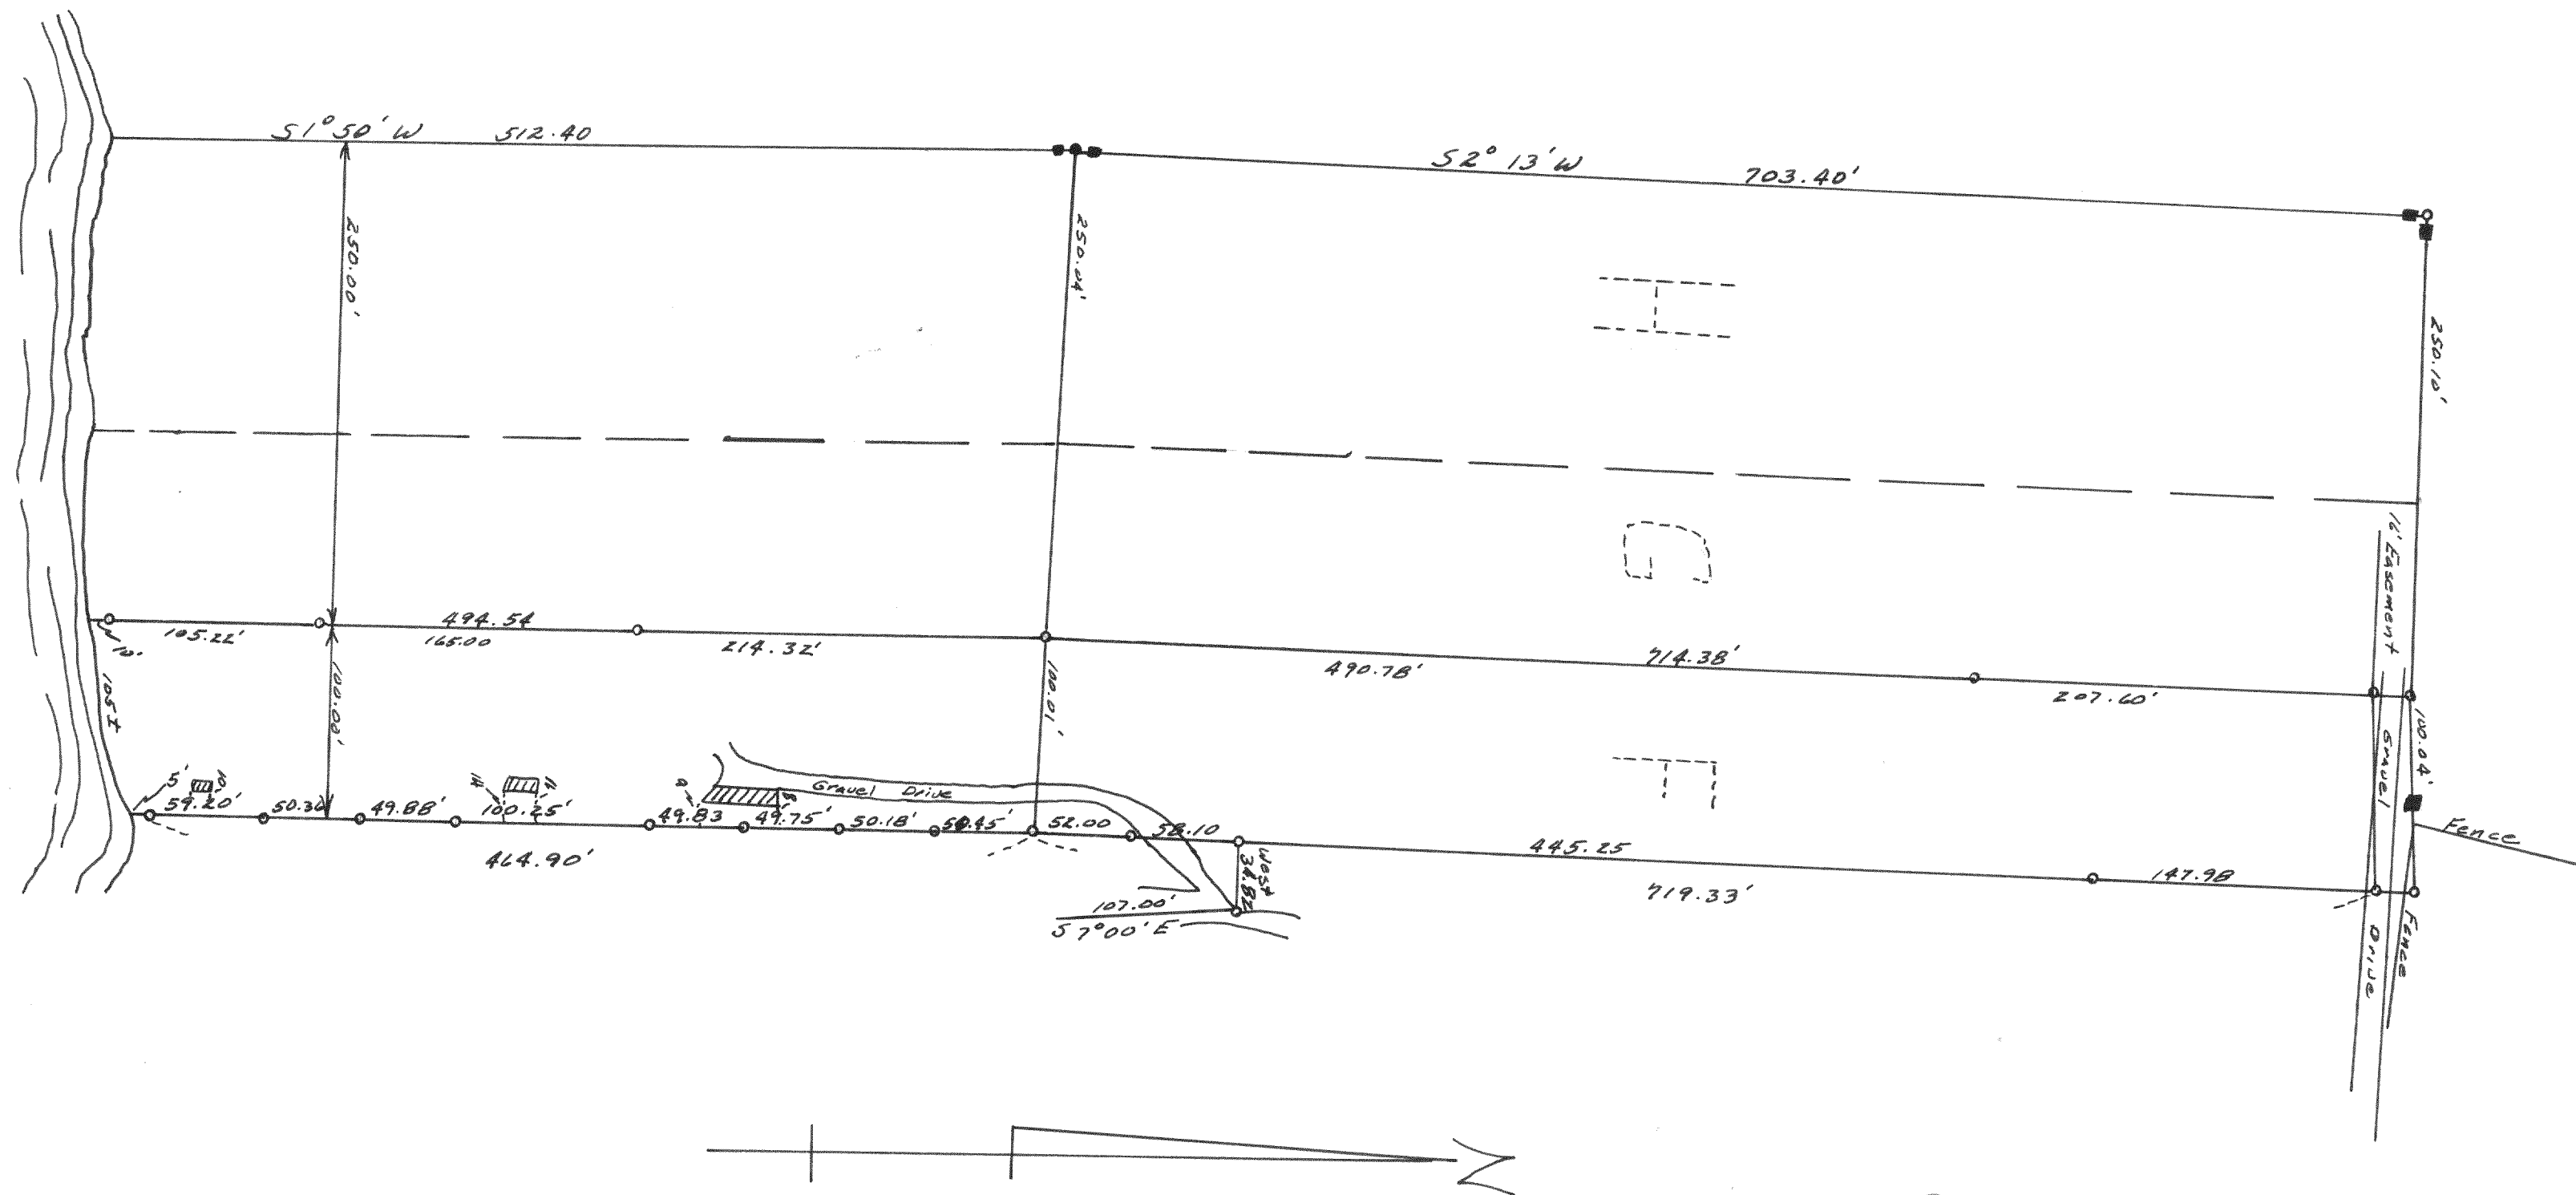

Lloyd L. Jensen
County Surveyor