


4130

PLAT OF SURVEY OF
Lot 1, Block W, Delavan Lake
Assembly Park, Section 21, T2N,
R16E, Walworth County, Wisconsin.

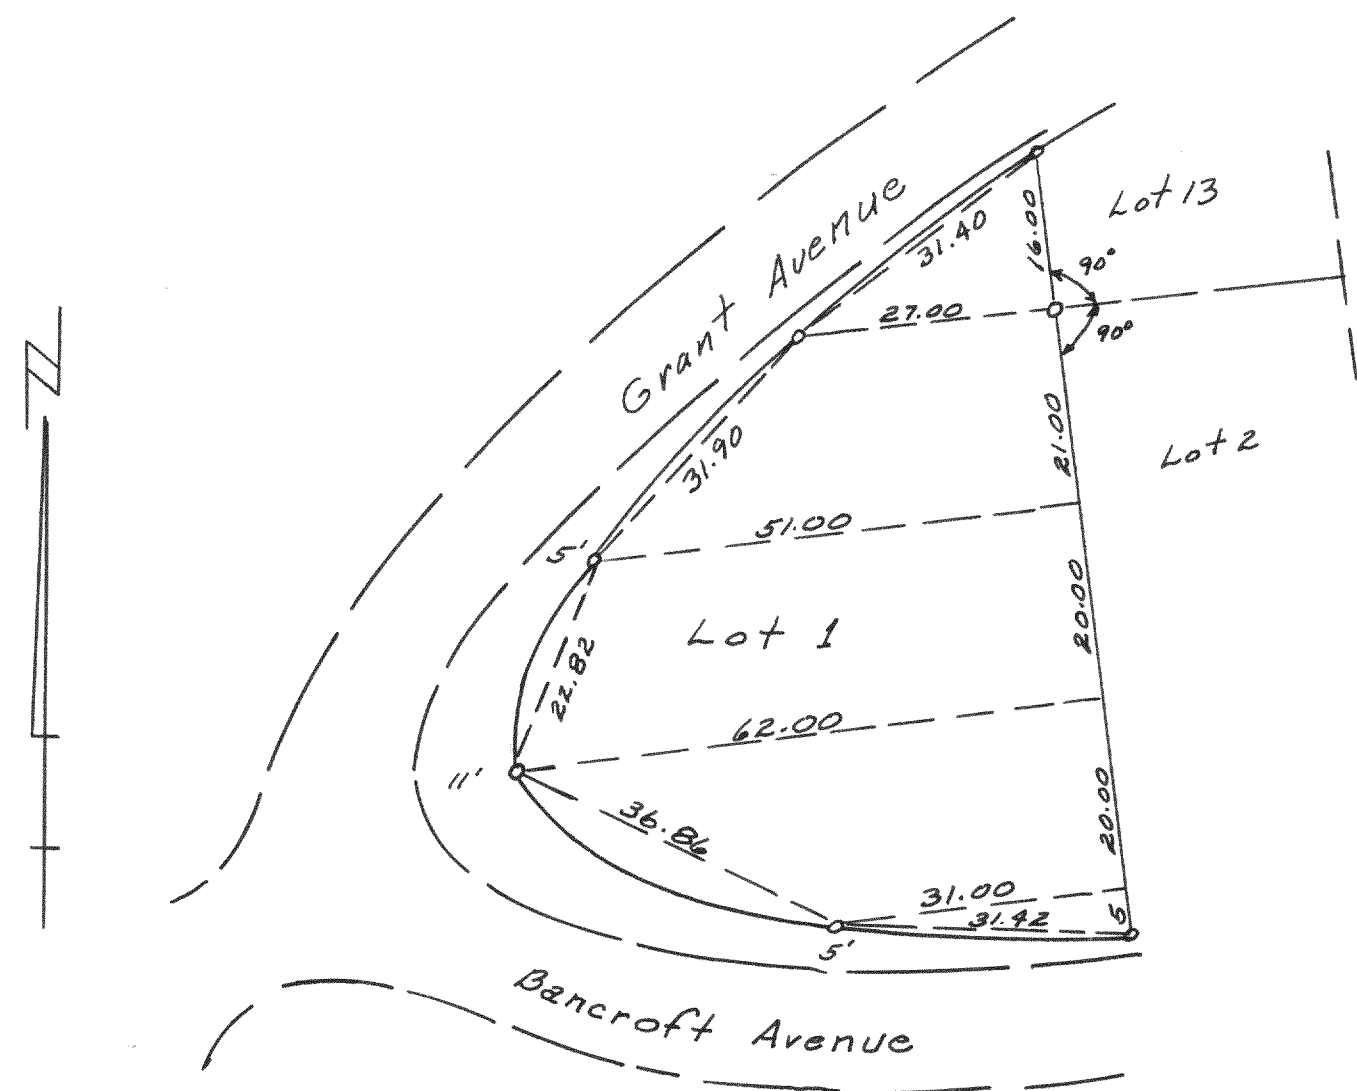


November 24, 1962

Lloyd Jensen
County Surveyor

4131

PLAT OF SURVEY OF
Lot 6 and the West 45 feet of Lot 7
of Cedar Point Subdivision
located in Section 28, T2N, R16E,
Walworth County, Wisconsin.

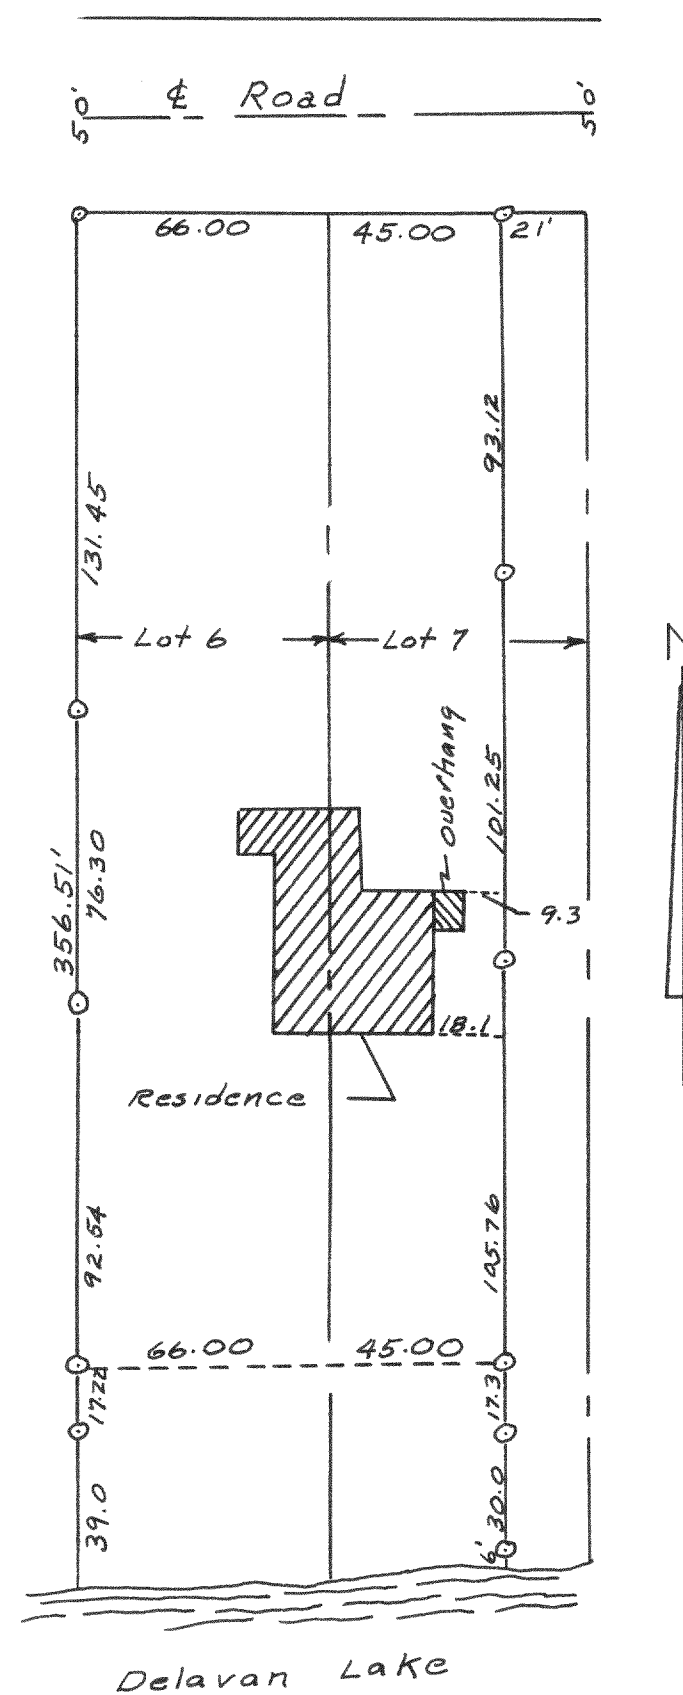

August 4, 1962

Lloyd Jensen
County Surveyor