


4132

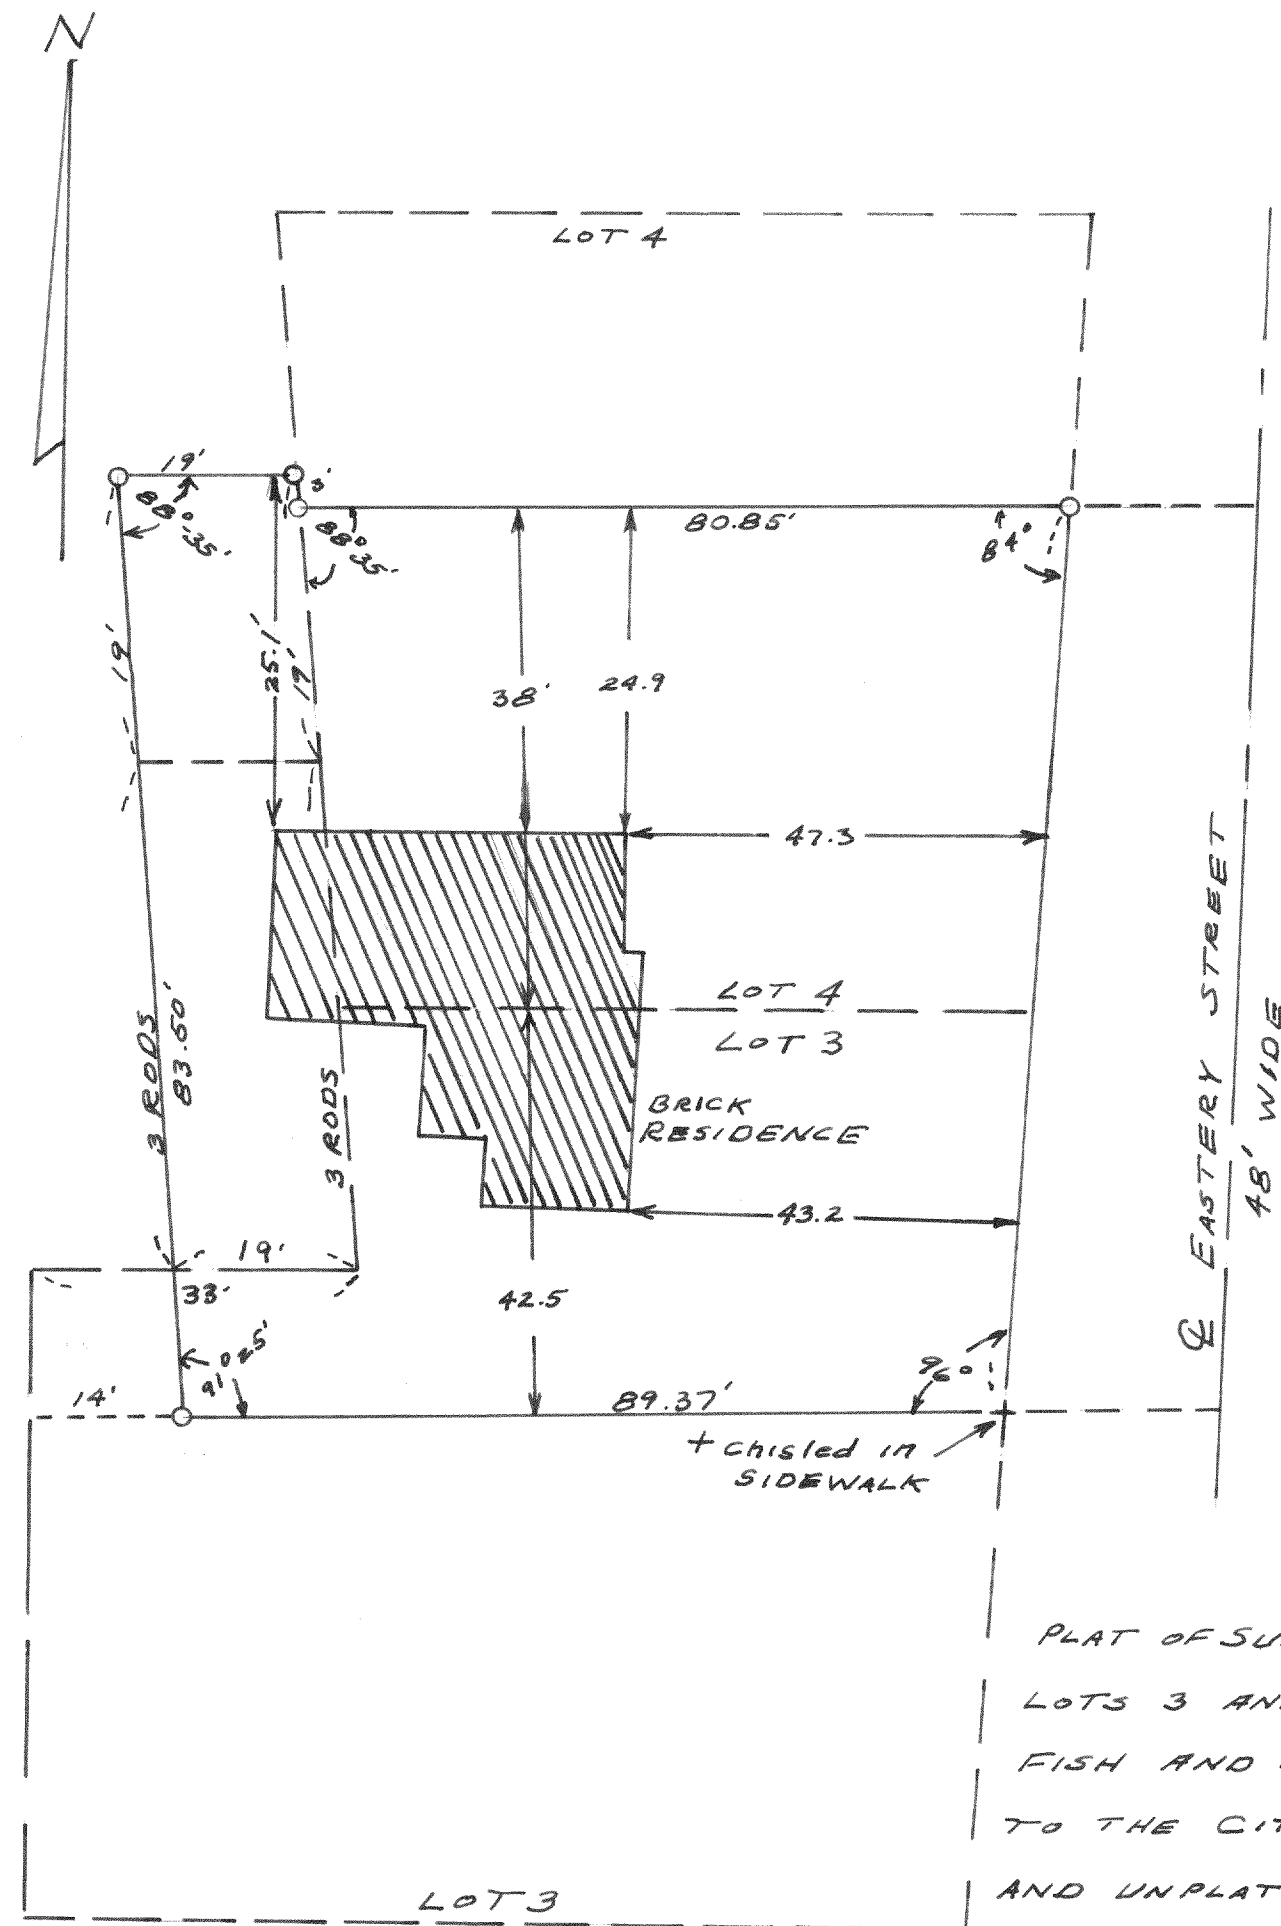


PLAT OF SURVEY OF PART OF
LOTS 3 AND 4, BLOCK 2 OF
FISH AND JOHNSON'S ADD.
TO THE CITY OF WHITEWATER,
AND UNPLATTED LANDS,
WALWORTH COUNTY, WISCONSIN.

MAY 16, 1963

Lloyd Jensen
WALWORTH COUNTY SURVEYOR

4133

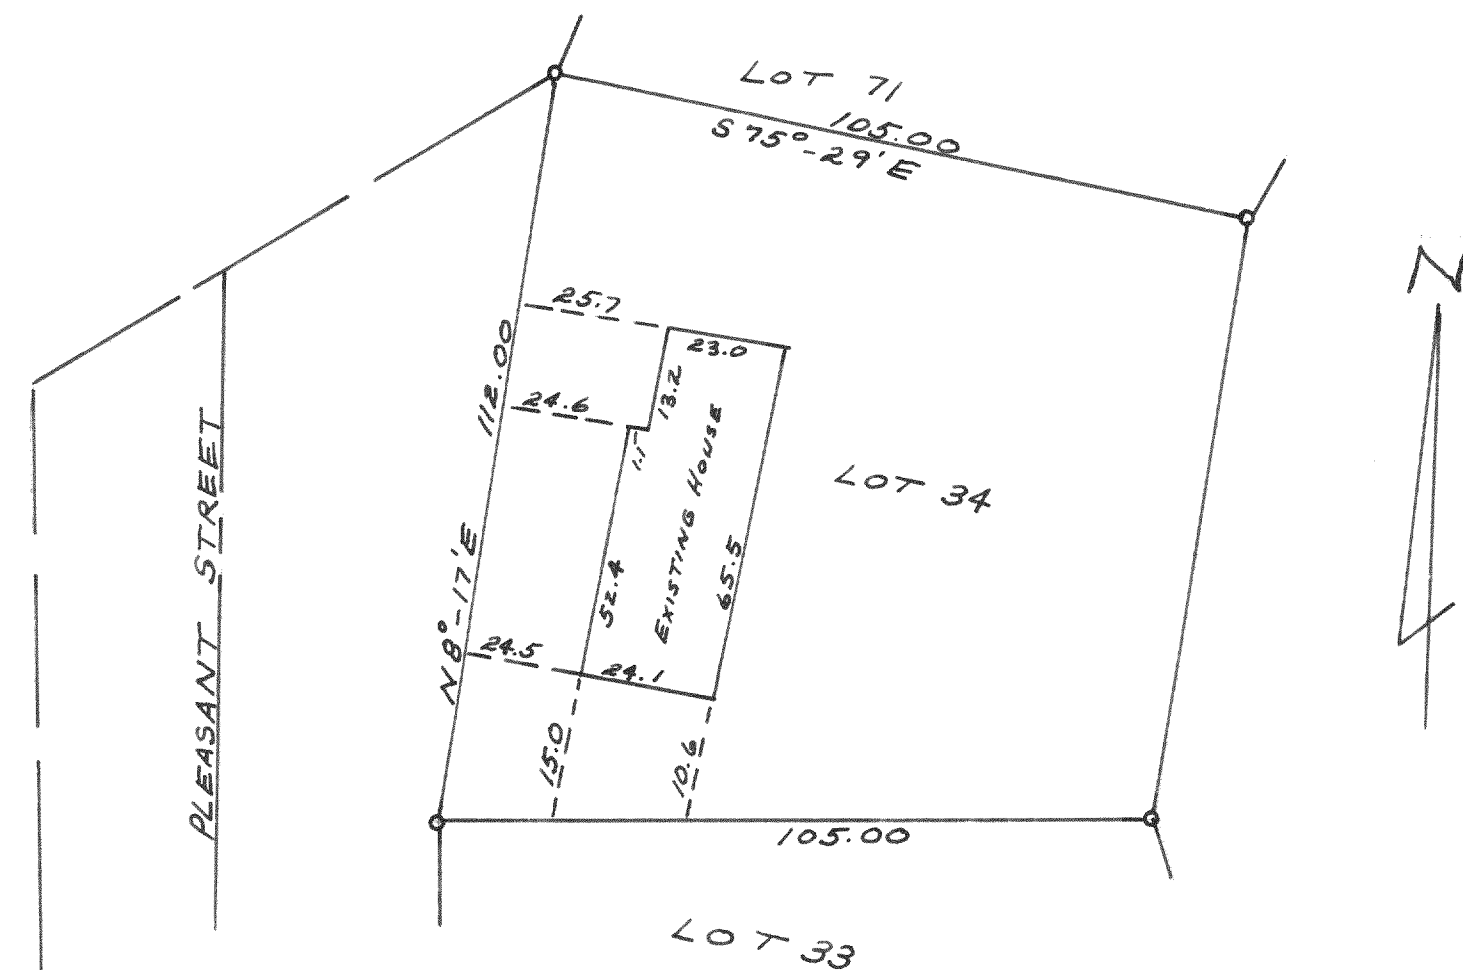

PLAT OF SURVEY OF LOT 34, WEST PARK
ADD. A SUBD. LOCATED IN THE SW 1/4 OF
THE SW 1/4 OF SECTION 5, T4N, R15E,
CITY OF WHITEWATER, WALWORTH
COUNTY, WISCONSIN

OCT. 28, 1963

Lloyd Jensen
COUNTY SURVEYOR