


4138


PLAT OF SURVEY OF
The North 73 Feet of Lot 1 of
Block 32 of The Original Plat of
The City of Elkhorn
Walworth County, Wisconsin

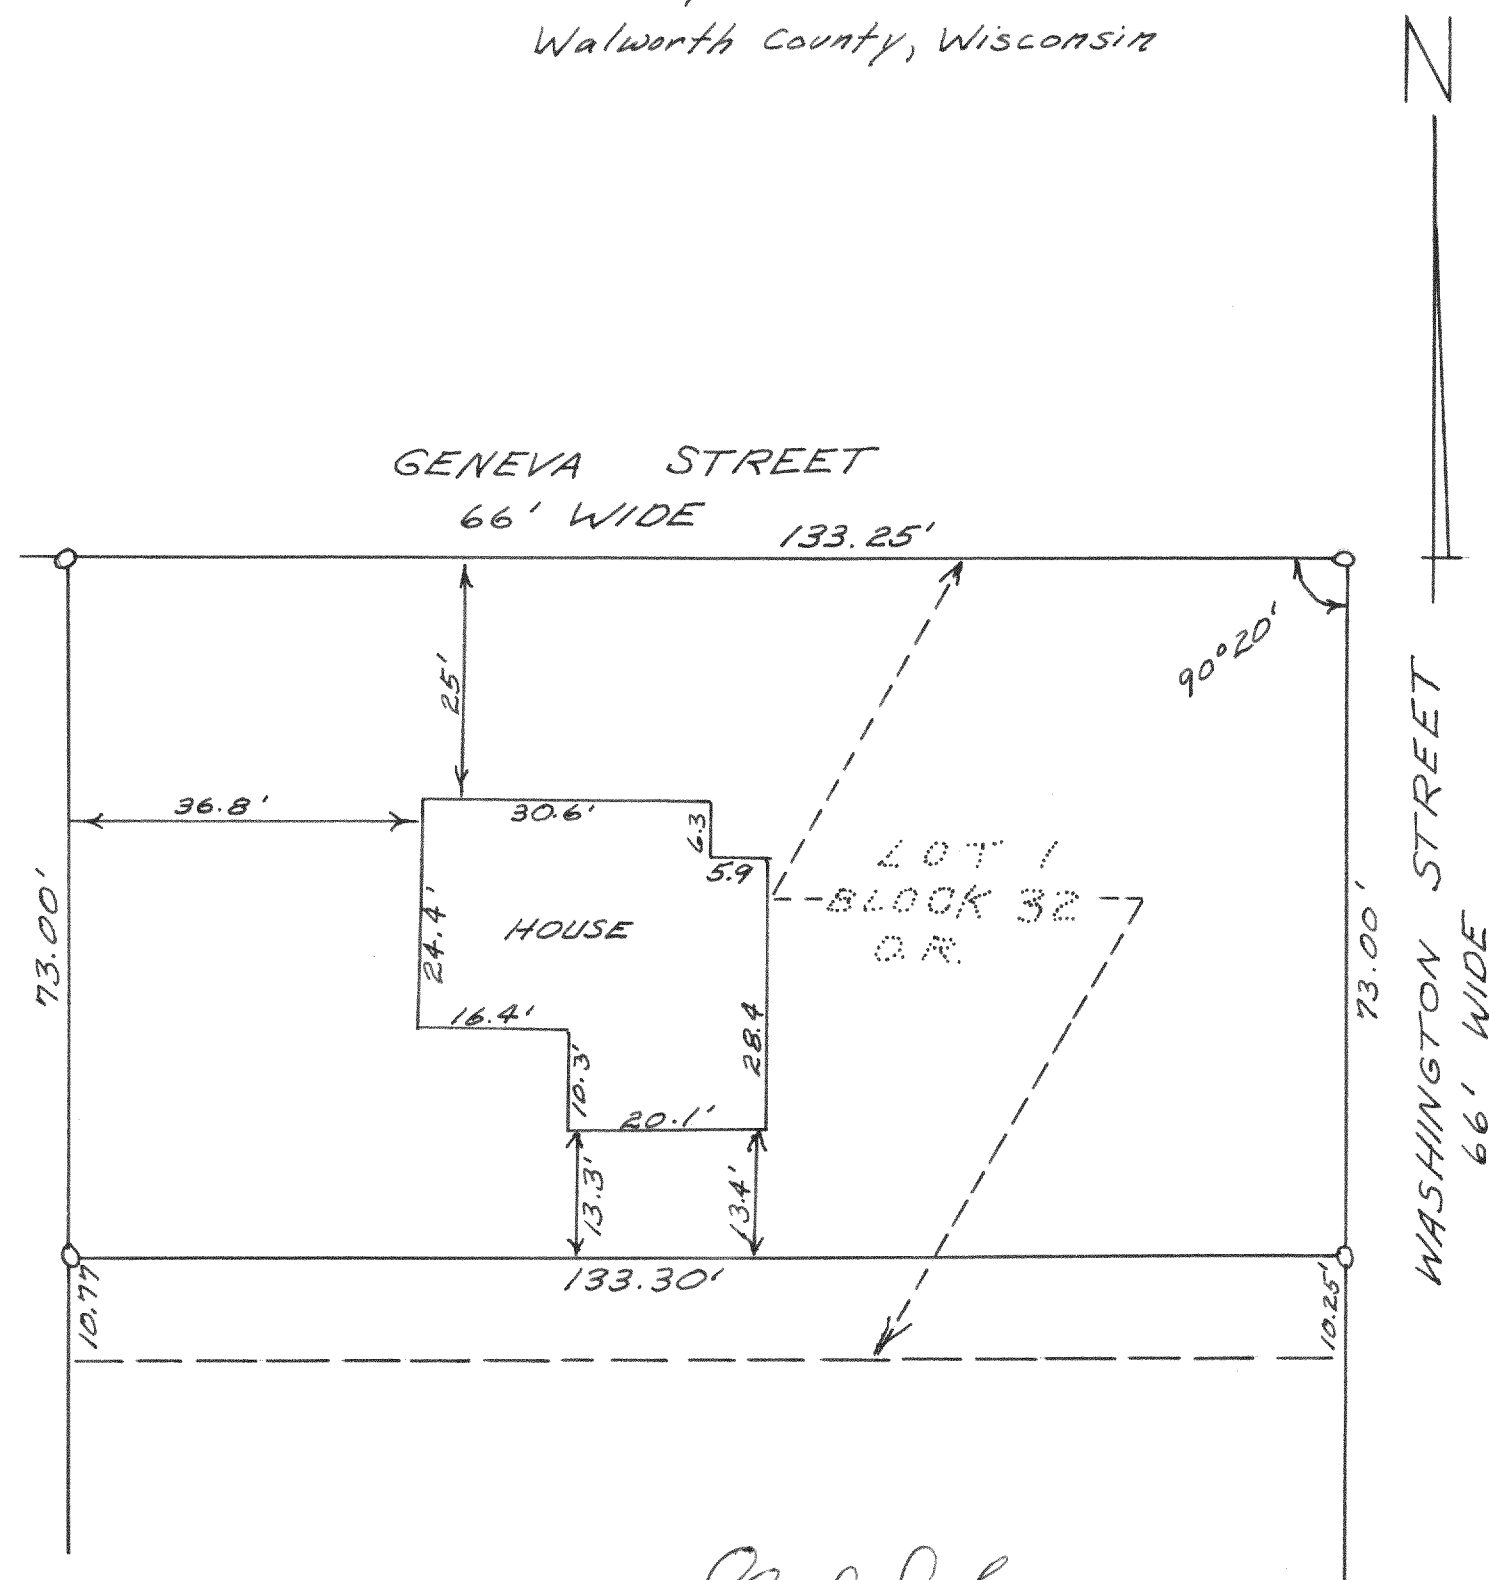

August 1962
Lloyd Jensen
County Surveyor

4139

Plat of Survey of
Part of Lots 9 & 11, Block 1, Trinke Estates
Located in the SE 1/4 of Section 10, T1N R17E
Walworth County, Wisconsin

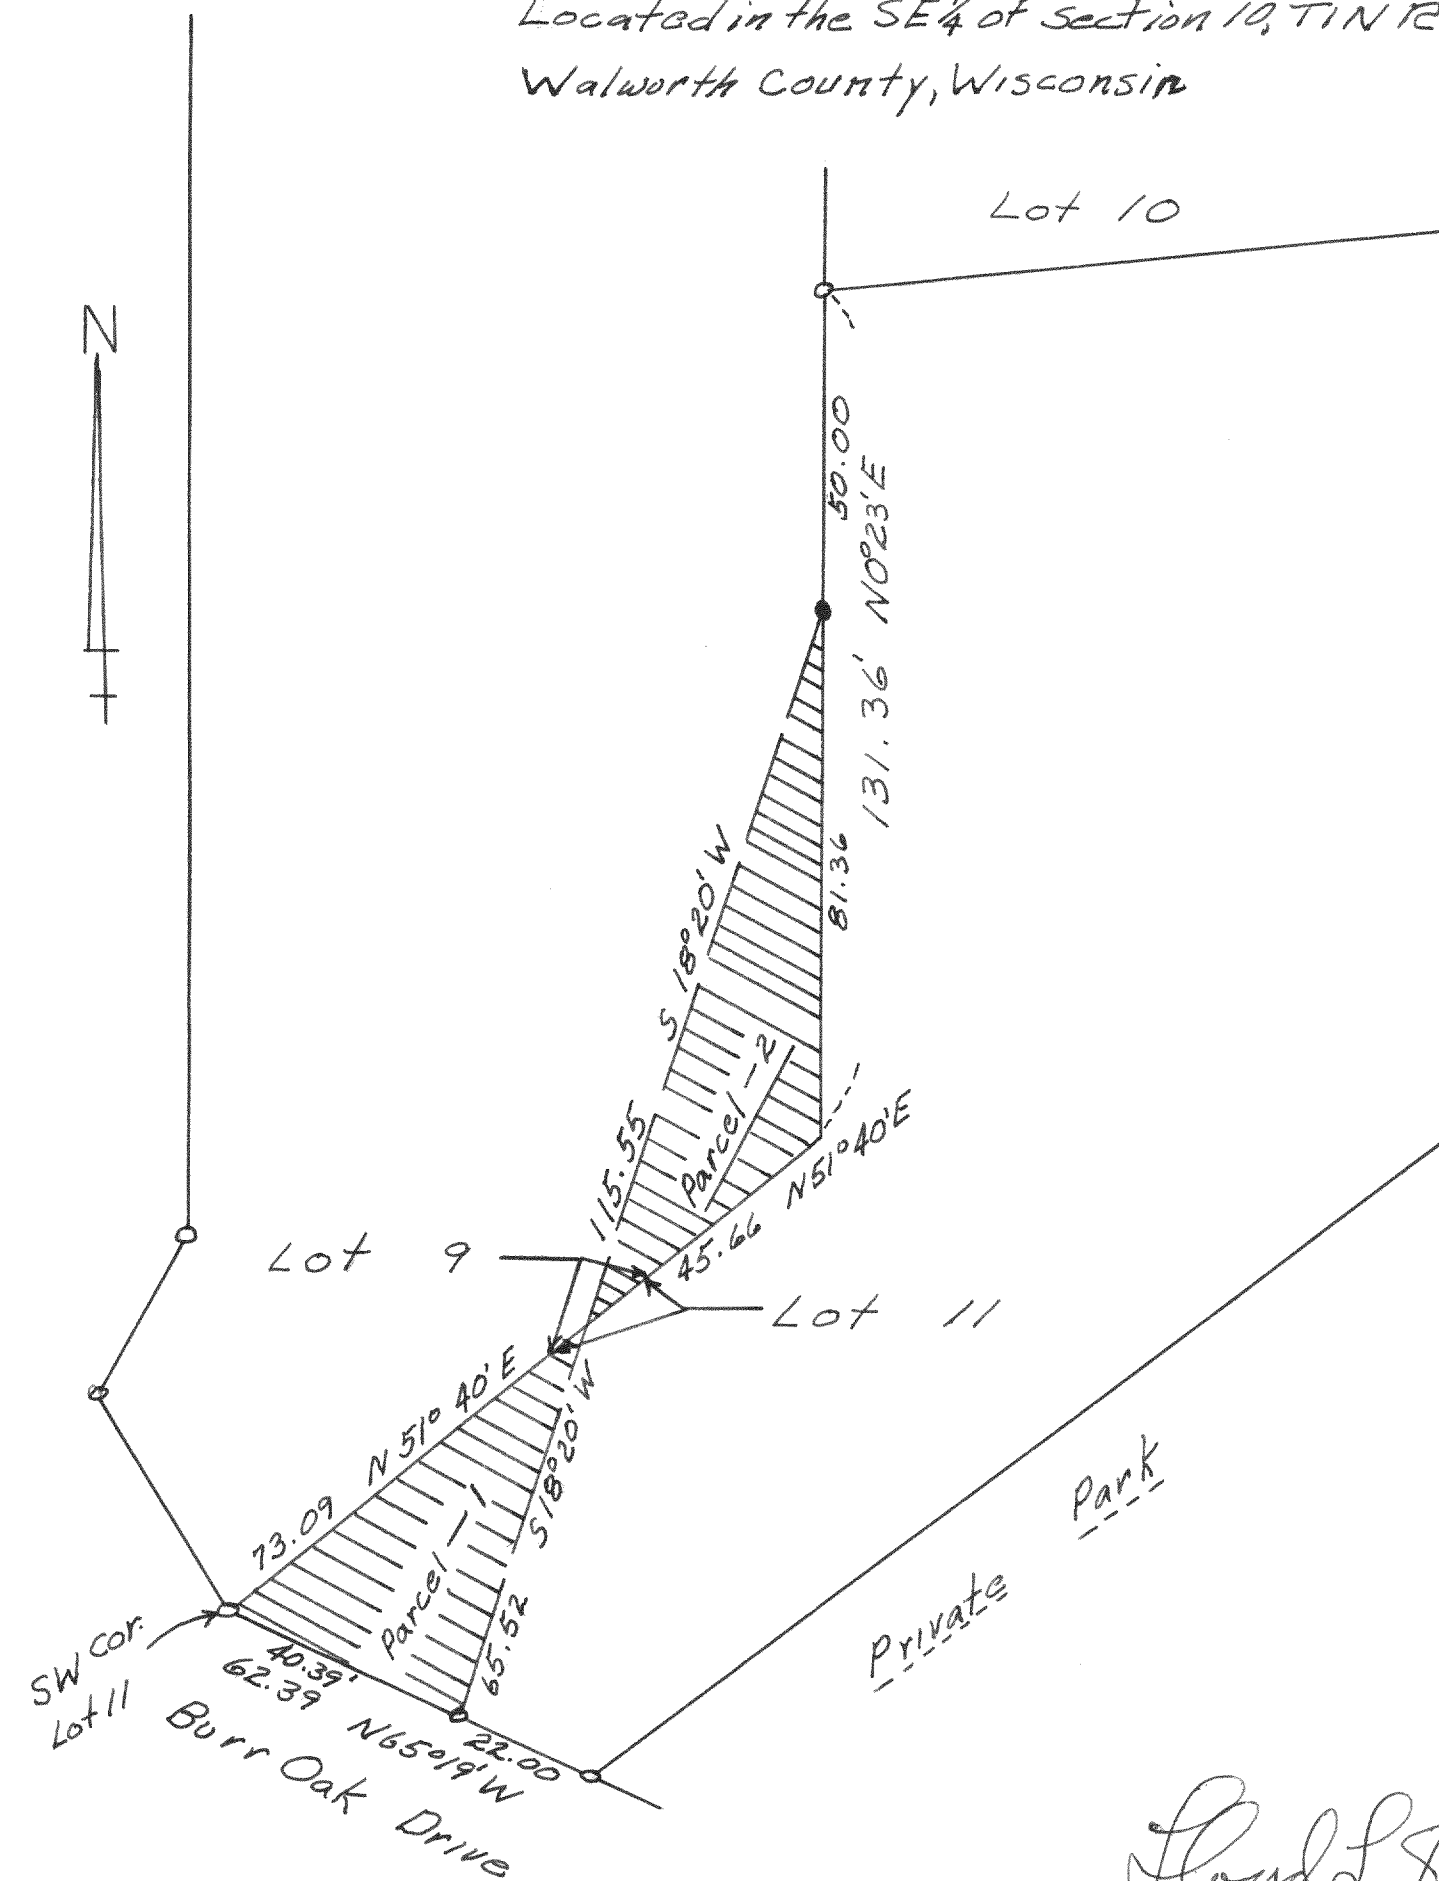

October 7, 1962
Lloyd Jensen
County Surveyor