


#4142

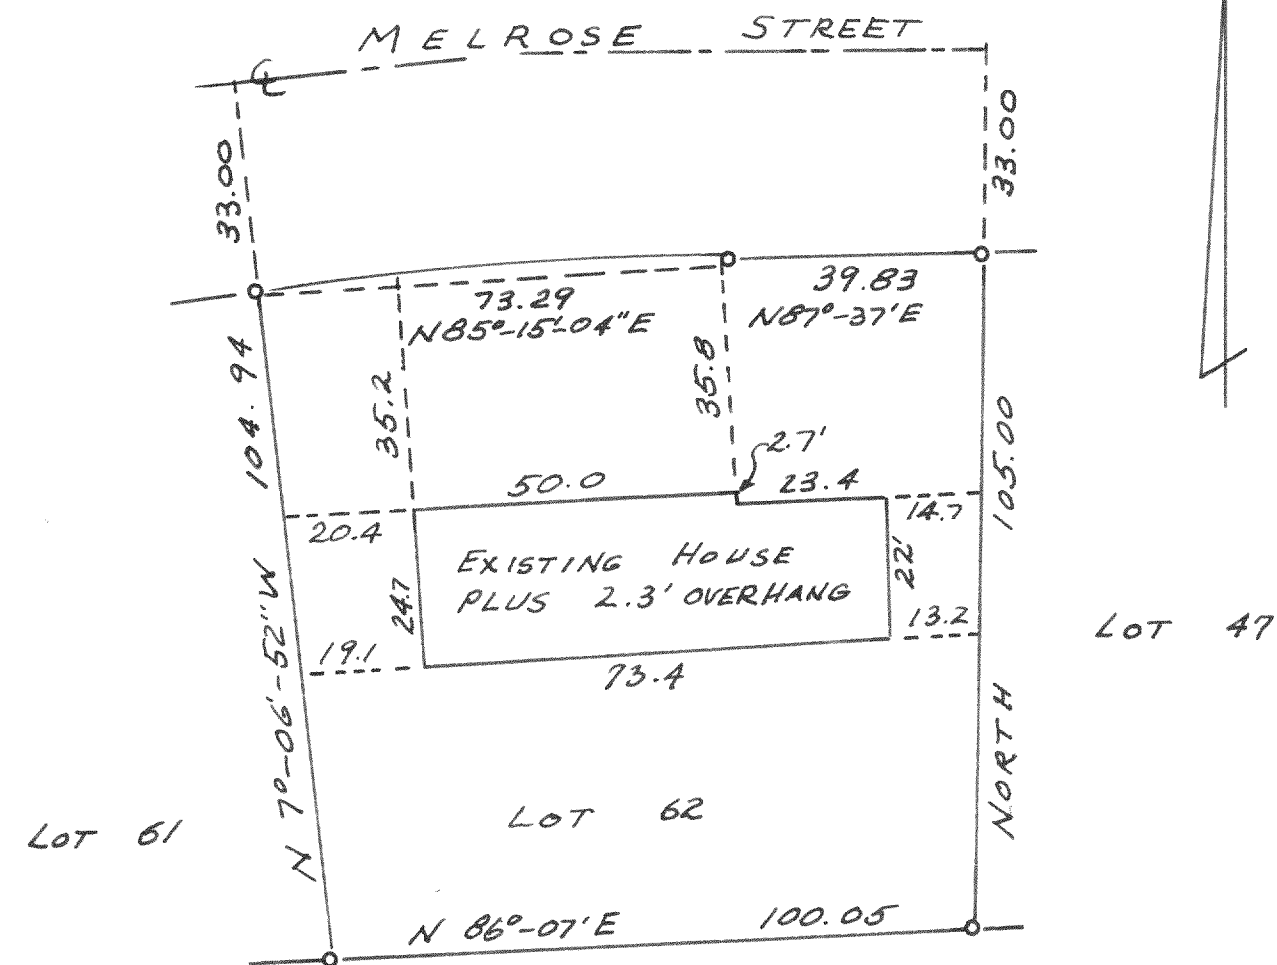


LOT 63

PLAT OF SURVEY OF LOT 62, WESTPARK SECOND ADD. BEING LOCATED IN THE SW 1/4 OF SECTION 5, T4N, R15E, CITY OF WHITEWATER, WALWORTH COUNTY, WISCONSIN.

OCT. 1963

Lloyd L Jensen
COUNTY SURVEYOR

#4143

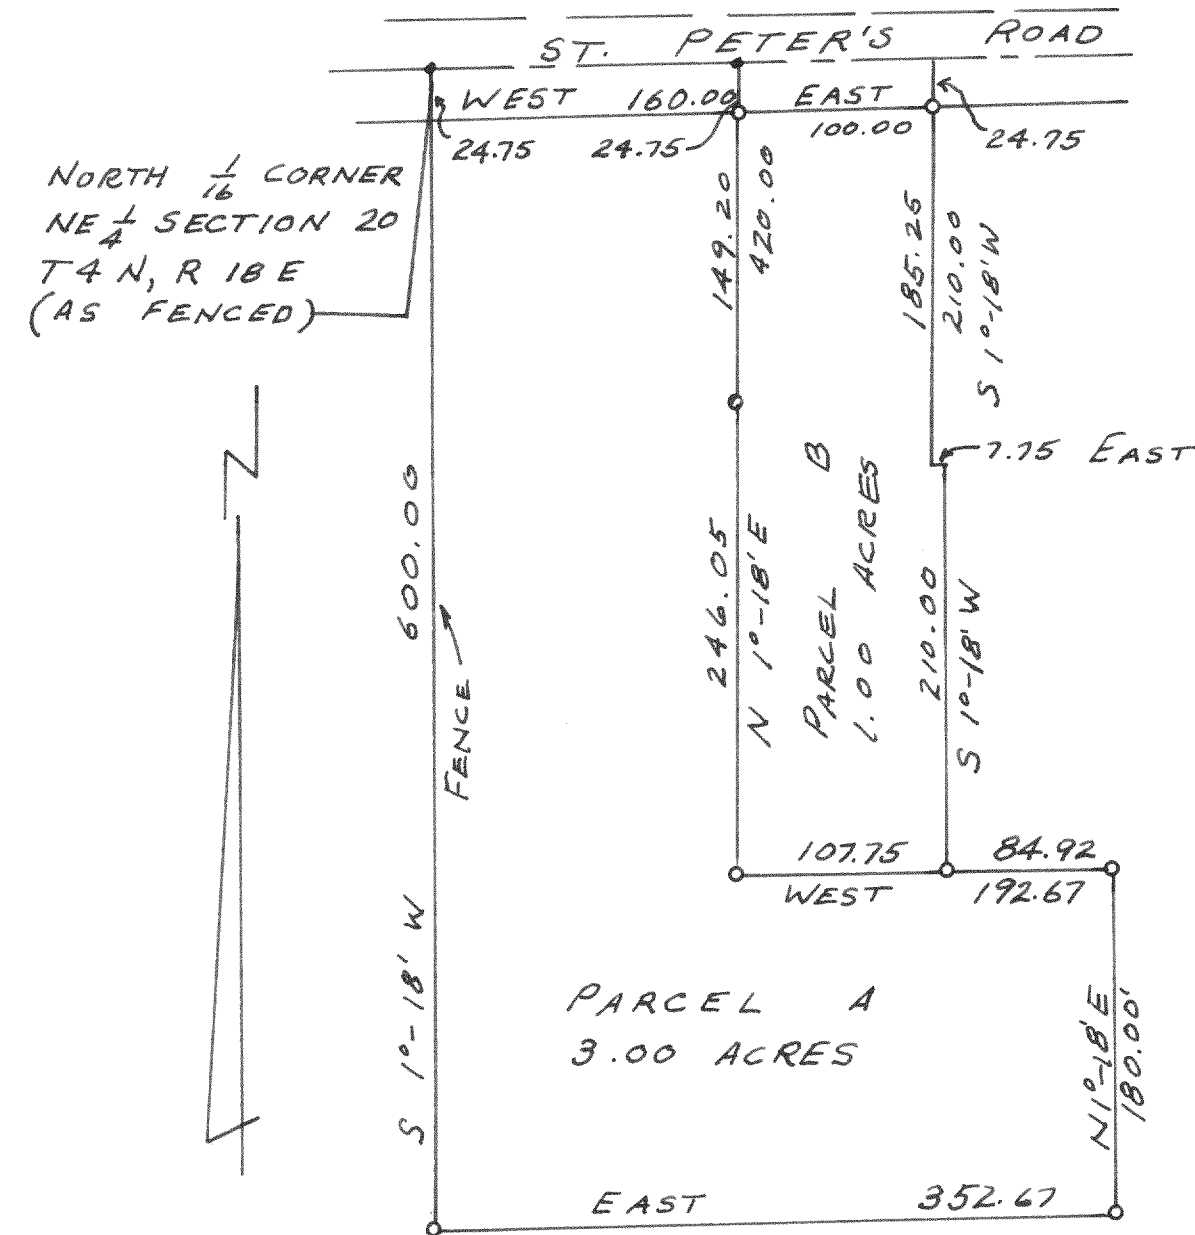

OCT. 1963

Lloyd L Jensen
WALWORTH COUNTY SURVEYOR