


PLAT OF SURVEY OF

4144

LOTS 230, 231 &
232 OF THE 3RD
ADDITION TO
CEDAR POINT
PARK OF WM
BAY, WISCONSIN

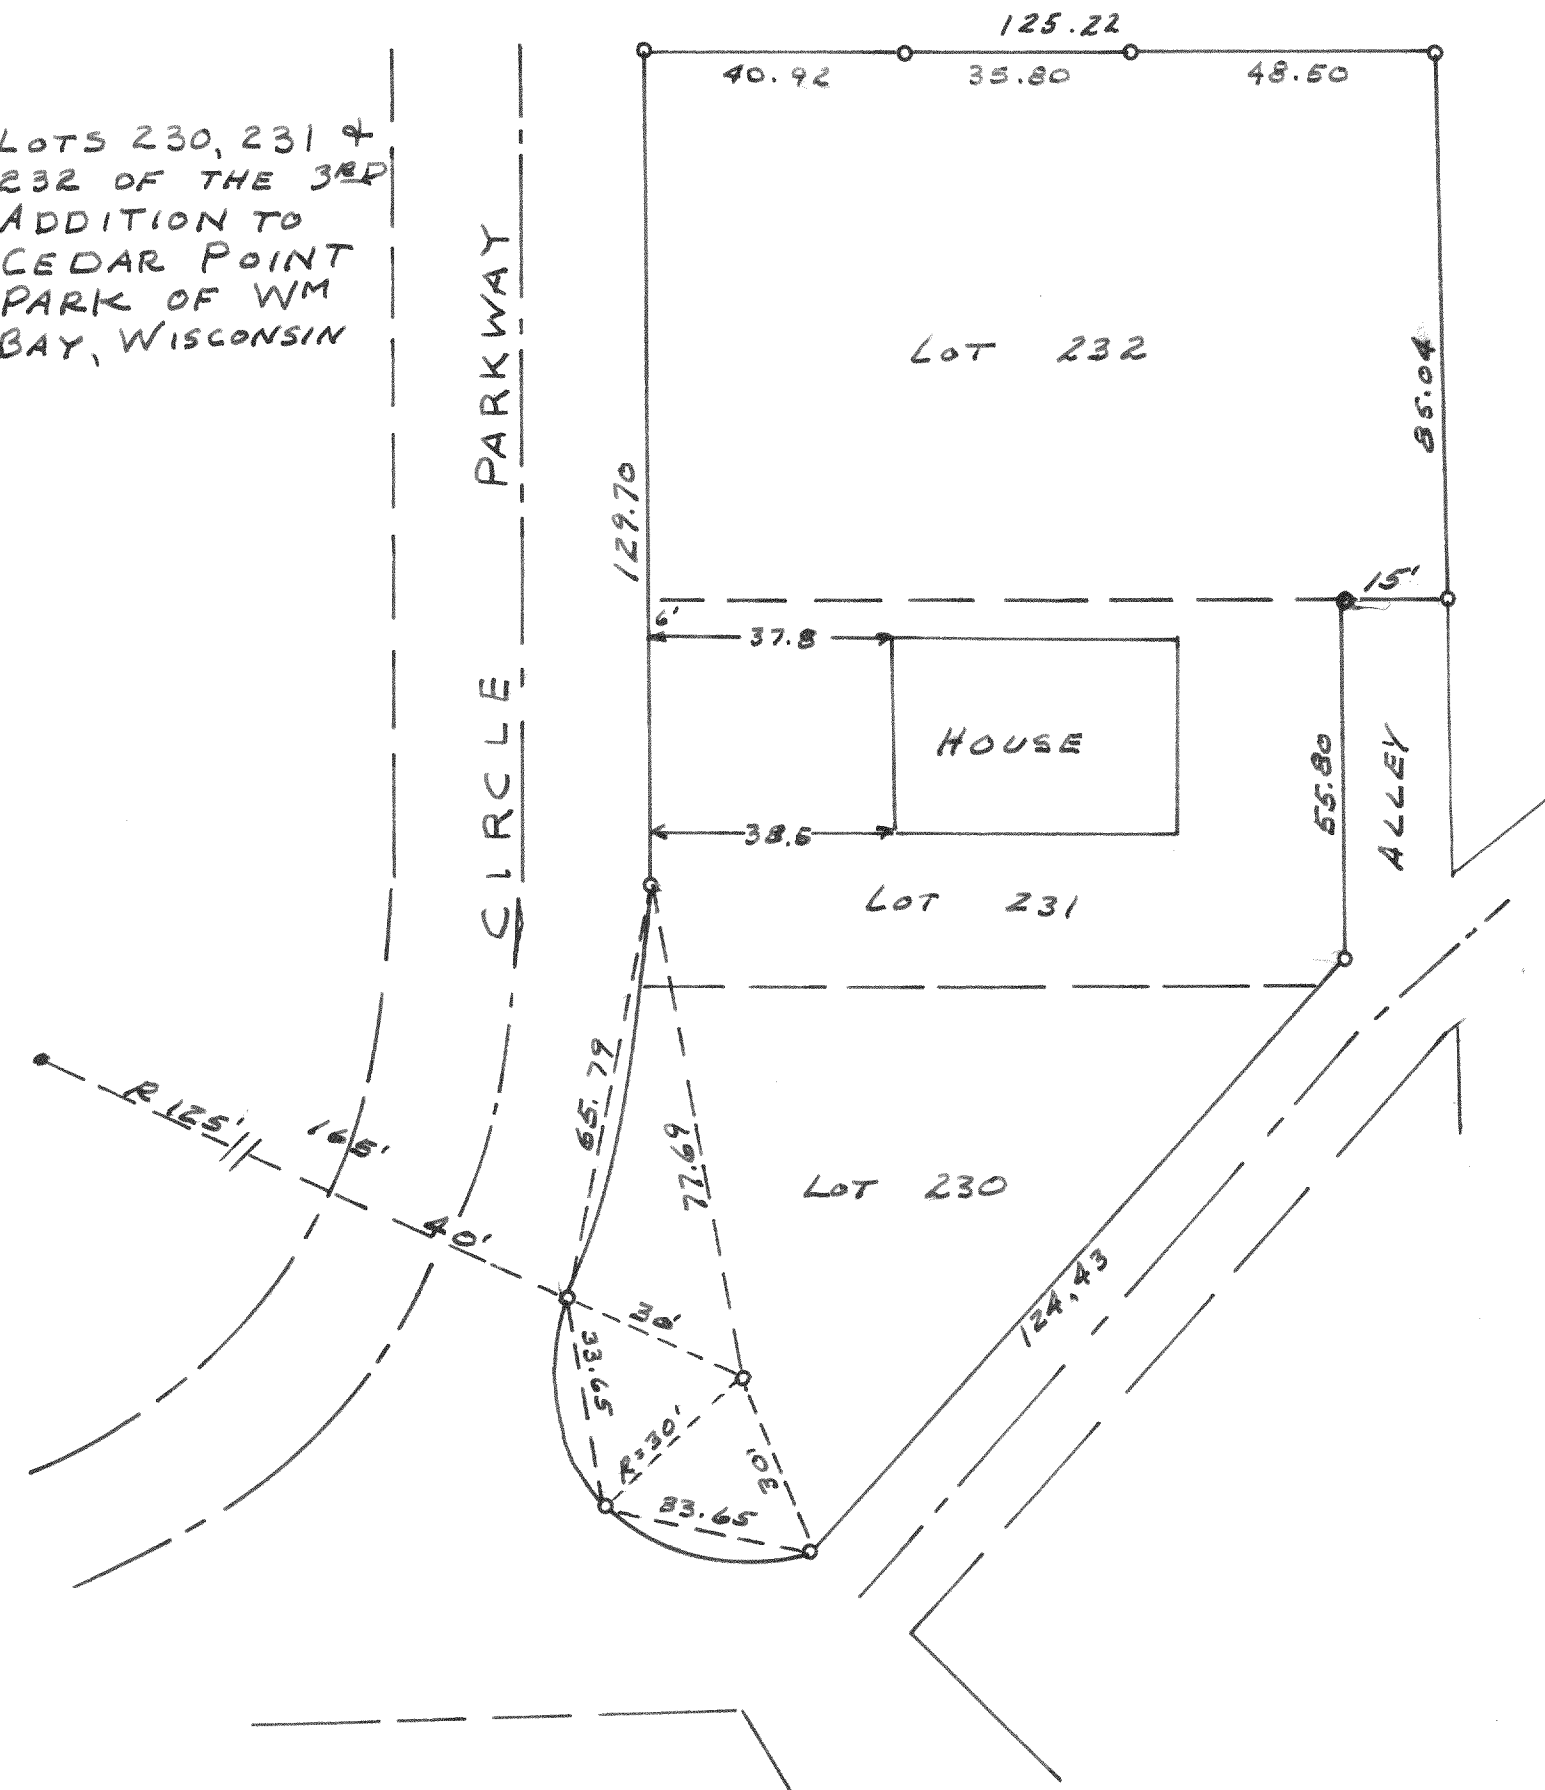

SEPT. 1963

Lloyd Jensen
COUNTY SURGEON

PLAT OF SURVEY
#4145 OF

LOT 32 OF LYNNDALE SUBDIVISION
LOCATED IN THE SE $\frac{1}{4}$ -NW $\frac{1}{4}$ AND THE
SW $\frac{1}{4}$ NW $\frac{1}{4}$ OF SECTION 20, T4N, R16E
VILLAGE OF EAST TROY, WALWORTH
COUNTY, WISCONSIN

JULY 13, 1963

Lloyd L Jensen
COUNTY SURVEYOR

