


4148

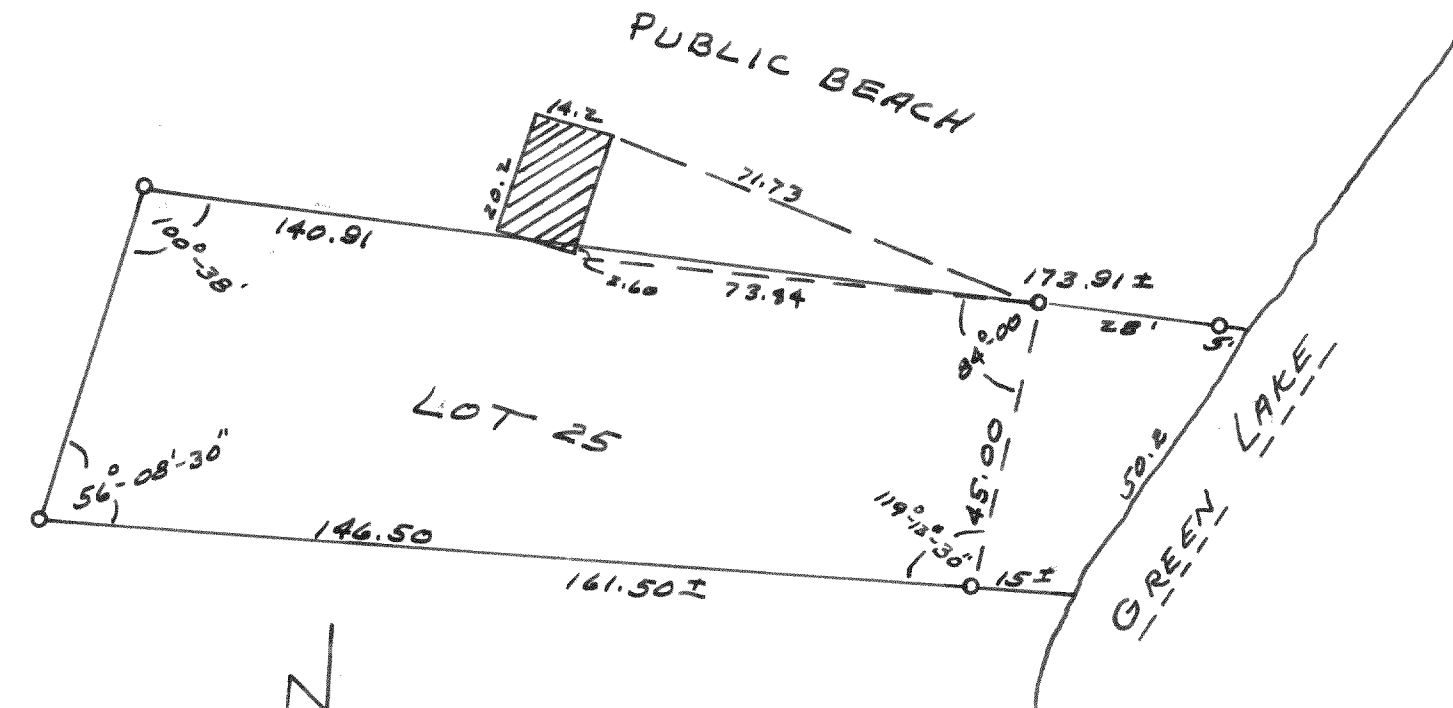


PLAT OF SURVEY OF
LOT 25 OF FROEDTERTS GREEN
LAKE PARK, A SUBDIVISION
LOCATED IN THE NW¼ OF SECTION
26, T4N, R16E, TOWN OF
LAGRANGE, WALWORTH COUNTY,
WISCONSIN.

NOV. 20, 1963

Lloyd S. Jensen
COUNTY SURVEYOR

4149

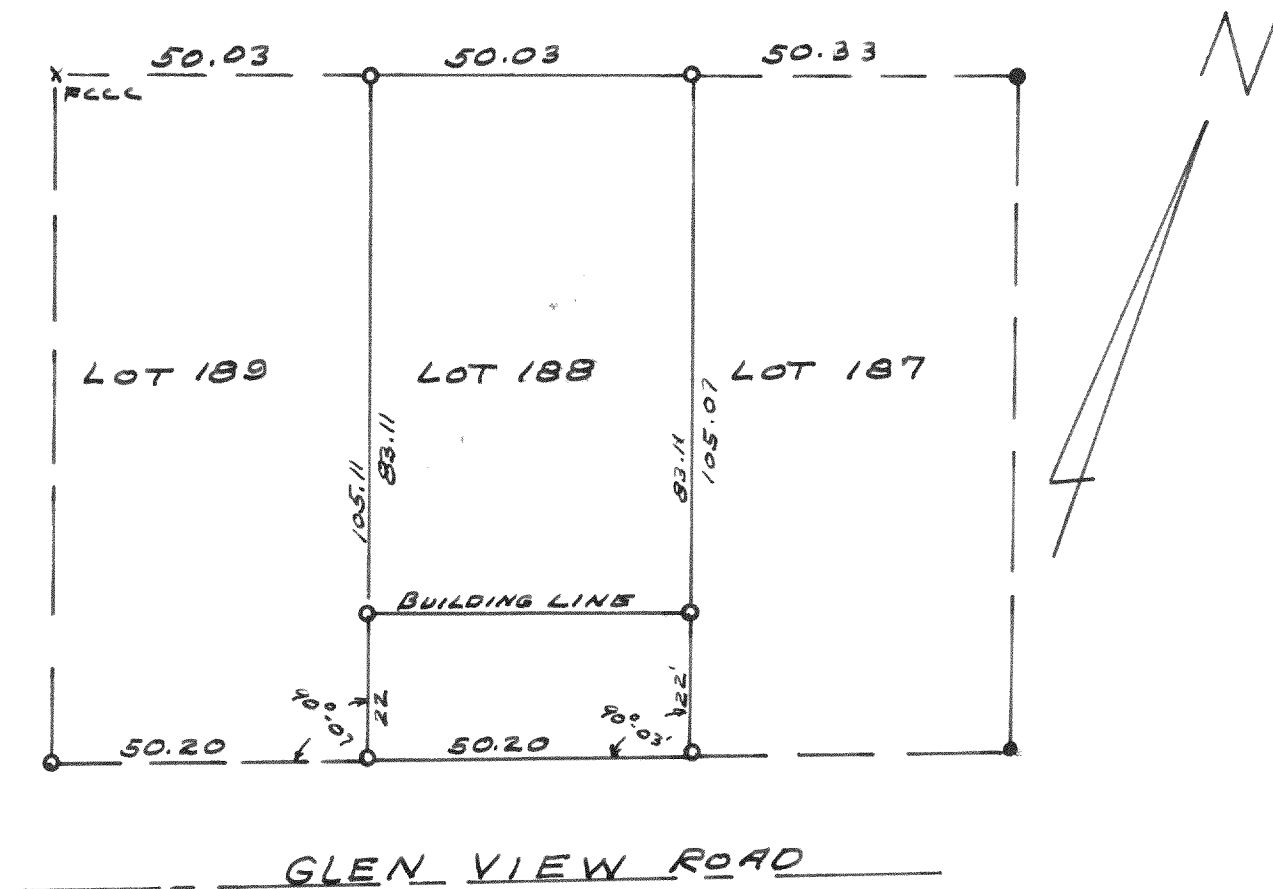

PLAT OF SURVEY OF
LOT 188 OF CEDAR POINT PARK,
2ND ADDITION TO WILLIAMS BAY,
WISCONSIN.

SEPT. 1963

Lloyd S. Jensen
COUNTY SURVEYOR