



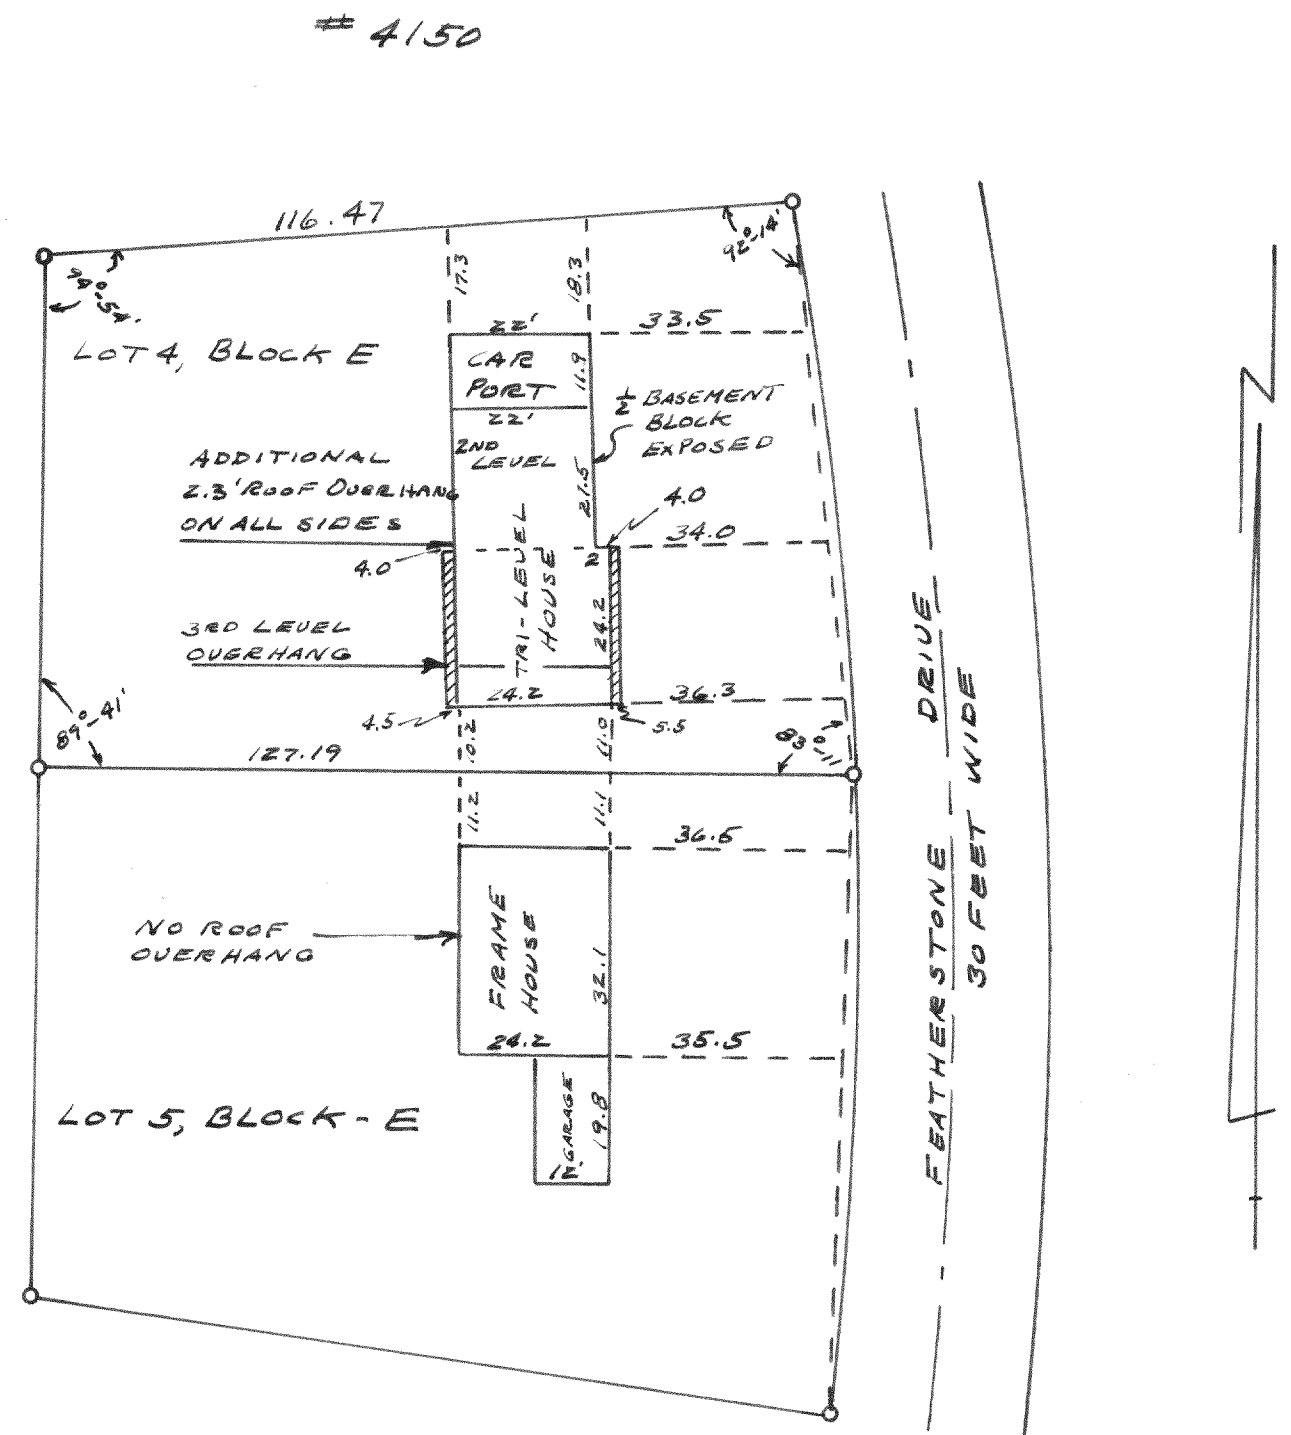

PLAT OF SURVEY OF
LOT 4, BLOCK E, UNIT NUMBER 3 OF
COUNTRY CLUB ESTATES, A SUBDIVISION
LOCATED IN THE S½ OF SECTION 14 & THE
N½ OF SECTION 23, T1N, R1E, WALWORTH
COUNTY, WISCONSIN.

AUGUST 29, 1963

Lloyd L Jensen
COUNTY SURVEYOR

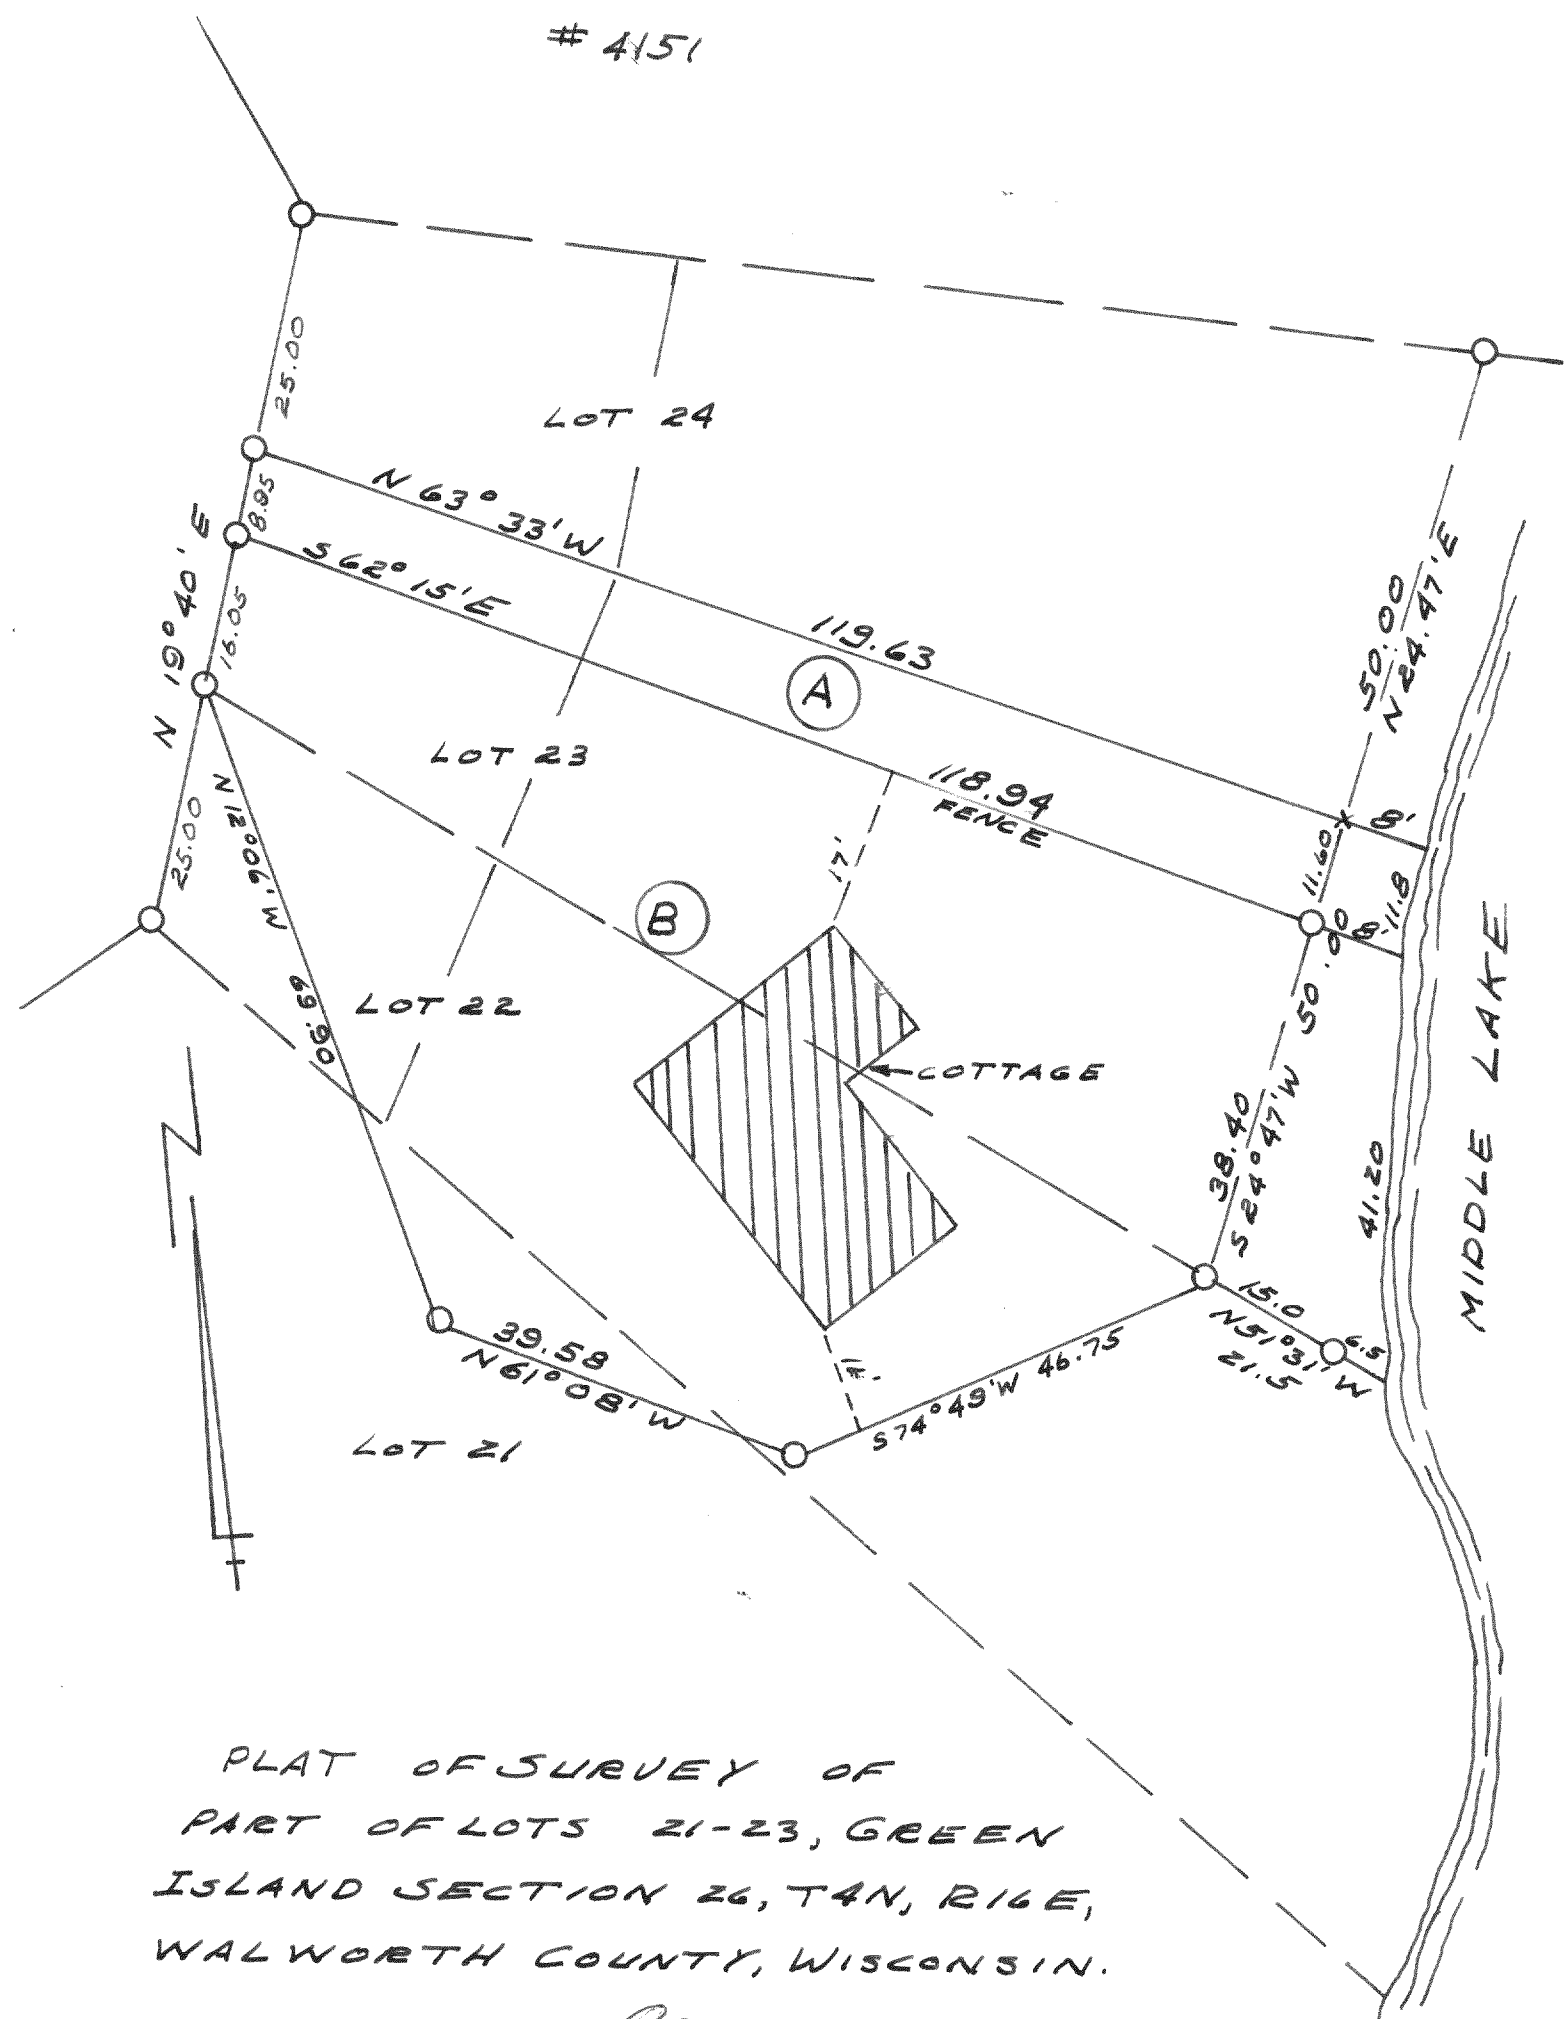

PLAT OF SURVEY OF
PART OF LOTS 21-23, GREEN
ISLAND SECTION 26, T4N, R1E,
WALWORTH COUNTY, WISCONSIN.

MAY 2, 1963

Lloyd L Jensen
COUNTY SURVEYOR