


4162

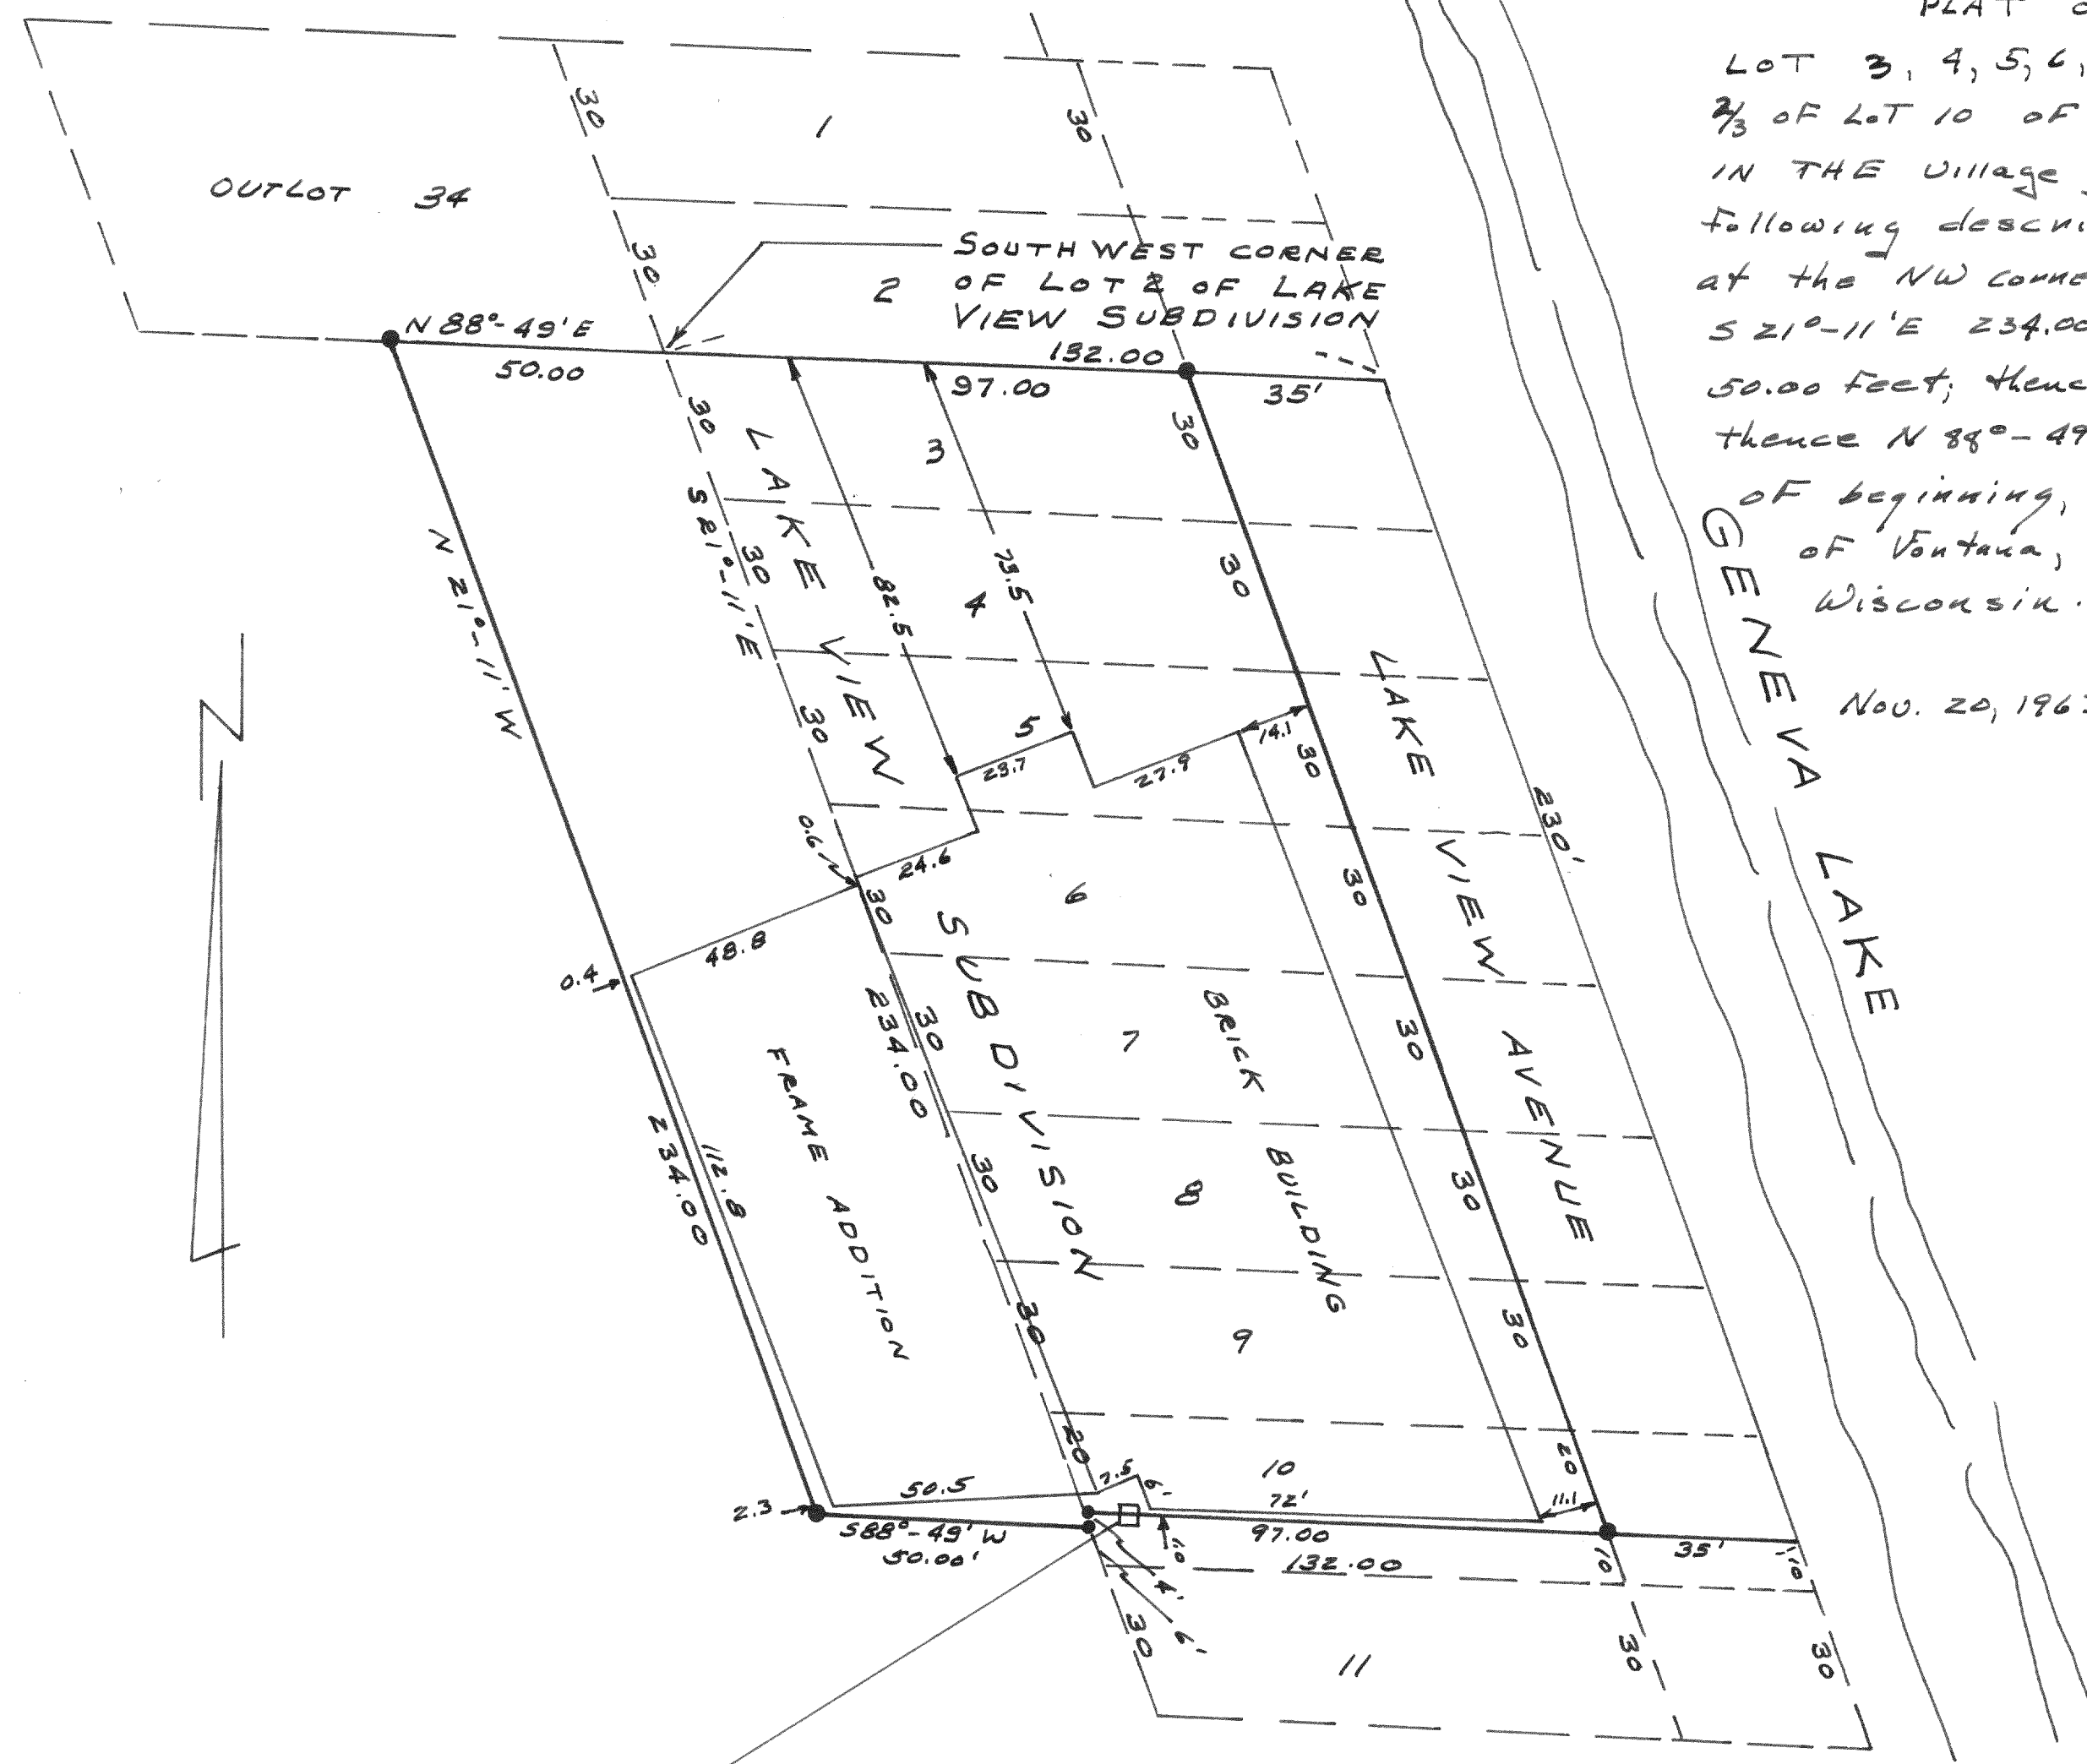

PLAT OF SURVEY OF
 LOT 3, 4, 5, 6, 7, 8, 9 AND THE NORTH
 $\frac{2}{3}$ OF LOT 10 OF LAKEVIEW SUBDIVISION
 IN THE VILLAGE OF Fontana, PLUS the
 following described parcel; beginning
 at the NW corner of lot 3, thence
 S $21^{\circ}-11'E$ 234.00 Feet; thence S $88^{\circ}-49'W$
 50.00 Feet; thence N $21^{\circ}-11'W$ 234.00 Feet;
 thence N $88^{\circ}-49'W$ 50.00' to the place
 of beginning, all being in the Village
 of Fontana, Walworth County,
 Wisconsin.

Nov. 20, 1963

Lloyd L. Jensen
 COUNTY SURVEYOR