


4180

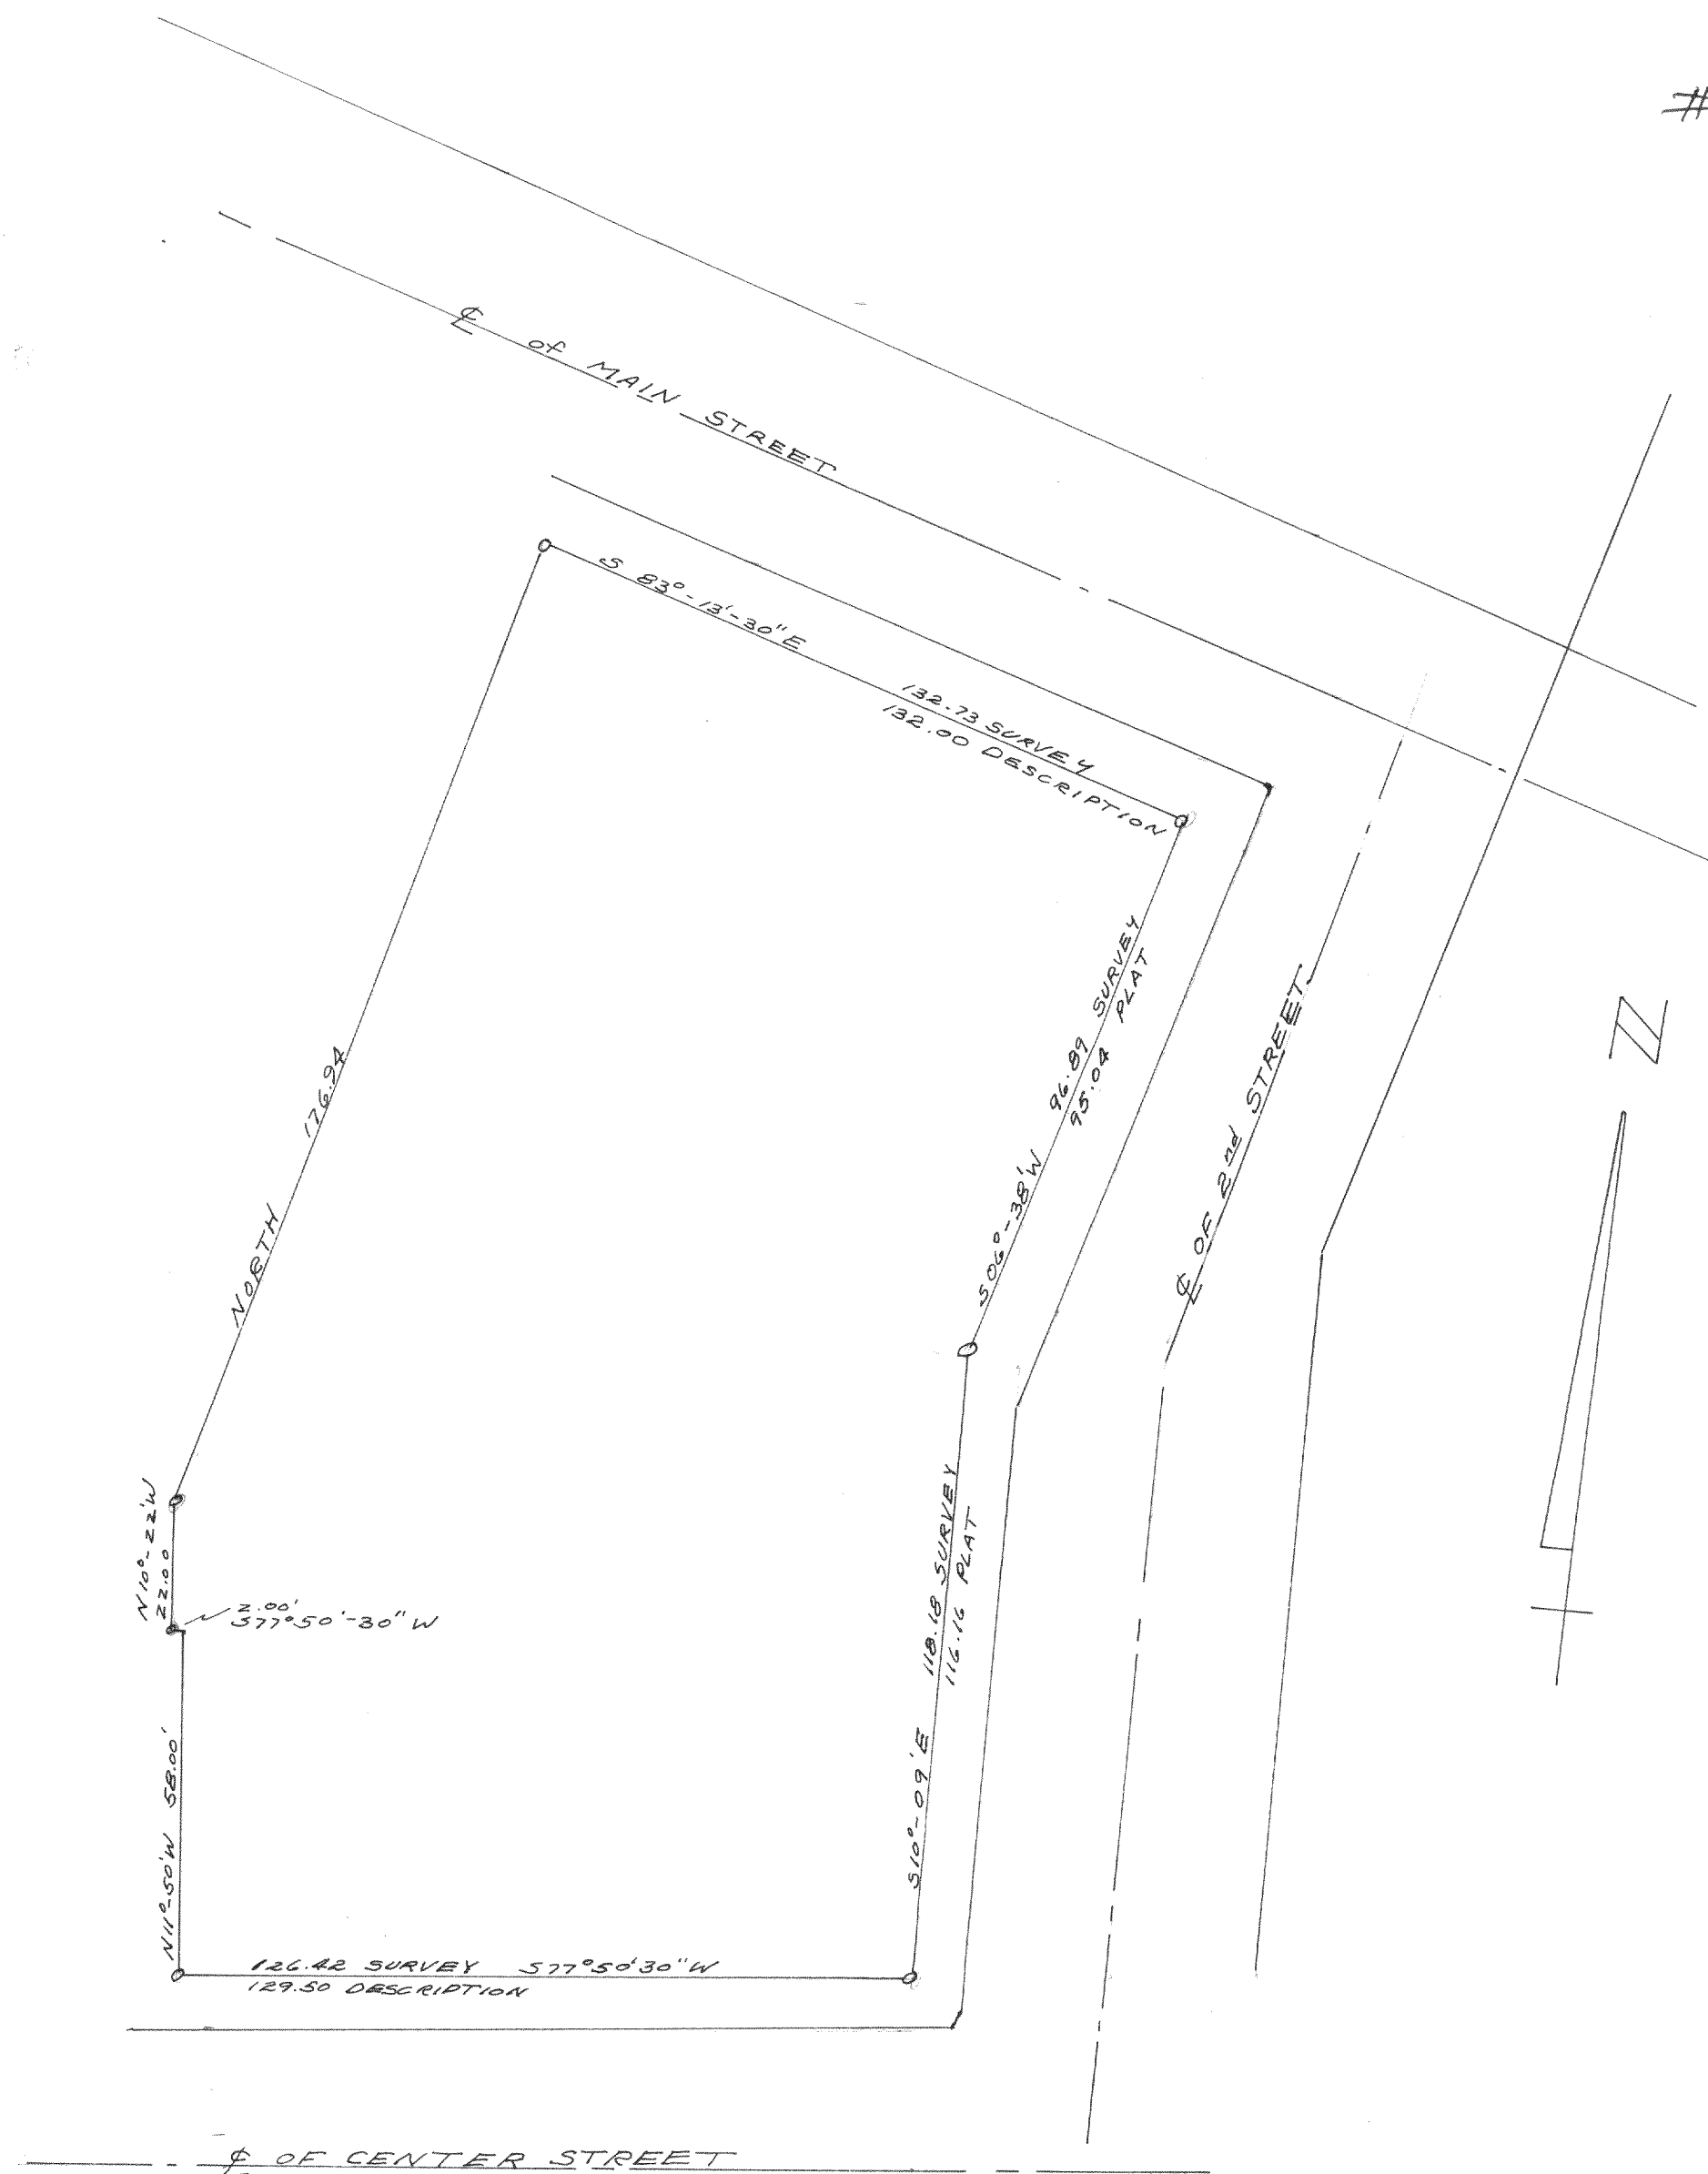

PLAT OF SURVEY OF
 PART OF LOTS 1, 2, 7, 8 BLOCK 7 OF
 THE ORIGINAL TOWN PLAT
 CITY OF WHITEWATER, WALWORTH
 COUNTY, WISCONSIN.

SEPT. 1962

Lloyd L. Jensen
 COUNTY SURVEYOR